


REVISIONS
REV DESCRIPTION DATE BY


NOTE 1: Do not scale drawing. This drawing is for general truck configuration only. All items and dimensions shown are approximate and may vary with final production. The drawing may not provide illustration for all items in the specification. In all situations where the drawing may contradict the specifications, the specifications shall prevail. This drawing and all data herein are provided as confidential materials and shall not be reproduced without written consent of the manufacturer.

NOTE 2: Chassis frame height will change due to axide characteristics, loading and the dimensions which will effect the overall height dimension shown. Any overall height restrictions should take this into consideration and allow approximately 2-3 inches of tolerance.

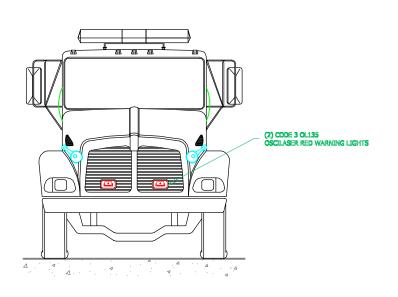

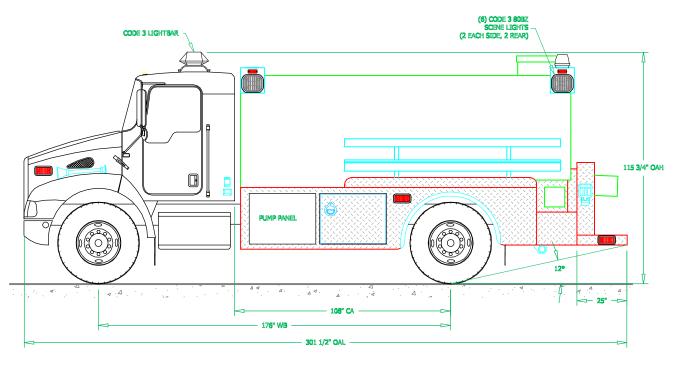

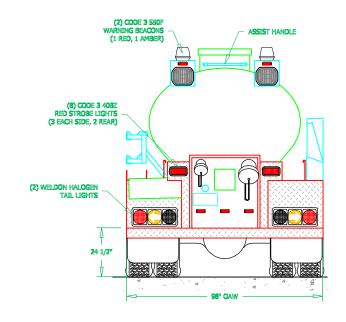

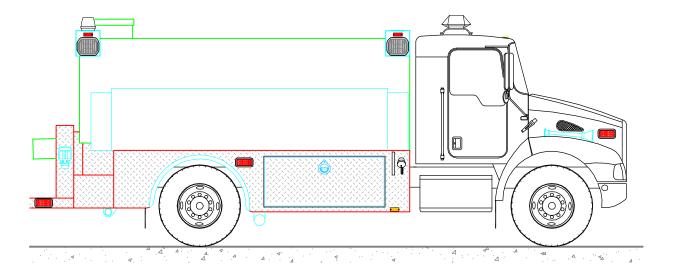



SVI FIRE & RESCUE TRUCKS
1511 E. 11th STREET, LOVELAND, CO 80537 PHONE 970-667-5146, FAX 970-667-3343

## JOHNSTOWN FIRE PROTECTION DISTRICT

BODY SIZE: 2000 GAL POLY TANK	UNIT TYPE: ELLIPTICAL TANKER
BODY MATERIAL: 3/16" ALUMINUM	TRUCK NO: 574
CHASSIS TYPE: KENWORTH	WHEELBASE: SEE DWG
T.300	CAB TO AXLE: SEE DWG
2 DOOR	OVERALL LENGTH (OAL): SEE DWG
2 55511	OVERALL WIDTH (OAW): SEE DWG
4 X 2	OVERALL HEIGHT (OAH): SEE DWG
DRAWN BY: NMT DATE: May 23, 2006	SCALE: 1/4" = 1' - 0"
DRAWING NO: JOHNSTOWN_CO_TK_574_ASBUILT.dwg SHEET 1 OF 2	

 REVISIONS

 REV
 DESCRIPTION
 DATE
 BY

NOTE 1: Do not scale drawing. This drawing is for general truck configuration only. All items and dimensions shown are approximate and may vary with final production. The drawing may not provide illustration for all items in the specification. In all situations where the drawing may contradict the specifications, the specifications shall prevail. This drawing and all data herein are provided as confidential materials and shall not be reproduced without written consent of the manufacturer.

