
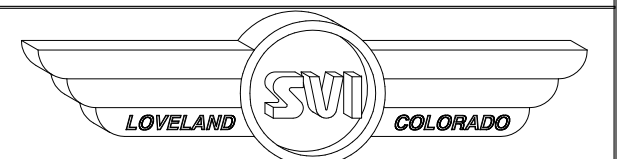
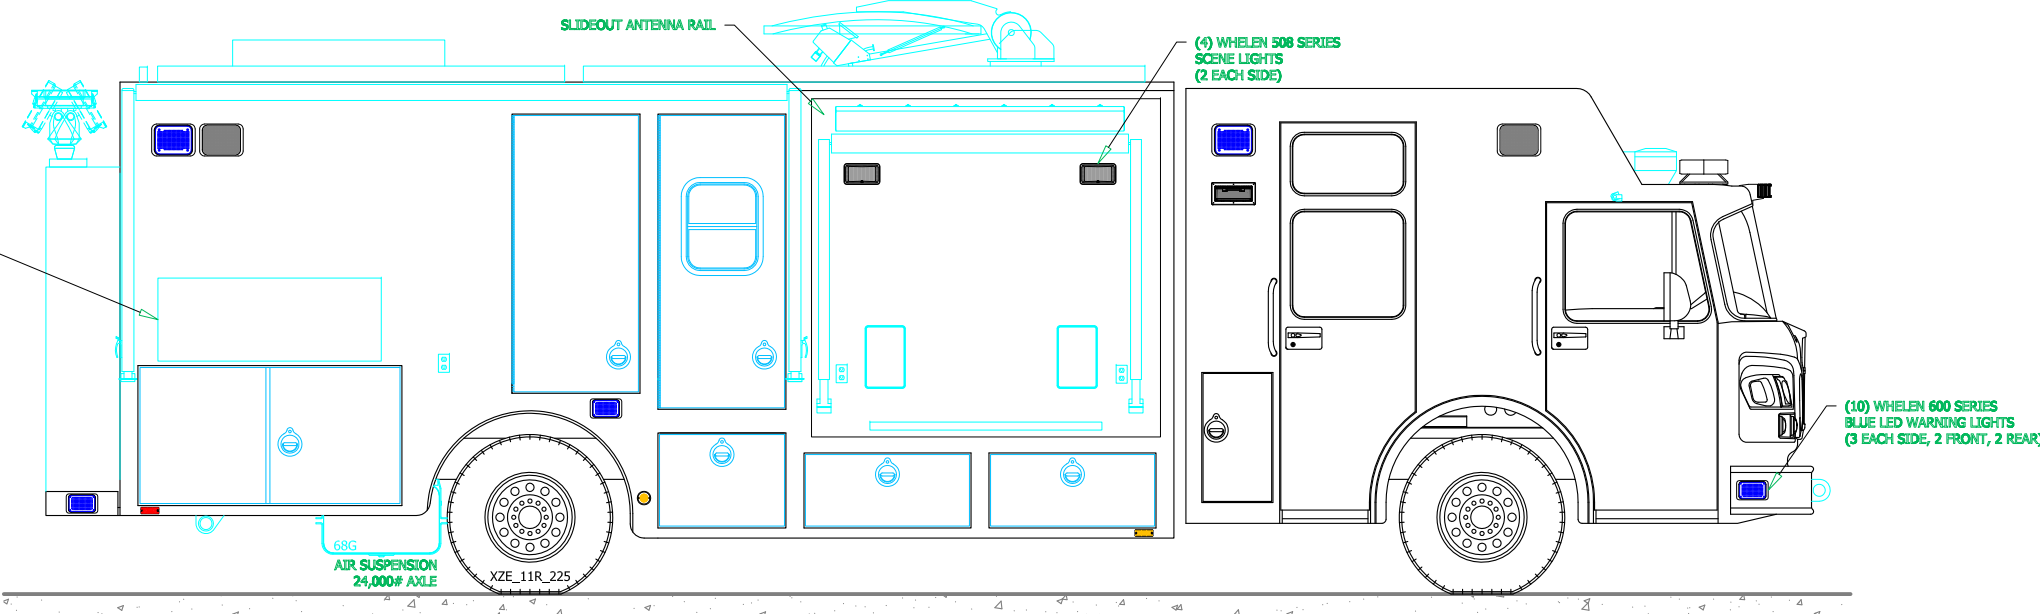
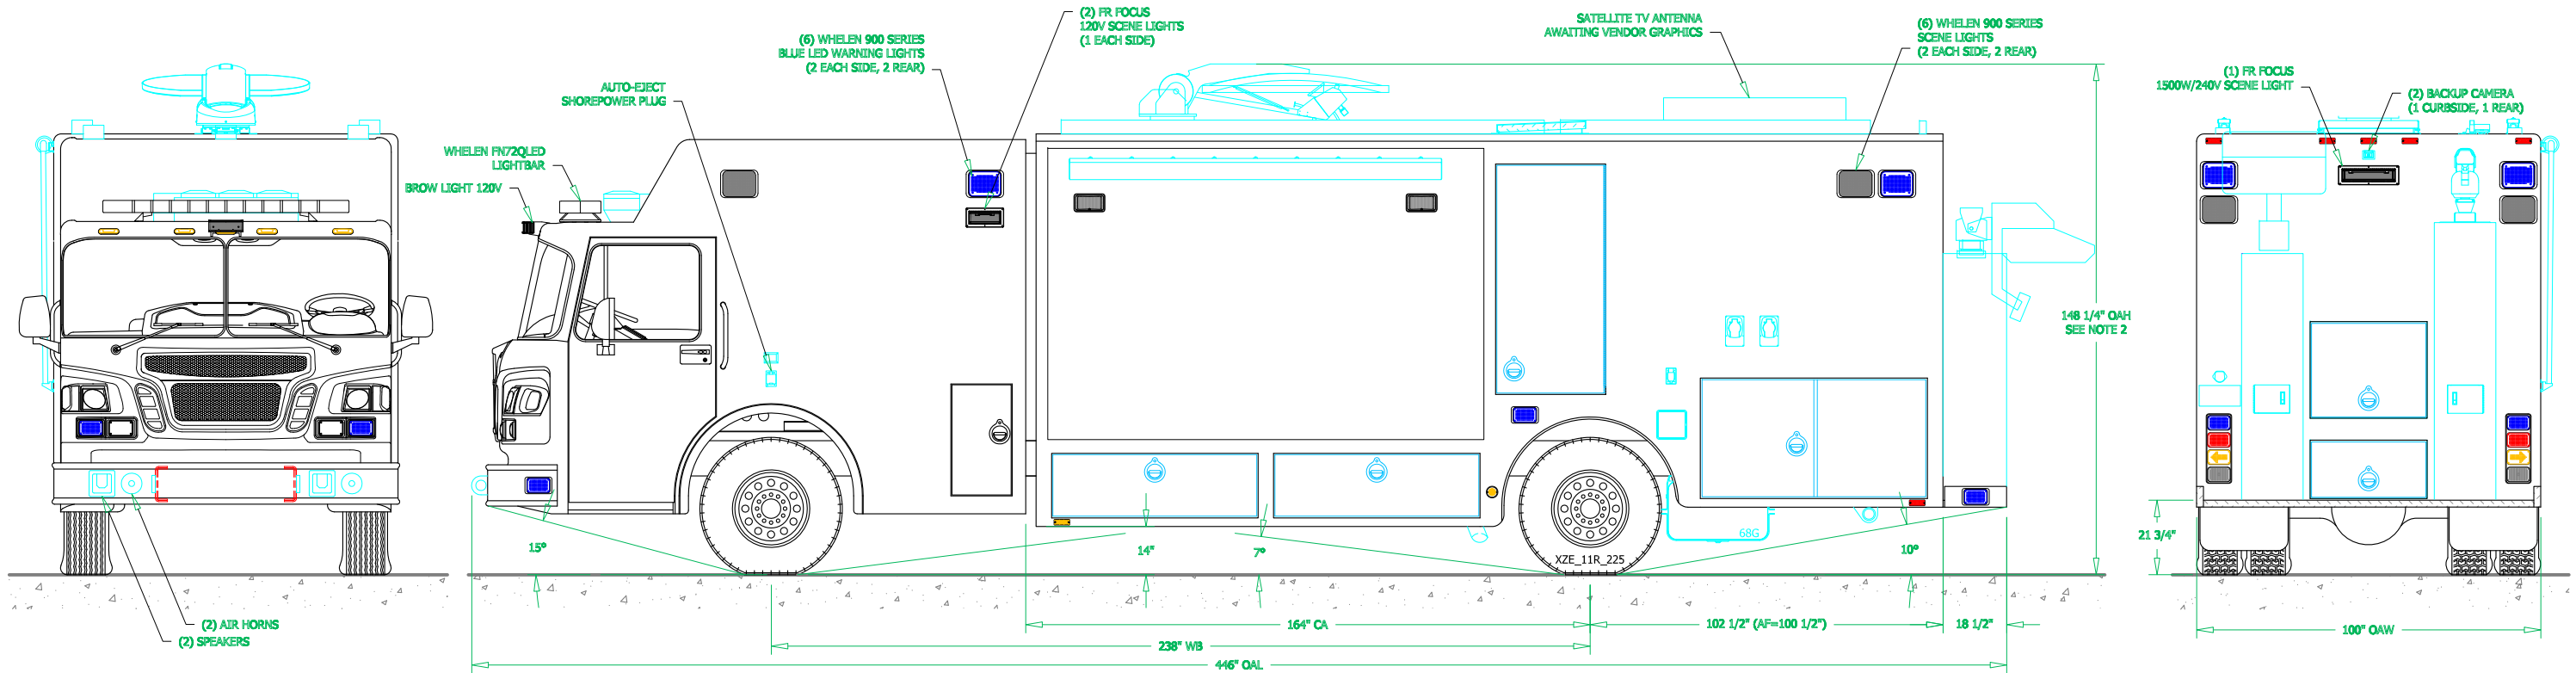


PRELIMINARY DRAWING - FOR LAYOUT PURPOSES ONLY

REVISIONS			
REV	DESCRIPTION	DATE	BY
A	UPDATES THROUGH CHANGE ORDER #2	11/27/06	NMT
B	UPDATES DURING TECH MEETING, PENDING CHANGE ORDER	1/16/07	NMT

NOTE 1: Do not scale drawing. This drawing is for general truck configuration only. All items and dimensions shown are approximate and may vary with final production. The drawing may not provide illustration for all items in the specification. In all situations where the drawing may contradict the specifications, the specifications shall prevail. This drawing and all data herein are provided as confidential materials and shall not be reproduced without written consent of the manufacturer.

NOTE 2: Chassis frame height will change due to axle characteristics, loading and the dimensions which will effect the overall height dimension shown. Any overall height restrictions should take this into consideration and allow approximately 2-3 inches of tolerance.

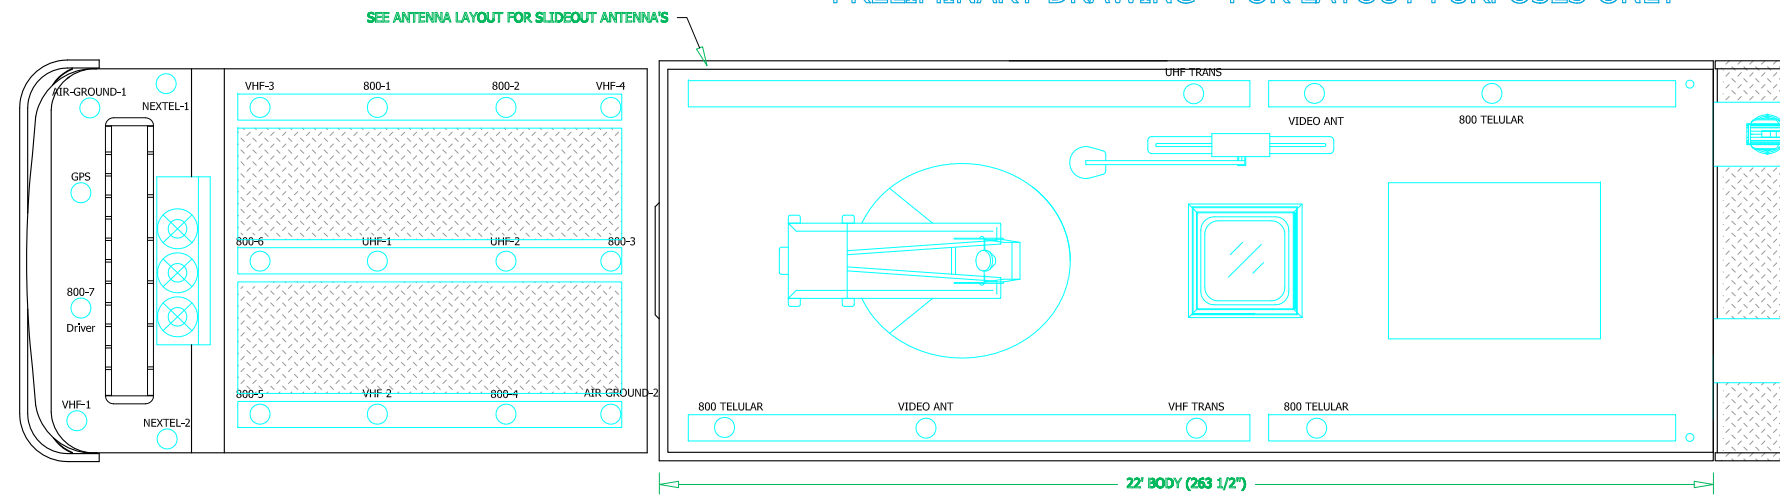

SVI FIRE & RESCUE TRUCKS
1511 E. 11th STREET, LOVELAND, CO 80537 PHONE 970-667-5146, FAX 970-667-3343





**MAUI POLICE DEPARTMENT
COMMAND UNIT**


BODY SIZE: 22' BODY	UNIT TYPE: COMMAND UNIT
BODY MATERIAL: 3/16" ALUMINUM	TRUCK NO: 603
CHASSIS TYPE: SPARTAN DIAMOND EVOLUTION ELFD 3 DOOR 24" RAISED ROOF	WHEELBASE: 238" CAB TO AXLE: 164" OVERALL LENGTH (OAL): 446" OVERALL WIDTH (OAW): 100" OVERALL HEIGHT (OAH): 148 1/4"

PRELIMINARY DRAWING - FOR LAYOUT PURPOSES ONLY

REVISIONS			
REV	DESCRIPTION	DATE	BY
A	UPDATES THROUGH CHANGE ORDER #2	11/27/06	NMT
B	UPDATES DURING TECH MEETING, PENDING CHANGE ORDER	1/16/07	NMT

NOTE 1: Do not scale drawing. This drawing is for general truck configuration only. All items and dimensions shown are approximate and may vary with final production. The drawing may not provide illustration for all items in the specification. In all situations where the drawing may contradict the specifications, the specifications shall prevail. This drawing and all data herein are provided as confidential materials and shall not be reproduced without written consent of the manufacturer.

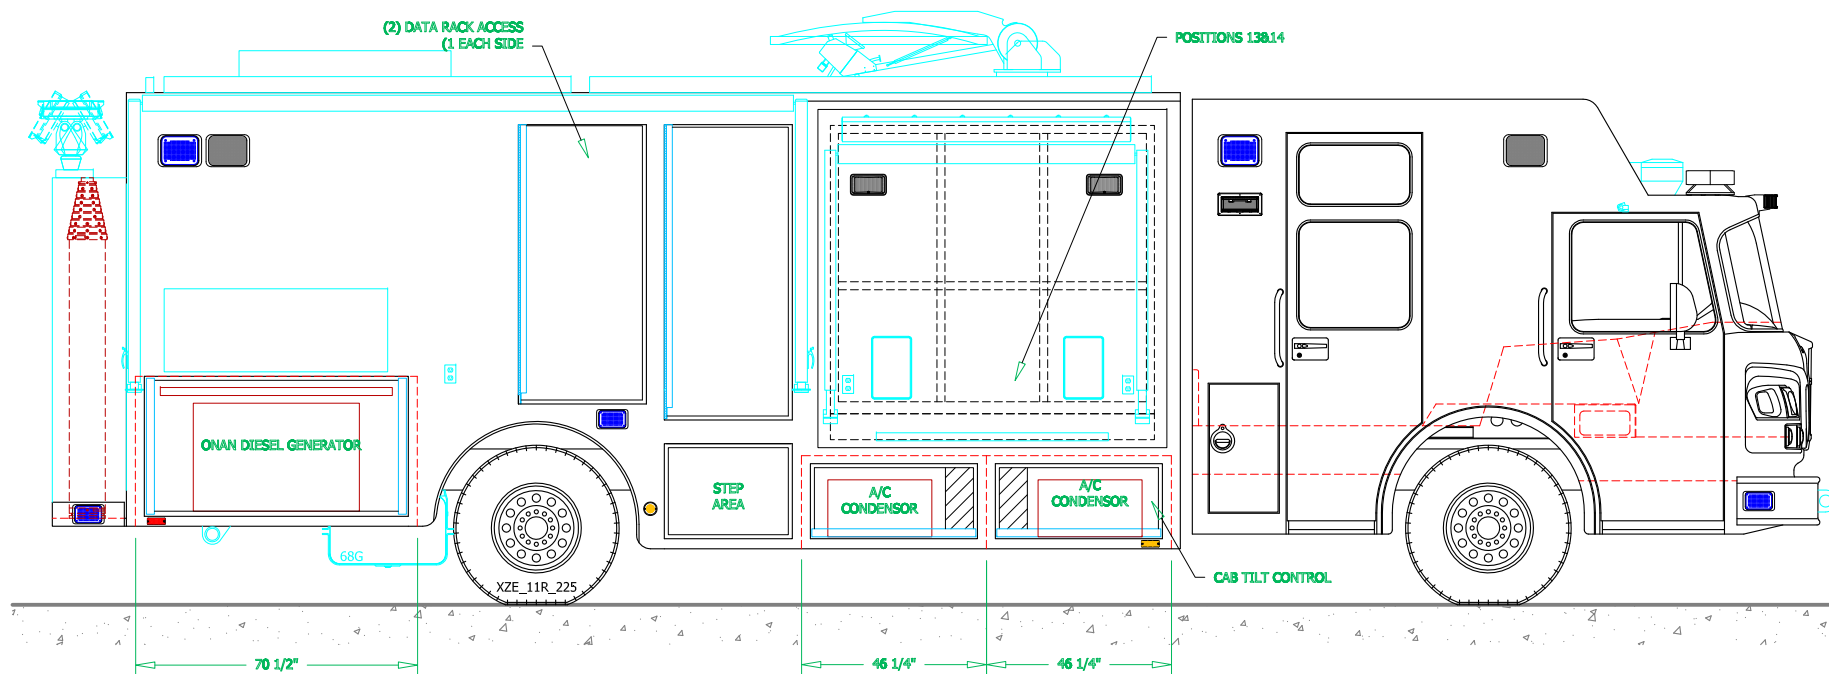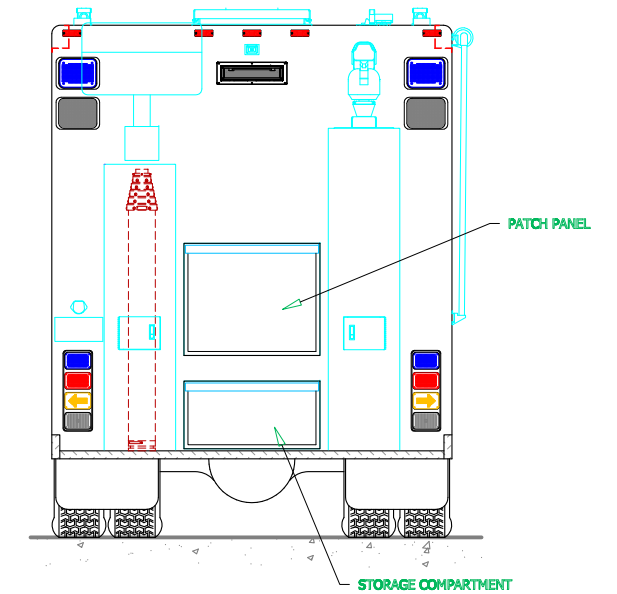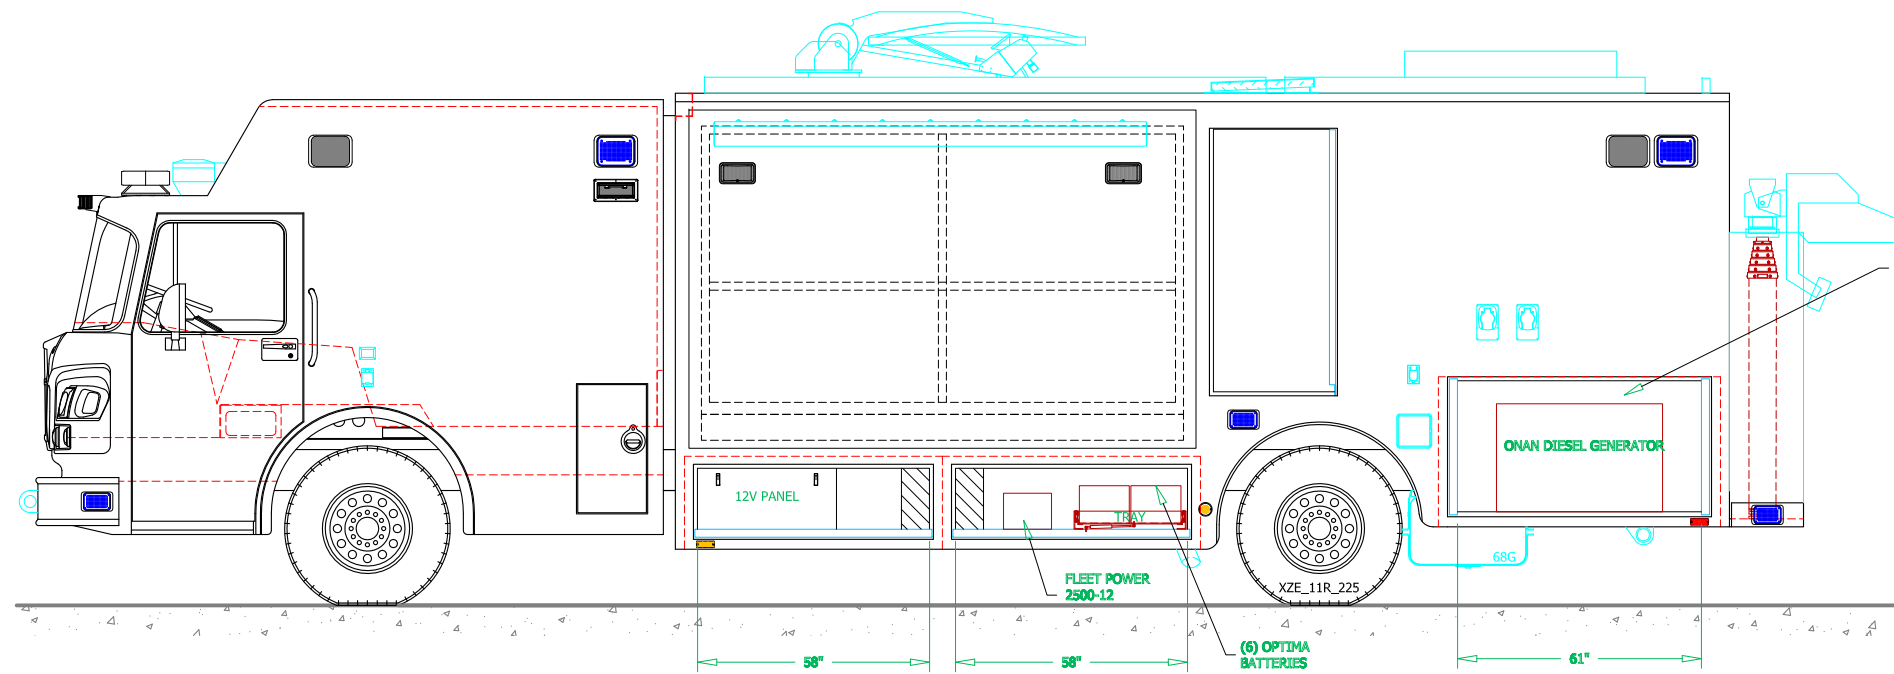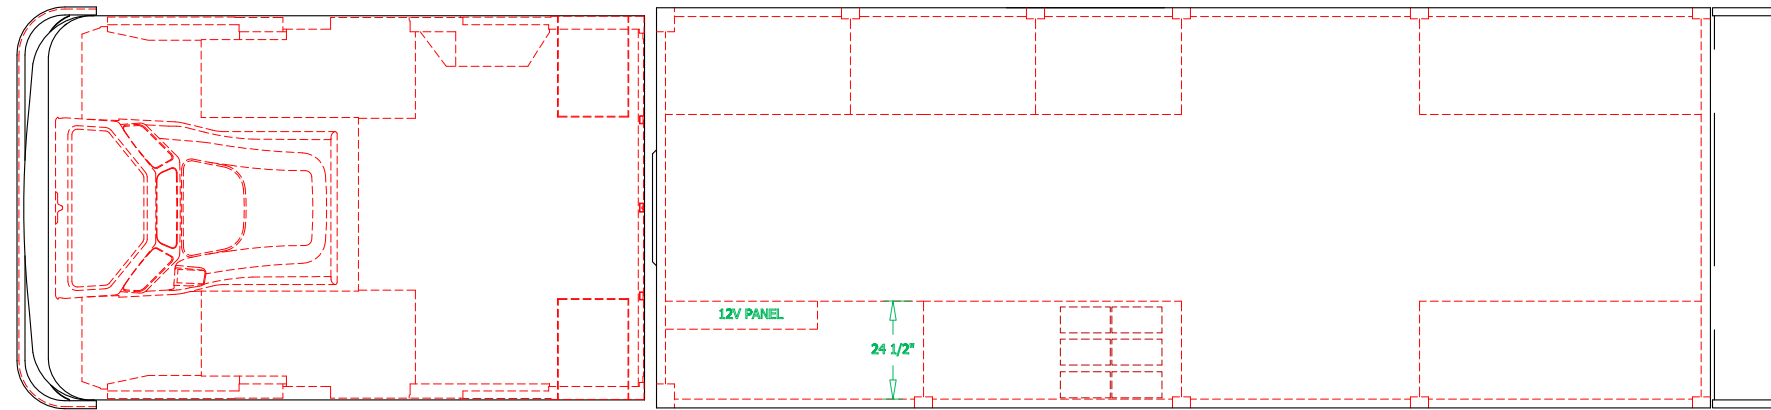



LOVELAND SVI COLORADO

SVI FIRE & RESCUE TRUCKS
1511 E. 11th STREET, LOVELAND, CO 80537 PHONE 970-667-5146, FAX 970-667-3343

**MAUI POLICE DEPARTMENT
COMMAND UNIT**


DRAWN BY: NMT	DATE: January 16, 2007	SCALE: 1/4" = 1' - 0"	
DRAWING NO: MAUI_HI_CM_22_603_AsBuilt.dwg			SHEET 2 OF 5

PRELIMINARY DRAWING - FOR LAYOUT PURPOSES ONLY


REVISIONS			
REV	DESCRIPTION	DATE	BY
A	UPDATES THROUGH CHANGE ORDER #2	11/27/06	NMT
B	UPDATES DURING TECH MEETING, PENDING CHANGE ORDER	1/16/07	NMT

NOTE 1: Do not scale drawing. This drawing is for general truck configuration only. All items and dimensions shown are approximate and may vary with final production. The drawing may not provide illustration for all items in the specification. In all situations where the drawing may contradict the specifications, the specifications shall prevail. This drawing and all data herein are provided as confidential materials and shall not be reproduced without written consent of the manufacturer.


PLAN VIEW
CROSS-SECTION

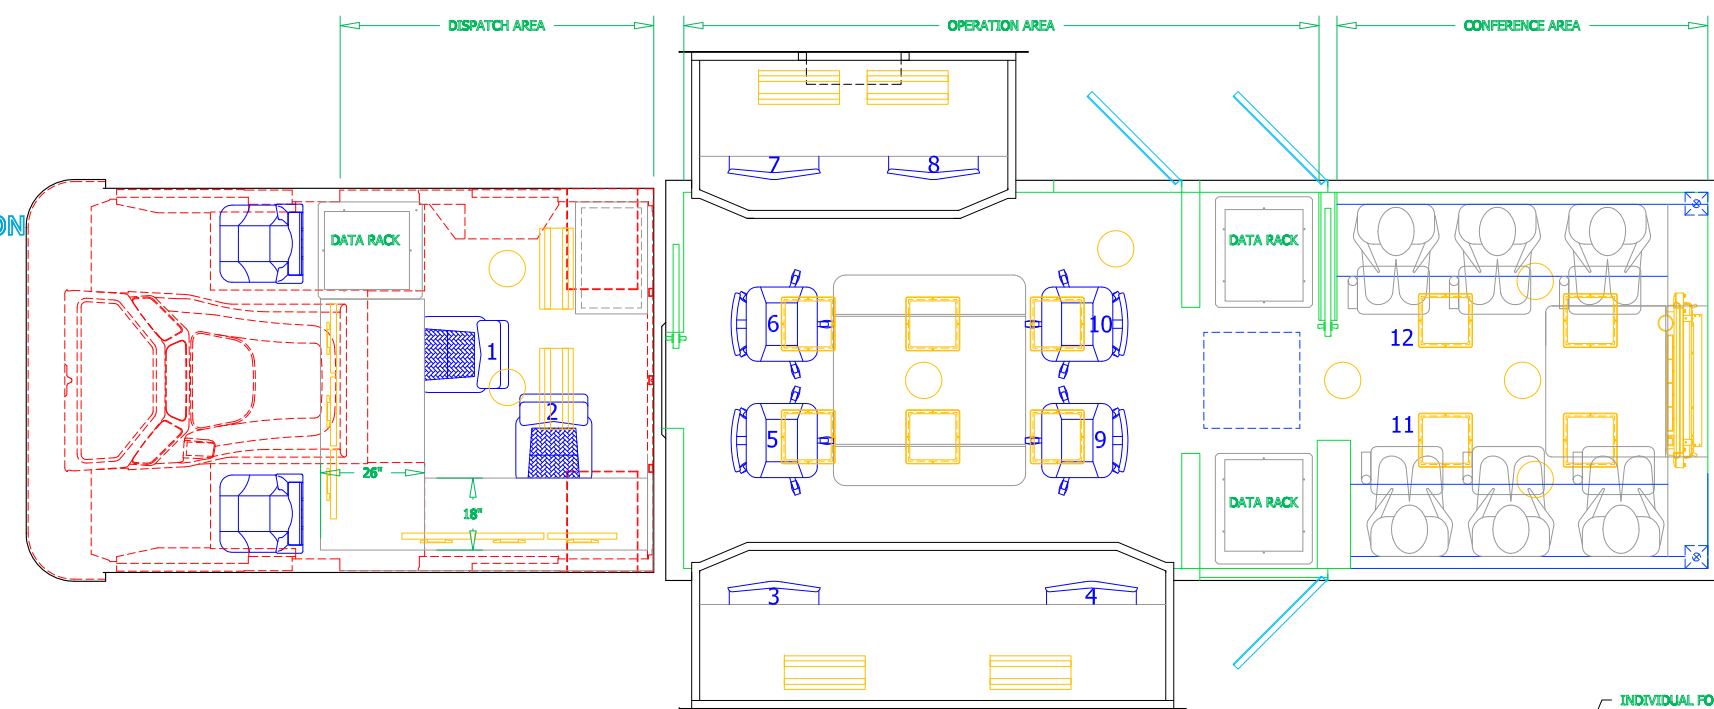


CONFERENCE AREA
CROSS-SECTION

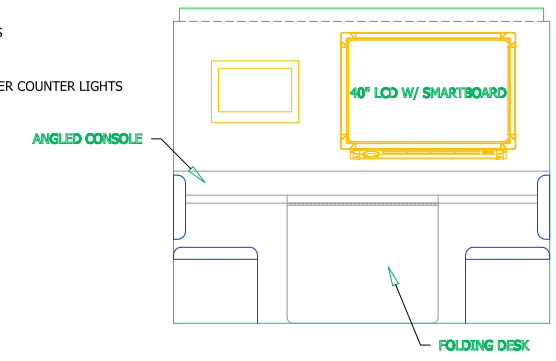


CURBSIDE INTERIOR
CROSS-SECTION

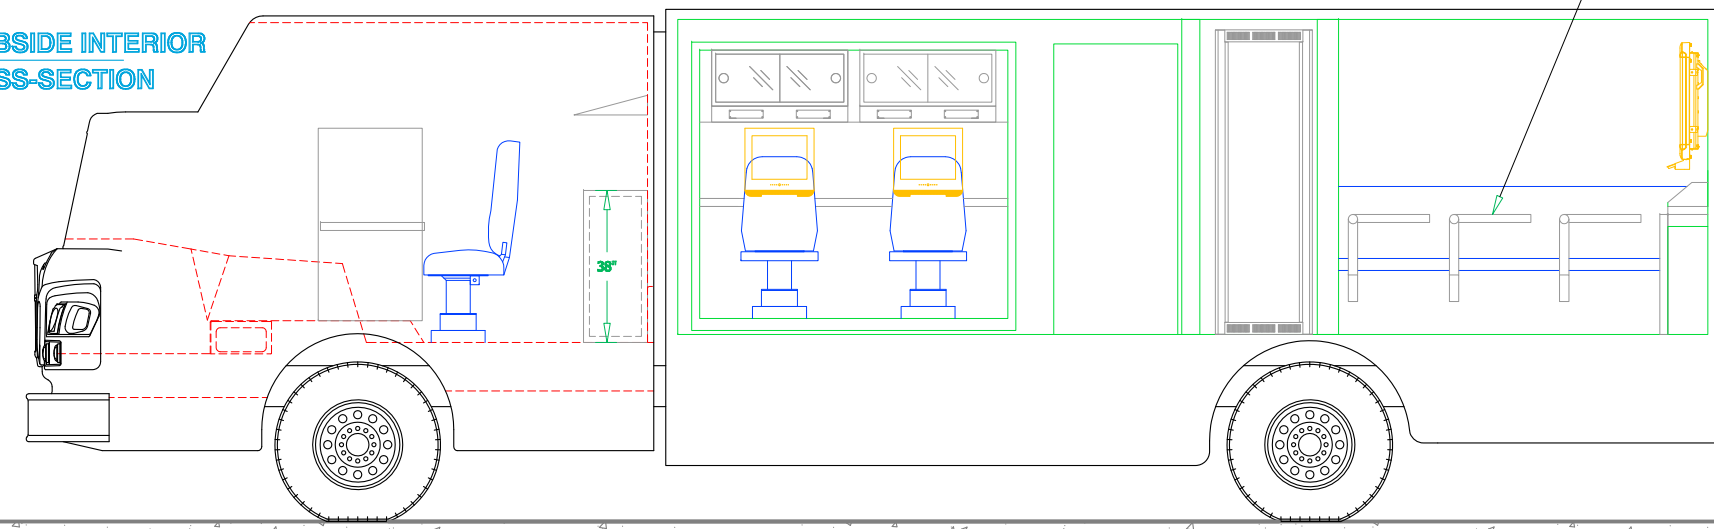


COMMAND AREA
CROSS-SECTION

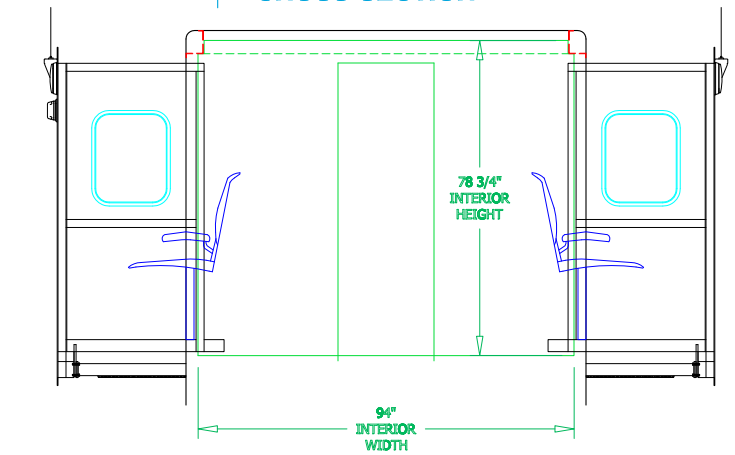

STREETSIDE INTERIOR
CROSS-SECTION

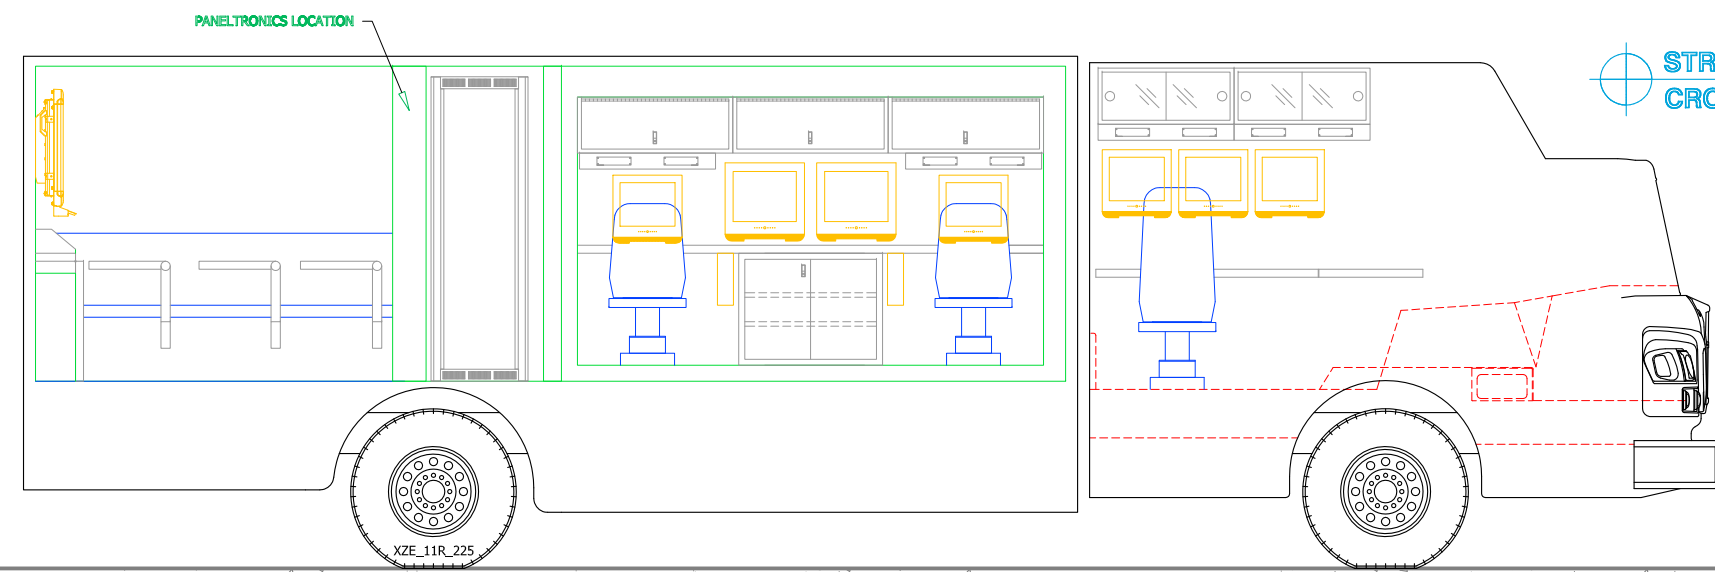

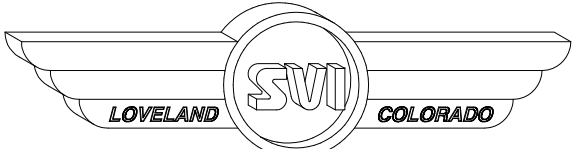

LOVELAND SVI COLORADO

SVI FIRE & RESCUE TRUCKS
1511 E. 11th STREET, LOVELAND, CO 80537 PHONE 970-667-5146, FAX 970-667-3343

**MAUI POLICE DEPARTMENT
COMMAND UNIT**

DRAWN BY: NMT	DATE: January 16, 2007	SCALE: 1/4" = 1' - 0"
DRAWING NO: MAUI_HI_CM_22_603_AsBuilt.dwg	SHEET 3 OF 5	