
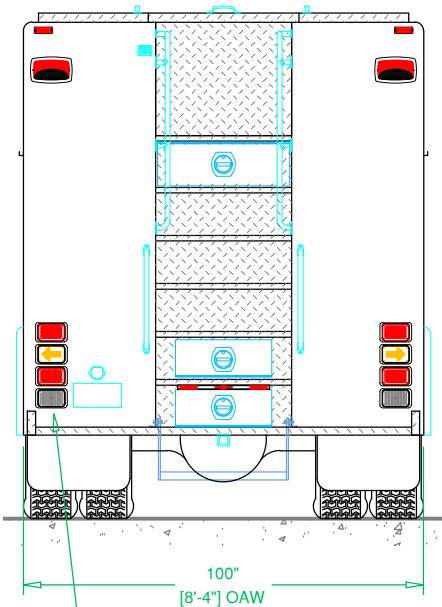
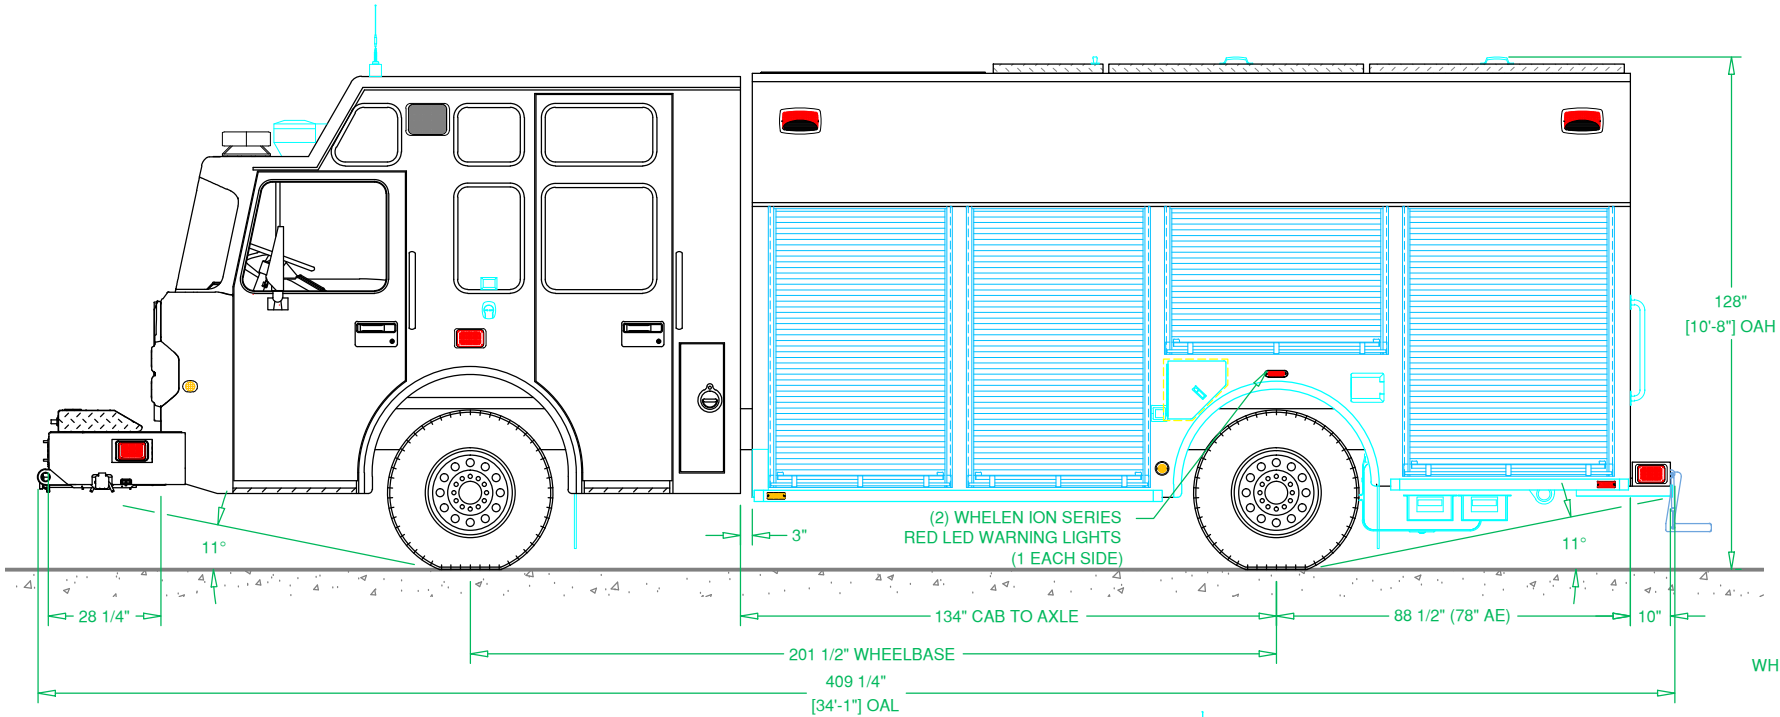
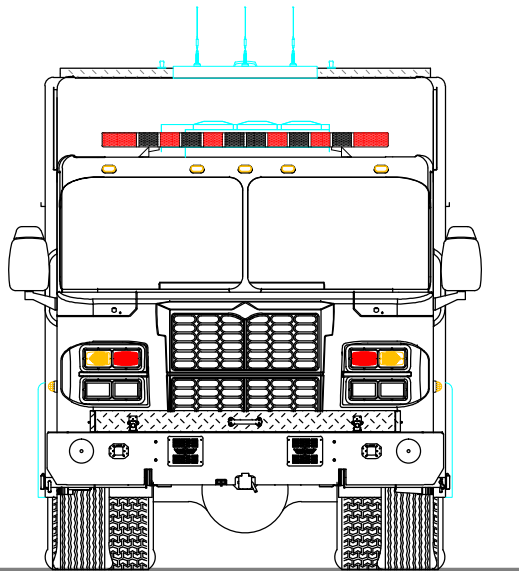


PRELIMINARY DRAWING - FOR LAYOUT PURPOSES ONLY

REVISIONS			
REV	DESCRIPTION	DATE	BY


NOTE 1: Do not scale drawing. This drawing is for general truck configuration only. All items and dimensions shown are approximate and may vary with final production. The drawing may not provide illustration for all items in the specification. In all situations where the drawing may contradict the specifications, the specifications shall prevail. This drawing and all data herein are provided as confidential materials and shall not be reproduced without written consent of the manufacturer.

NOTE 2: Chassis frame height will change due to axle characteristics, loading and tire dimensions which will effect the overall height dimension shown. Any overall height restrictions should take this into consideration and allow approximately 2-3 inches of tolerance.

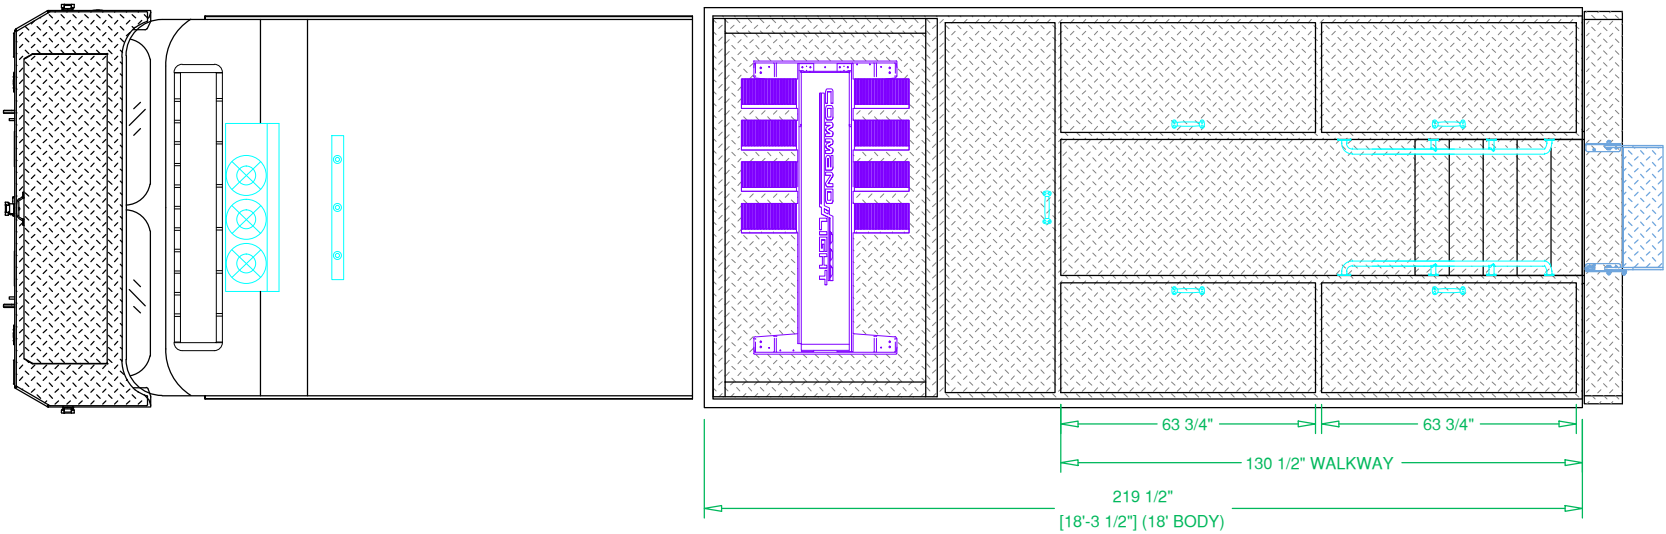

(6) WHELEN M9V2 SERIES
RED LED WARNING LIGHTS
(2 EACH SIDE, 2 REAR)

(10) WHELEN 600 SERIES
RED LED WARNING LIGHTS
(3 EACH SIDE, 2 FRONT, 2 REAR)

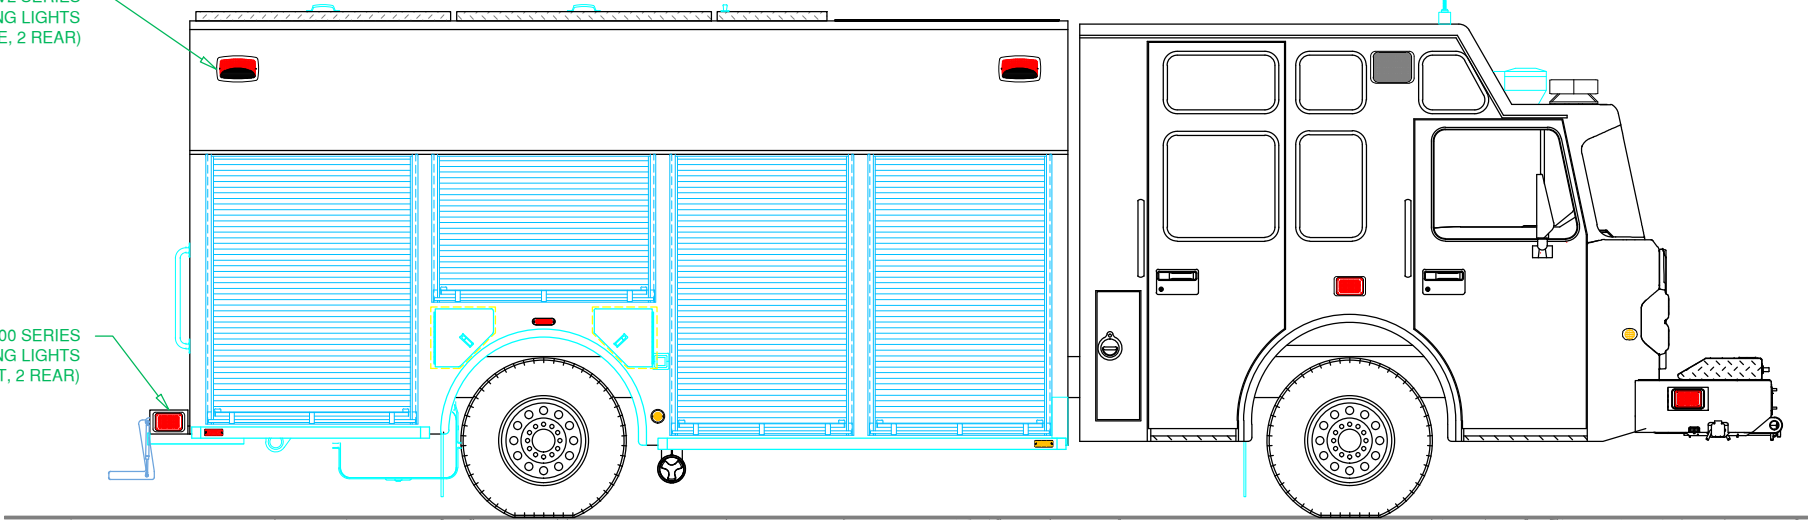

SVI FIRE & RESCUE TRUCKS
3842 REDMAN DRIVE, FORT COLLINS, CO 80524 PHONE 970-297-7100, FAX 970-297-7099

SVI EMERGENCY VEHICLES
2019 18' DEMO

BODY SIZE: 18' BODY	UNIT TYPE: HEAVY RESCUE
BODY MATERIAL: 3/16" ALUMINUM	TRUCK NO: SVI #1072
CHASSIS TYPE: SPARTAN	WHEELBASE: 201.5"
METRO STAR LFD	CAB TO AXLE: 134"
20" RR	OVERALL LENGTH (OAL): 34' 1"
FOUR DOOR	OVERALL WIDTH (OAW): 8' 4"
	OVERALL HEIGHT (OAH): 10' 8"

DRAWN BY: HJR	DATE: April 29, 2019	SCALE: 1/4" = 1'-0"
DRAWING NO: SVI_SP19Demo_HR_1072_AsBuilt		SHEET 1 OF 2

PRELIMINARY DRAWING - FOR LAYOUT PURPOSES ONLY

REVISIONS			
REV	DESCRIPTION	DATE	BY

NOTE 1: Do not scale drawing. This drawing is for general truck configuration only. All items and dimensions shown are approximate and may vary with final production. The drawing may not provide illustration for all items in the specification. In all situations where the drawing may contradict the specifications, the specifications shall prevail. This drawing and all data herein are provided as confidential materials and shall not be reproduced without written consent of the manufacturer.

