


AS BUILT DRAWING

REVISIONS			
REV	DESCRIPTION	DATE	BY

NOTE 1: Do not scale drawing. This drawing is for general truck configuration only. All items and dimensions shown are approximate and may vary with final production. The drawing may not provide illustration for all items in the specification. In all situations where the drawing may contradict the specifications, the specifications shall prevail. This drawing and all data herein are provided as confidential materials and shall not be reproduced without written consent of the manufacturer.

NOTE 2: Chassis frame height will change due to axle characteristics, loading and tire dimensions which will effect the overall height dimension shown. Any overall height restrictions should take this into consideration and allow approximately 2-3 inches of tolerance.

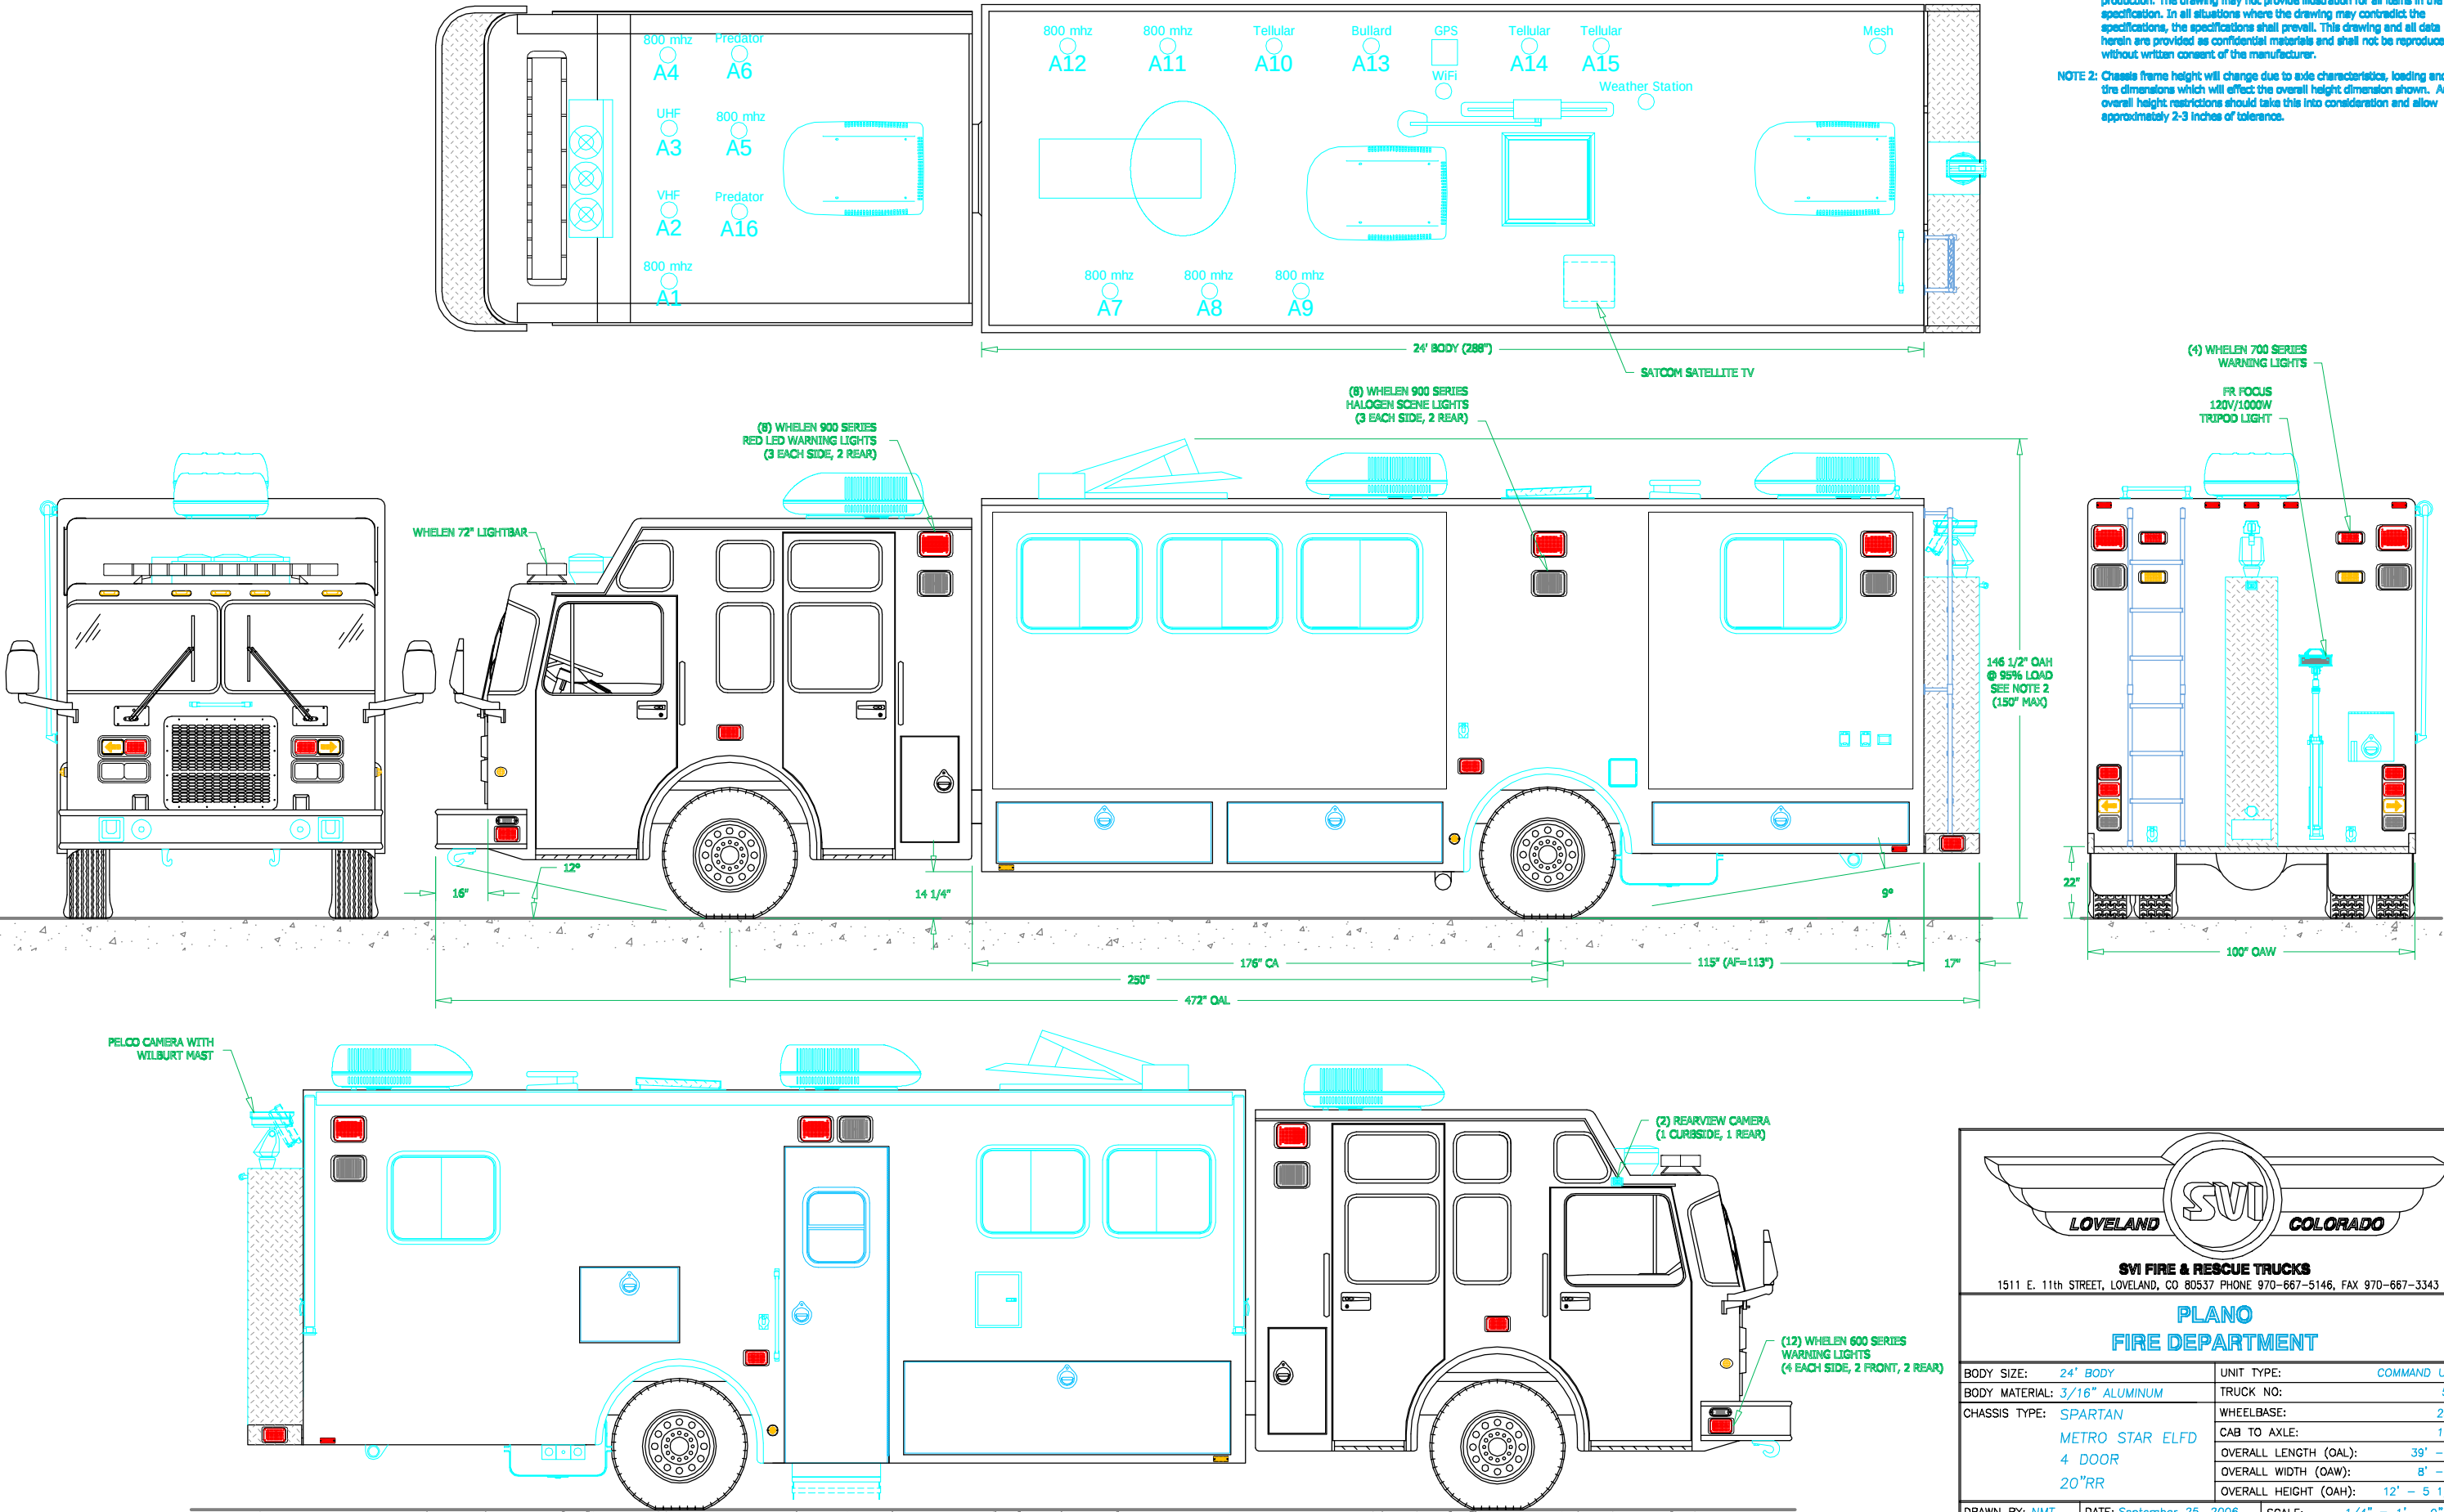



LOVELAND SVI COLORADO

SVI FIRE & RESCUE TRUCKS

1511 E. 11th STREET, LOVELAND, CO 80537 PHONE 970-667-5146, FAX 970-667-3343

PLANO

FIRE DEPARTMENT

BODY SIZE:	24' BODY	UNIT TYPE:	COMMAND UNIT
BODY MATERIAL:	3/16" ALUMINUM	TRUCK NO:	562
CHASSIS TYPE:	SPARTAN	WHEELBASE:	250"
	METRO STAR ELFD	CAB TO AXLE:	176"
	4 DOOR	OVERALL LENGTH (OAL):	39' - 4"
	20"RR	OVERALL WIDTH (OAW):	8' - 4"
		OVERALL HEIGHT (OAH):	12' - 5 1/4"

DRAWN BY: NMT

DRAWING NO: PLANO_TX_CM_24_562_ASBUILT.dwg

DATE: September 25, 2006





SHEET 1 OF 3

SCALE: 1/4" = 1' - 0"

AS BUILT DRAWING

REVISIONS			
REV	DESCRIPTION	DATE	BY

NOTE 1: Do not scale drawing. This drawing is for general truck configuration only. All items and dimensions shown are approximate and may vary with final production. The drawing may not provide illustration for all items in the specification. In all situations where the drawing may contradict the specifications, the specifications shall prevail. This drawing and all data herein are provided as confidential materials and shall not be reproduced without written consent of the manufacturer.

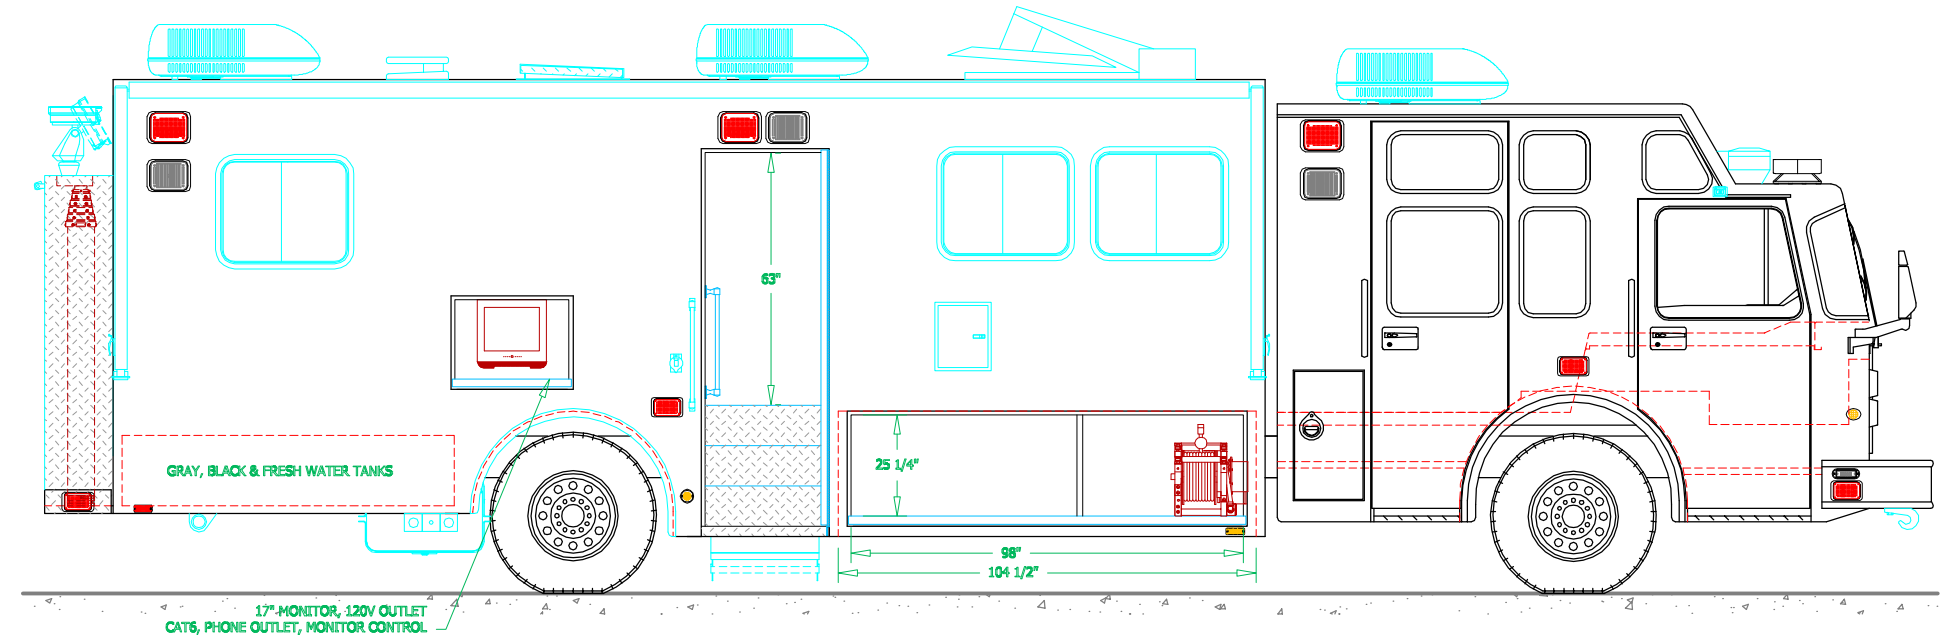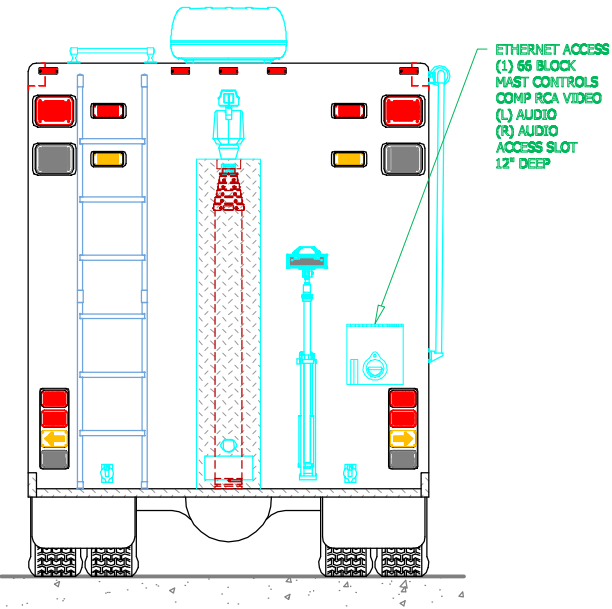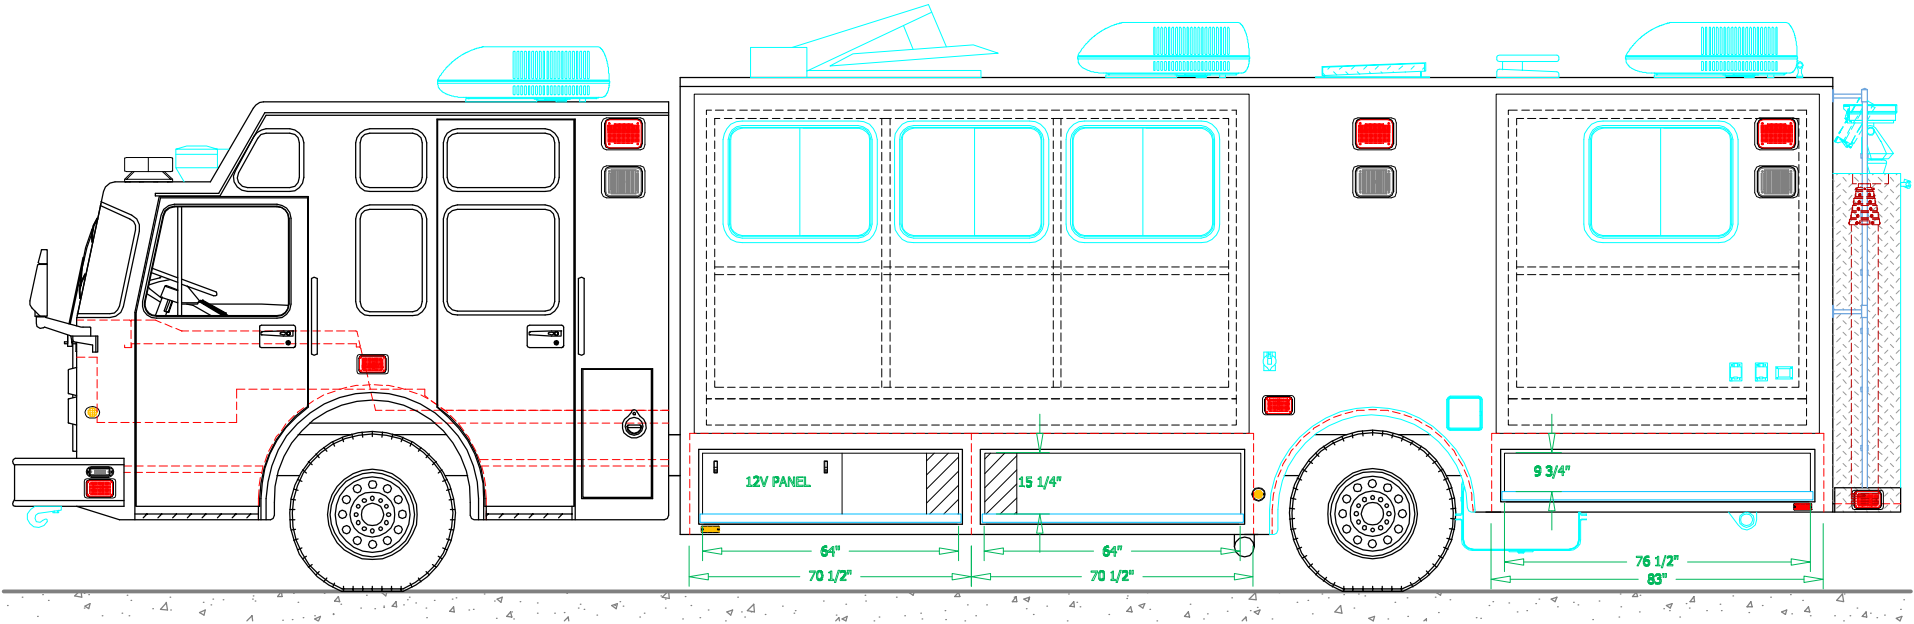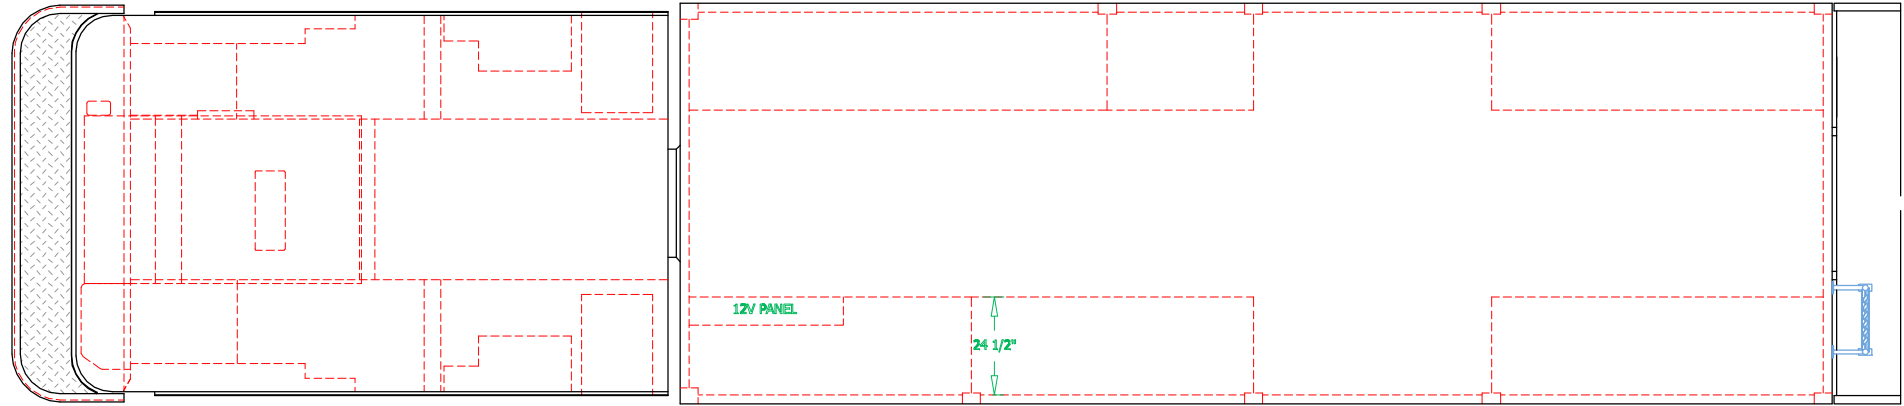



LOVELAND SVI COLORADO

SVI FIRE & RESCUE TRUCKS


1511 E. 11th STREET, LOVELAND, CO 80537 PHONE 970-667-5146, FAX 970-667-3343

PLANO


FIRE DEPARTMENT

DRAWN BY: NMT	DATE: September 25, 2006	SCALE: 1/4" = 1' - 0"
DRAWING NO: PLANO_TX_CM_24_562_AS BUILT.dwg	SHEET 2 OF 3	


PLAN VIEW
CROSS-SECTION

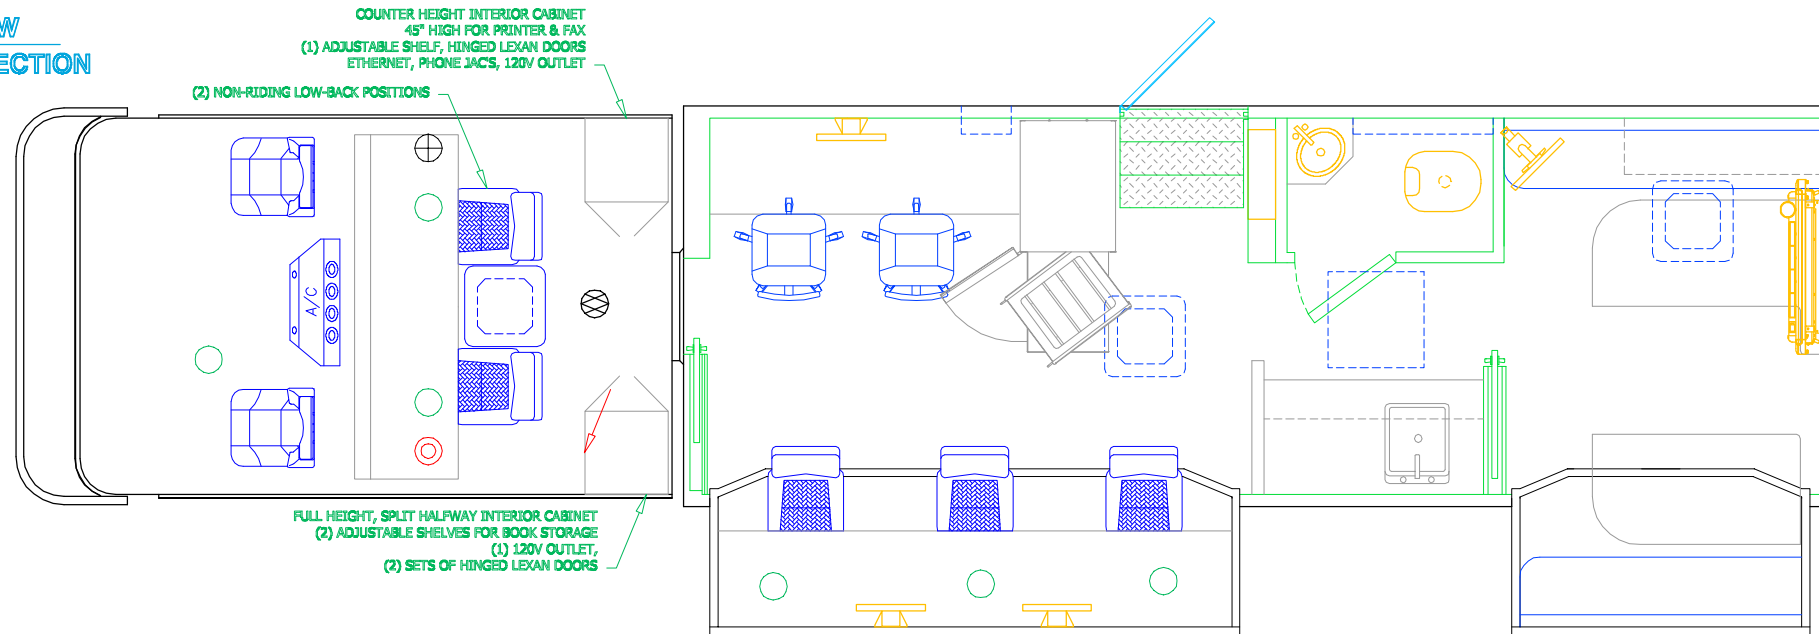


CURBSIDE INTERIOR
CROSS-SECTION

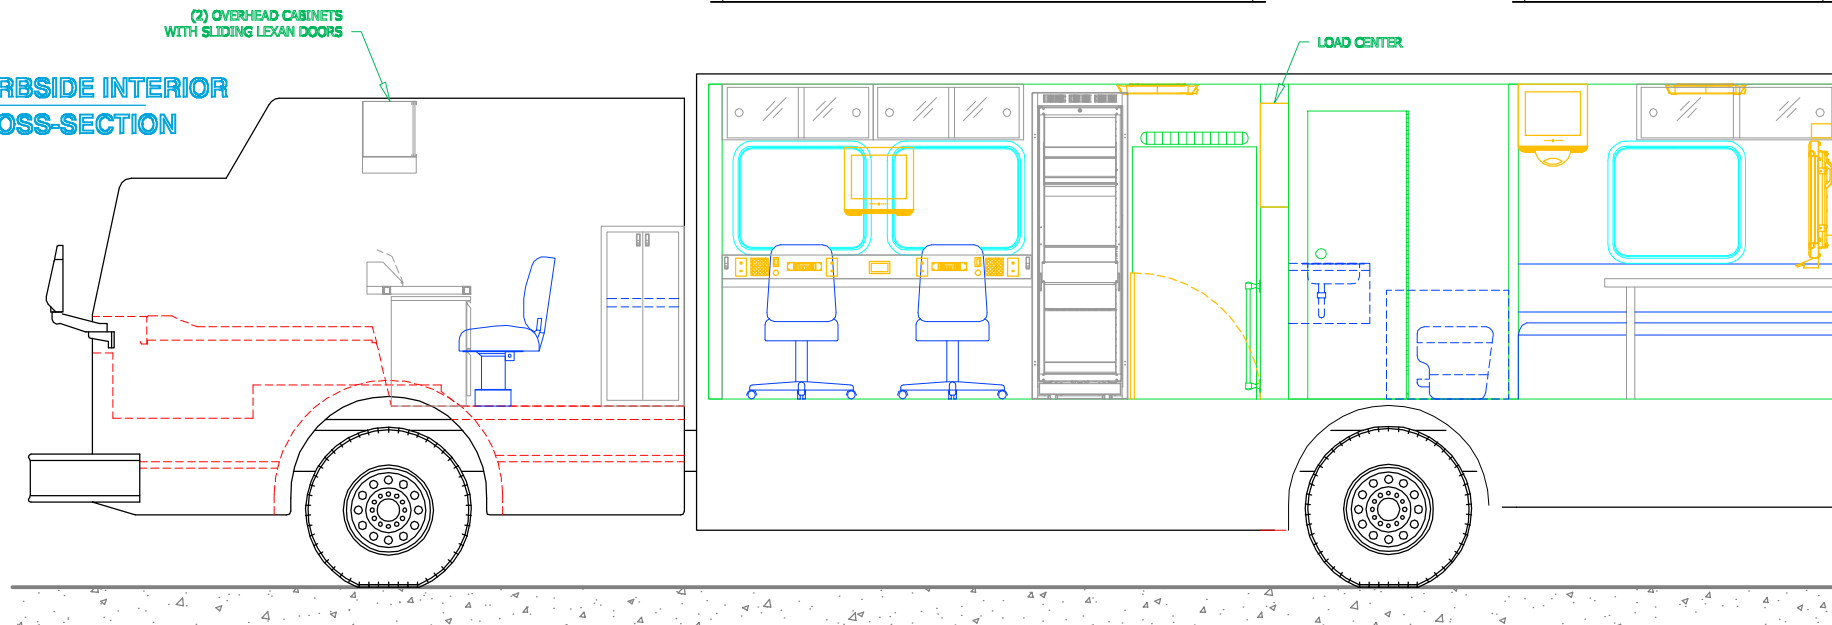


REAR VIEW
CROSS-SECTION

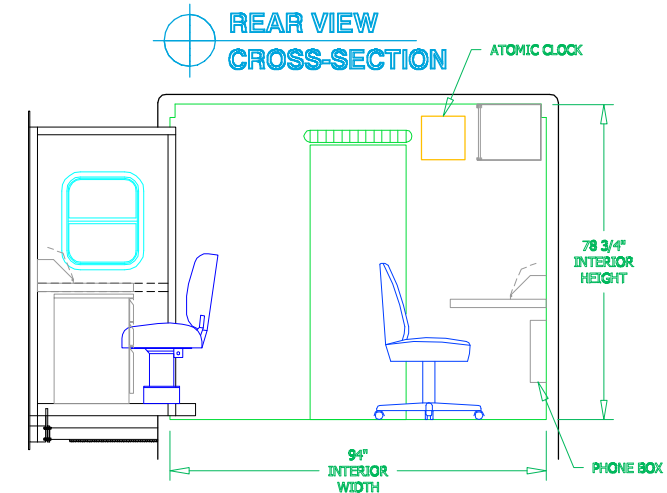

CAB COMMAND
CROSS-SECTION

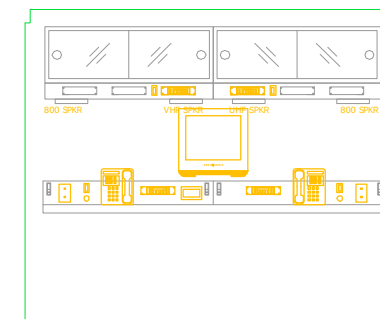


STREETSIDE INTERIOR
CROSS-SECTION

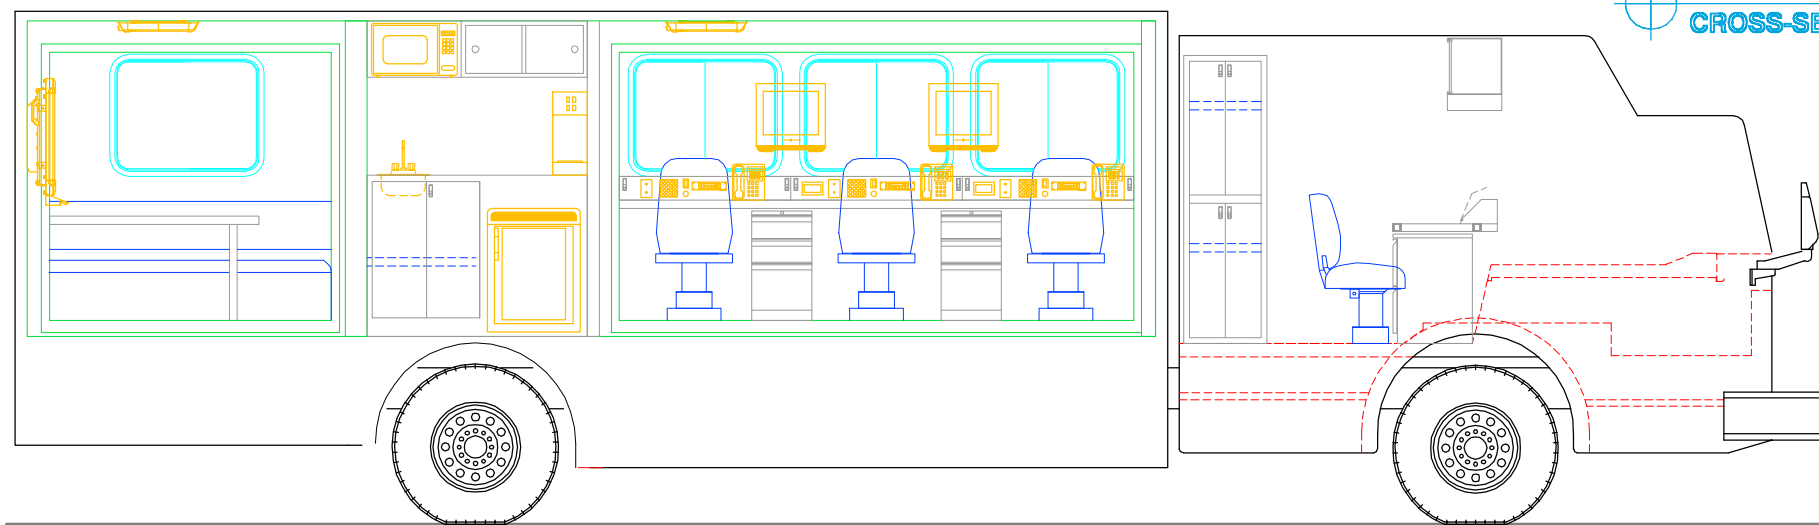

NOTE 1: Do not scale drawing. This drawing is for general truck configuration only. All items and dimensions shown are approximate and may vary with final production. The drawing may not provide illustration for all items in the specification. In all situations where the drawing may contradict the specifications, the specifications shall prevail. This drawing and all data herein are provided as confidential materials and shall not be reproduced without written consent of the manufacturer.

REVISIONS			
REV	DESCRIPTION	DATE	BY

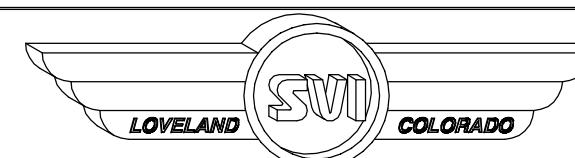

SVI FIRE & RESCUE TRUCKS
1511 E. 11th STREET, LOVELAND, CO 80537 PHONE 970-667-5146, FAX 970-667-3343

PLANO
FIRE DEPARTMENT

DRAWN BY: NMT	DATE: September 25, 2006	SCALE: 1/4" = 1' - 0"
DRAWING NO: PLANO_TX_CM_24_562_AS BUILT.dwg	SHEET 3 OF 3	