



REVISIONS			
REV	DESCRIPTION	DATE	BY

NOTE 1: Do not scale drawing. This drawing is for general truck configuration only. All items and dimensions shown are approximate and may vary with final production. The drawing may not provide illustration for all items in the specification. In all situations where the drawing may contradict the specifications, the specifications shall prevail. This drawing and all data herein are provided as confidential materials and shall not be reproduced without written consent of the manufacturer.




NOTE 2: Chassis frame height will change due to axle characteristics, loading and tire dimensions which will effect the overall height dimension shown. Any overall height restrictions should take this into consideration and allow approximately 2-3 inches of tolerance.

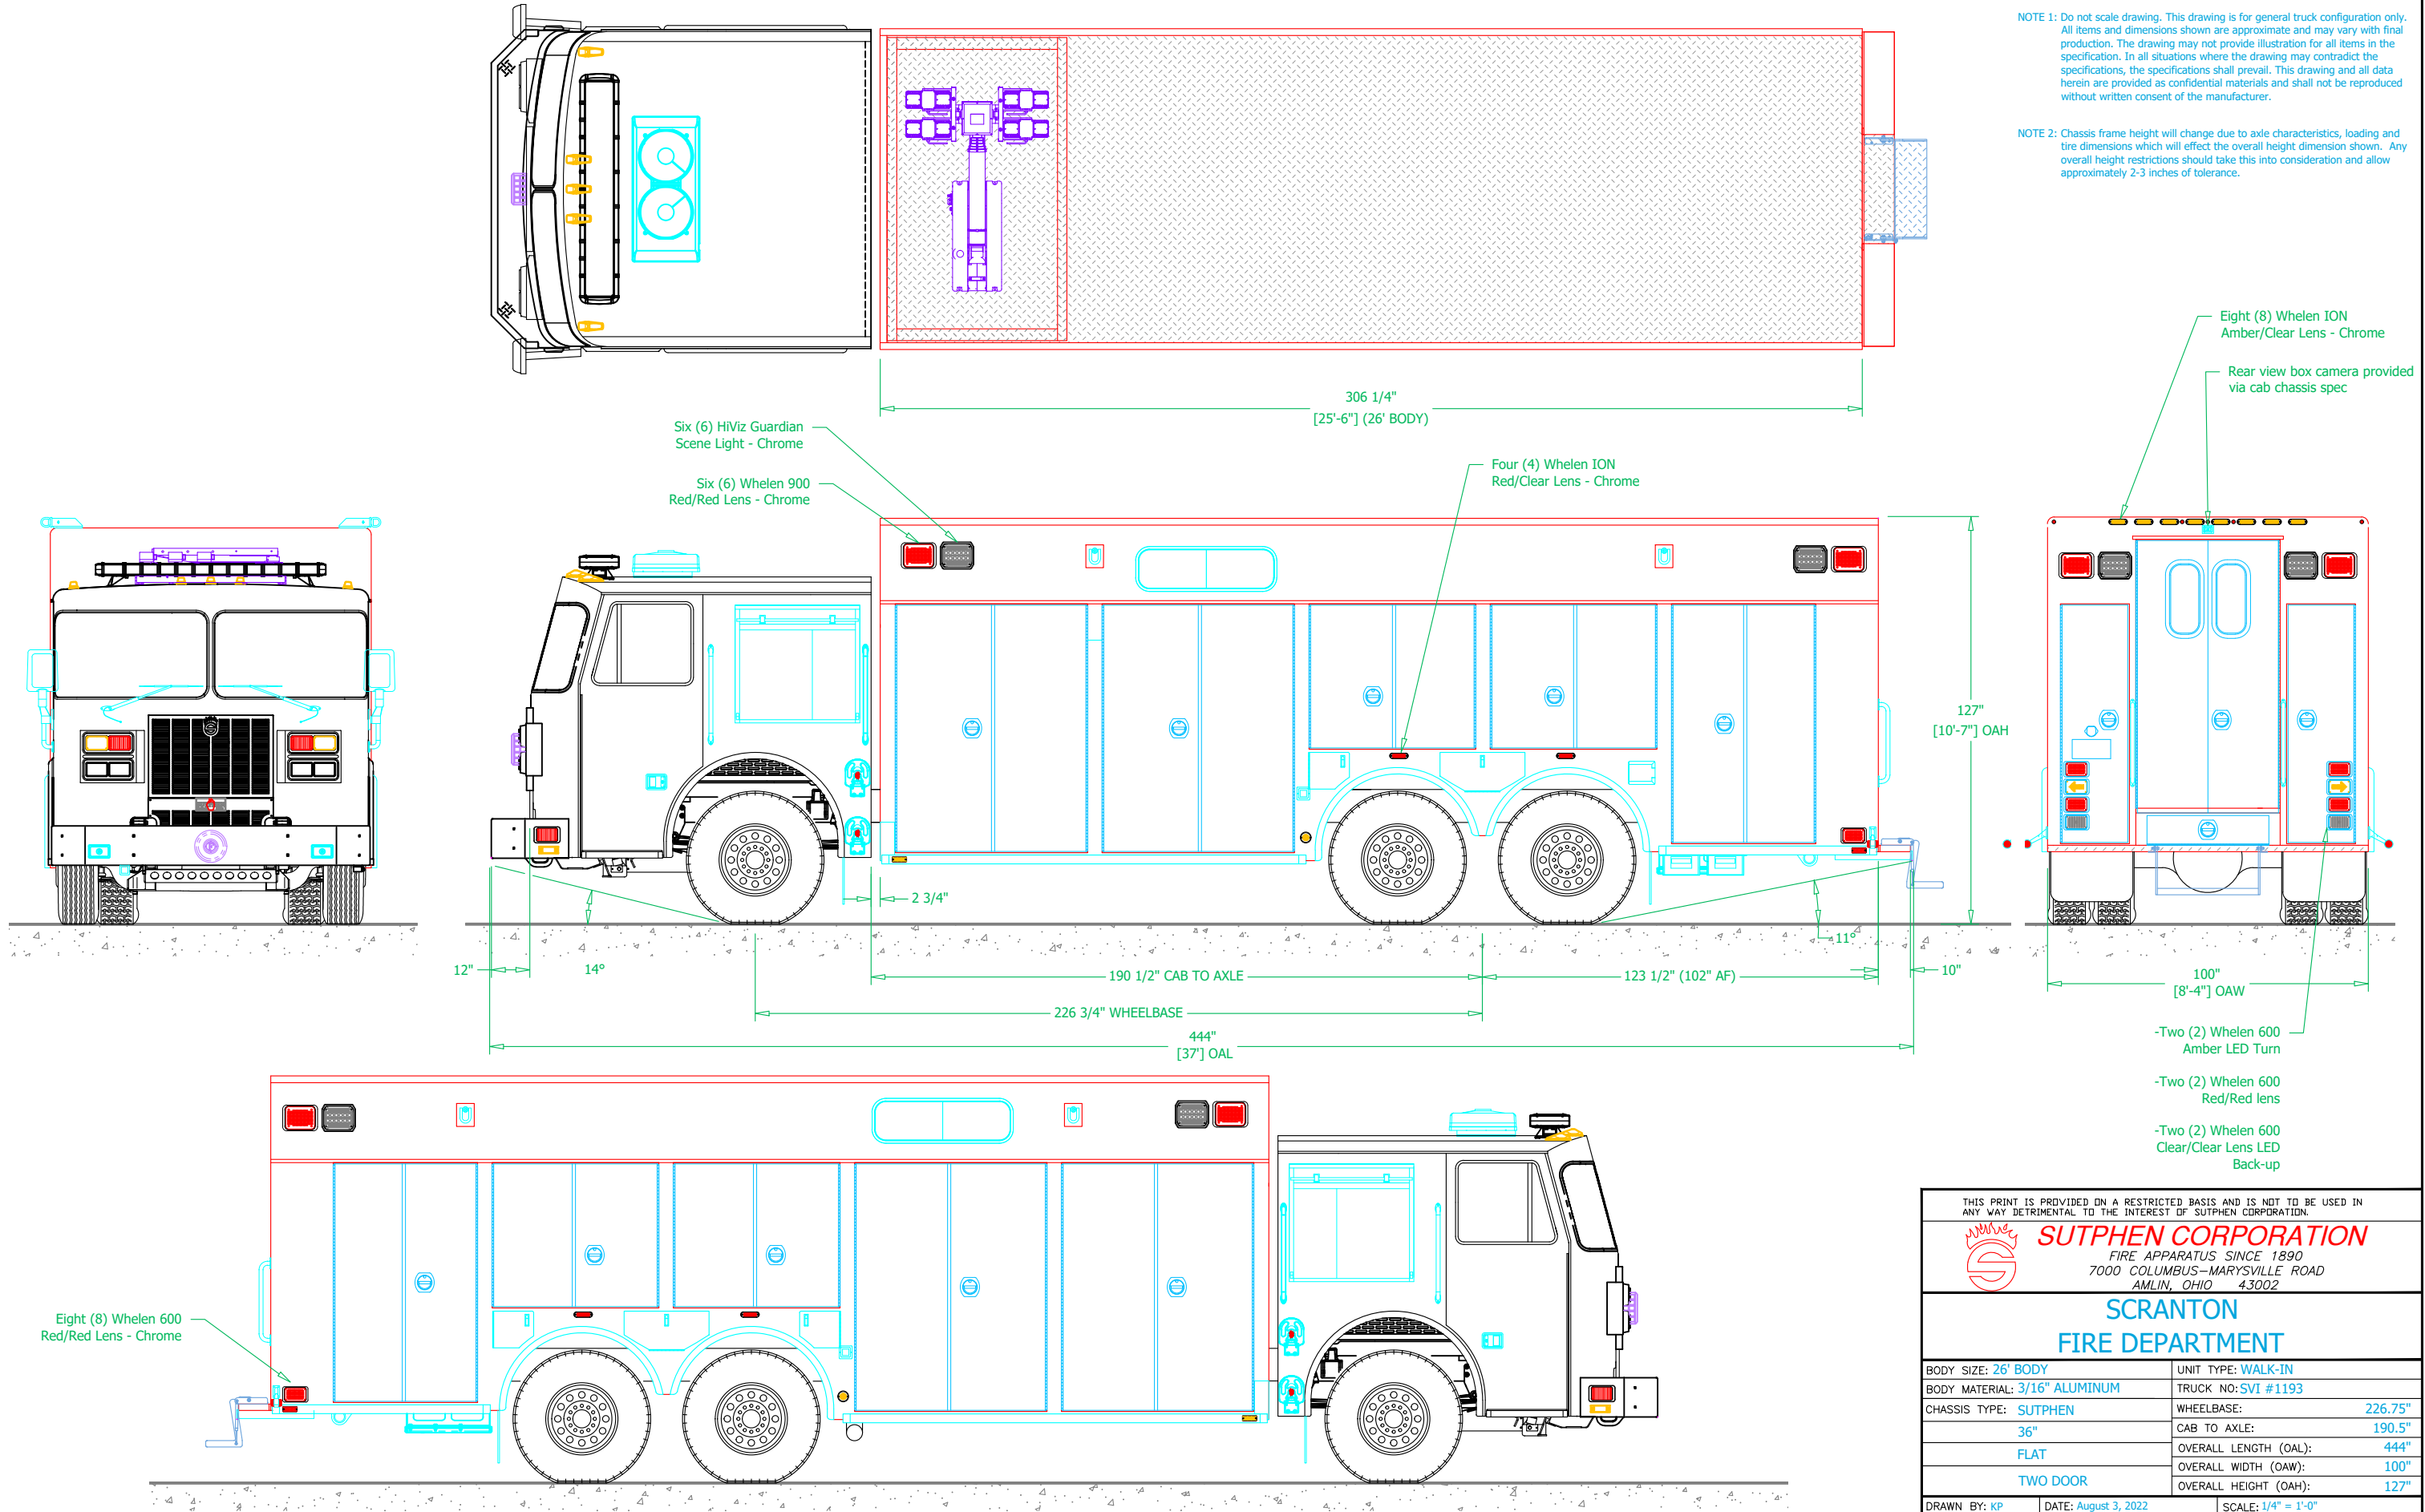


THIS PRINT IS PROVIDED ON A RESTRICTED BASIS AND IS NOT TO BE USED IN ANY WAY DETRIMENTAL TO THE INTEREST OF SUTPHEN CORPORATION.			
<div><div><div>SUTPHEN CORPORATION</div><div>FIRE APPARATUS SINCE 1890</div><div>7000 COLUMBUS-MARYSVILLE ROAD</div><div>AMLIN, OHIO 43002</div></div></div>			
SCRANTON FIRE DEPARTMENT			
BODY SIZE: 26' BODY		UNIT TYPE: WALK-IN	
BODY MATERIAL: 3/16" ALUMINUM		TRUCK NO: SVI #1193	
CHASSIS TYPE: SUTPHEN		WHEELBASE:	226.75"
36"		CAB TO AXLE:	190.5"
FLAT		OVERALL LENGTH (OAL):	444"
TWO DOOR		OVERALL WIDTH (OAW):	100"
		OVERALL HEIGHT (OAH):	127"
DRAWN BY: KP		DATE: August 3, 2022	
DRAWING NO: Scranton PA hr AsBuilt		SCALE: 1/4" = 1'-0"	
		SHEET 1 OF 3	

REVISIONS			
REV	DESCRIPTION	DATE	BY

NOTE 1: Do not scale drawing. This drawing is for general truck configuration only. All items and dimensions shown are approximate and may vary with final production. The drawing may not provide illustration for all items in the specification. In all situations where the drawing may contradict the specifications, the specifications shall prevail. This drawing and all data herein are provided as confidential materials and shall not be reproduced without written consent of the manufacturer.

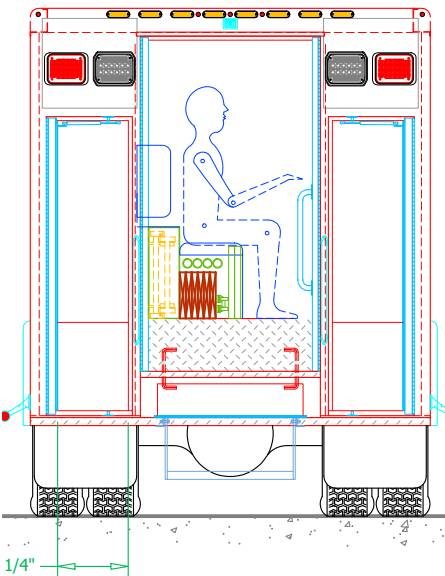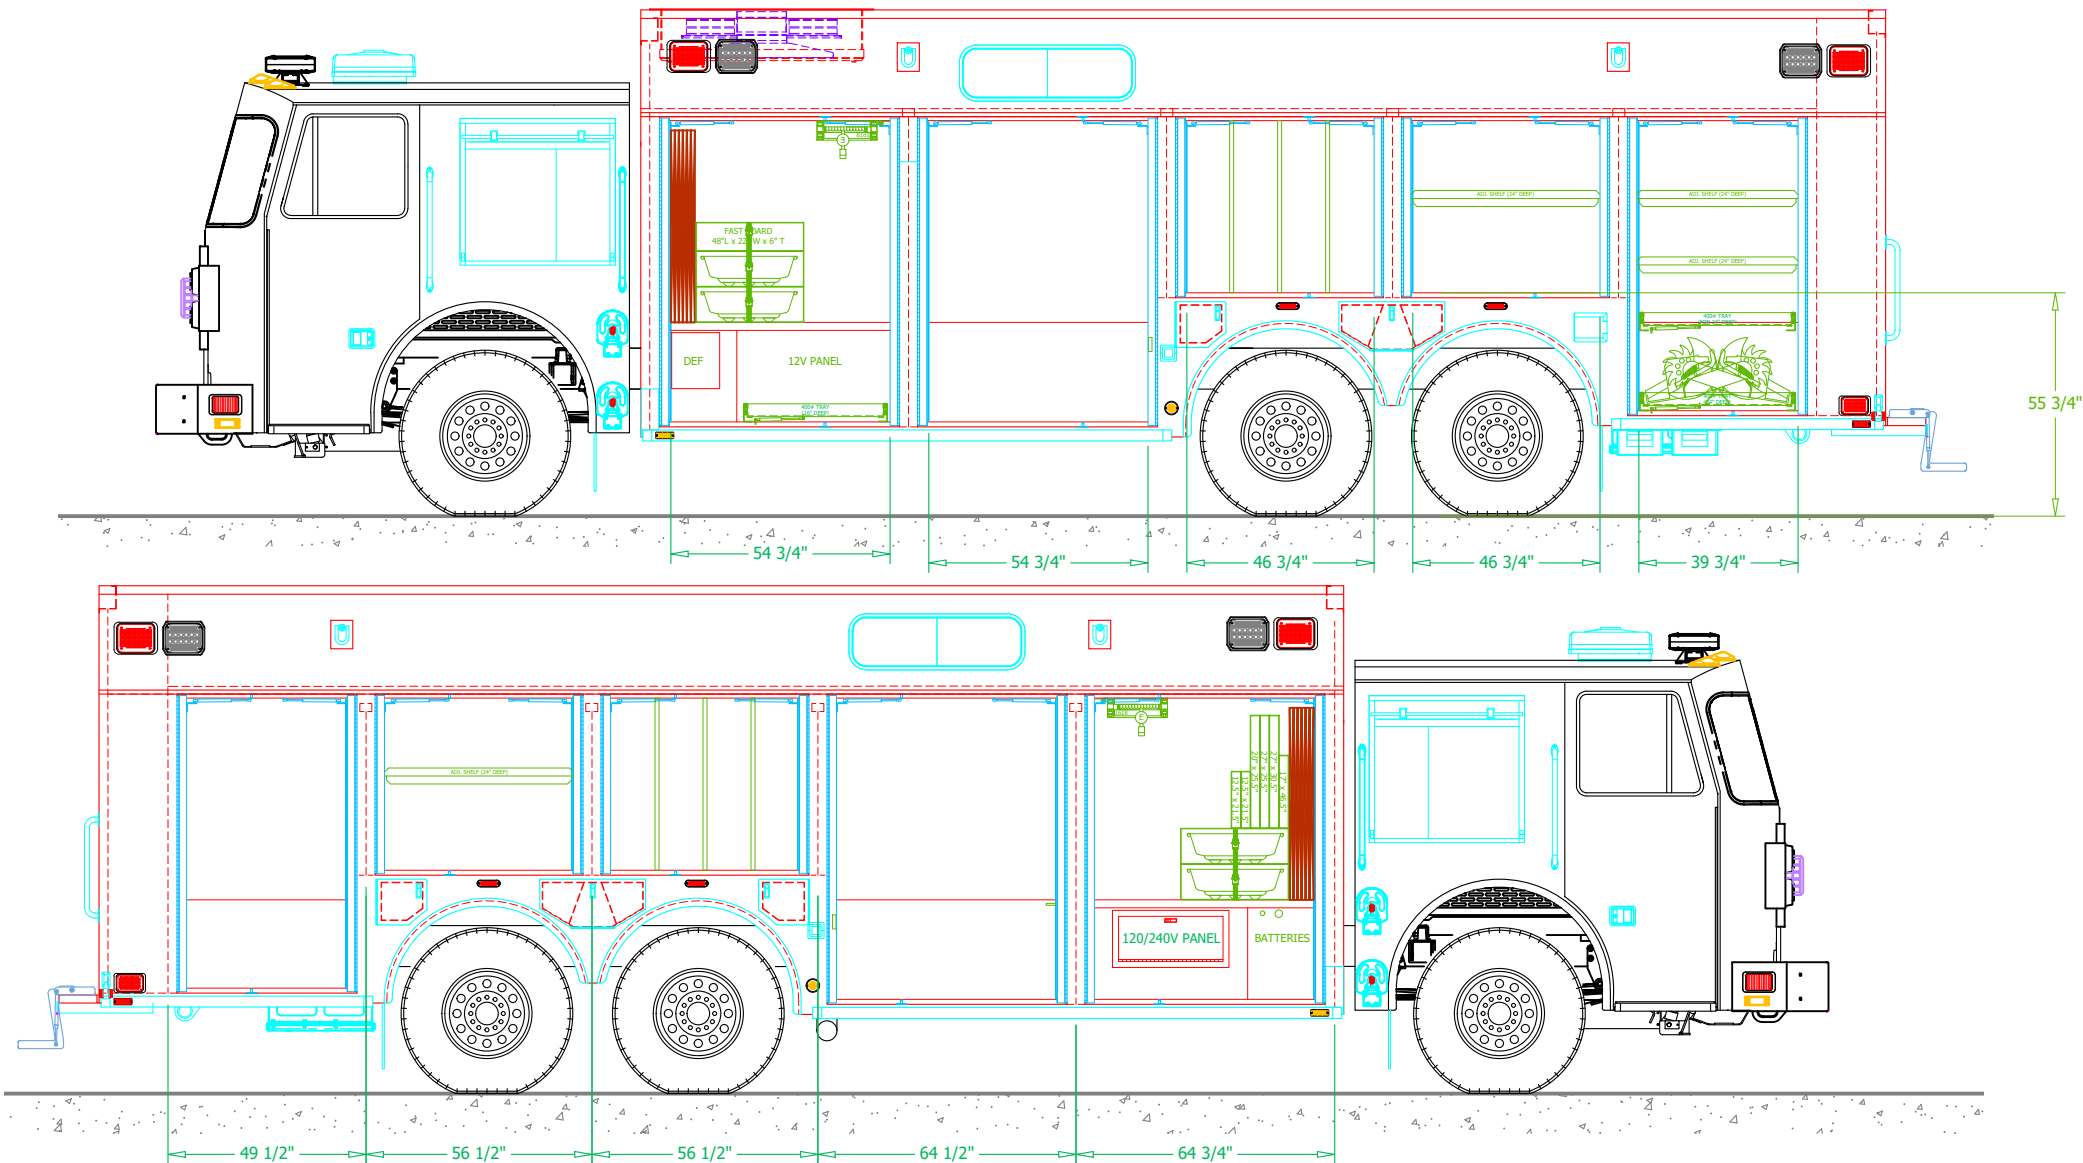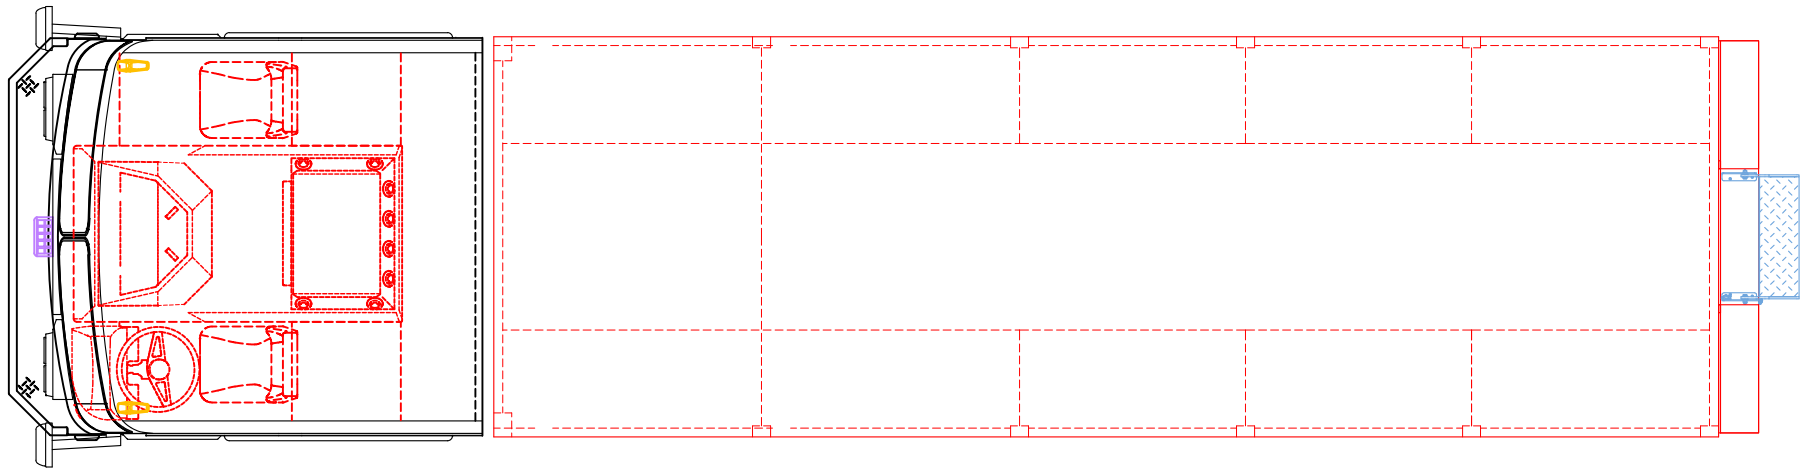

THIS PRINT IS PROVIDED ON A RESTRICTED BASIS AND IS NOT TO BE USED IN ANY WAY DETRIMENTAL TO THE INTEREST OF SUTPHEN CORPORATION.




SUTPHEN CORPORATION
FIRE APPARATUS SINCE 1890
7000 COLUMBUS-MARYSVILLE ROAD
AMLIN, OHIO 43002

SCRANTON
FIRE DEPARTMENT


BODY SIZE: 26' BODY	UNIT TYPE: WALK-IN
BODY MATERIAL: 3/16" ALUMINUM	TRUCK NO: SVI #1193
CHASSIS TYPE: SUTPHEN	WHEELBASE: 226.75"
36"	CAB TO AXLE: 190.5"
FLAT	OVERALL LENGTH (OAL): 444"
TWO DOOR	OVERALL WIDTH (OAW): 100"
	OVERALL HEIGHT (OAH): 127"

DRAWN BY: KP	DATE: August 3, 2022	SCALE: 1/4" = 1'-0"
DRAWING NO: Scranton PA hr AsBuilt		SHEET 2 OF 3


PLAN VIEW
CROSS-SECTION

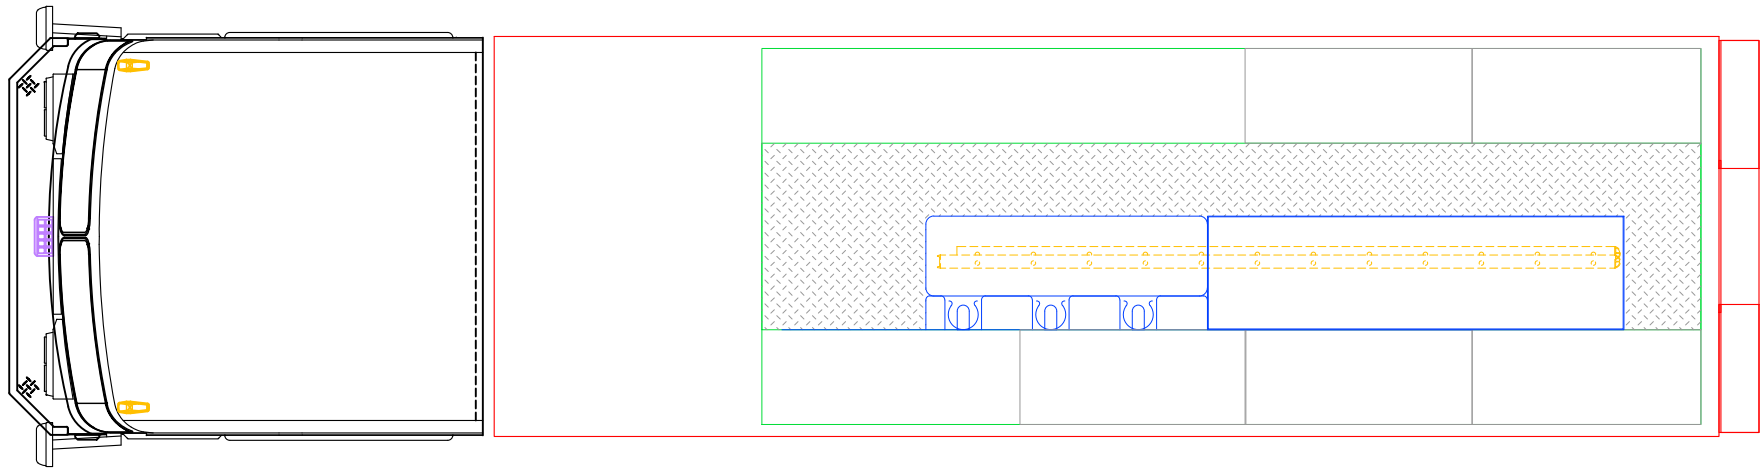


REAR VIEW
CROSS-SECTION

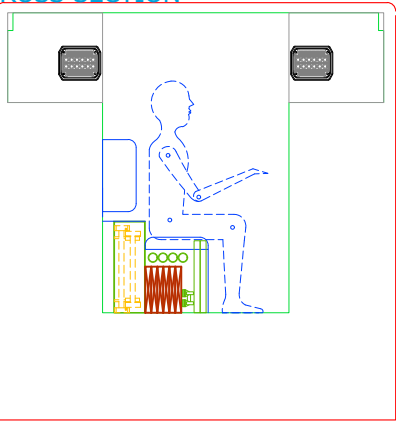

CURBSIDE INTERIOR
CROSS-SECTION

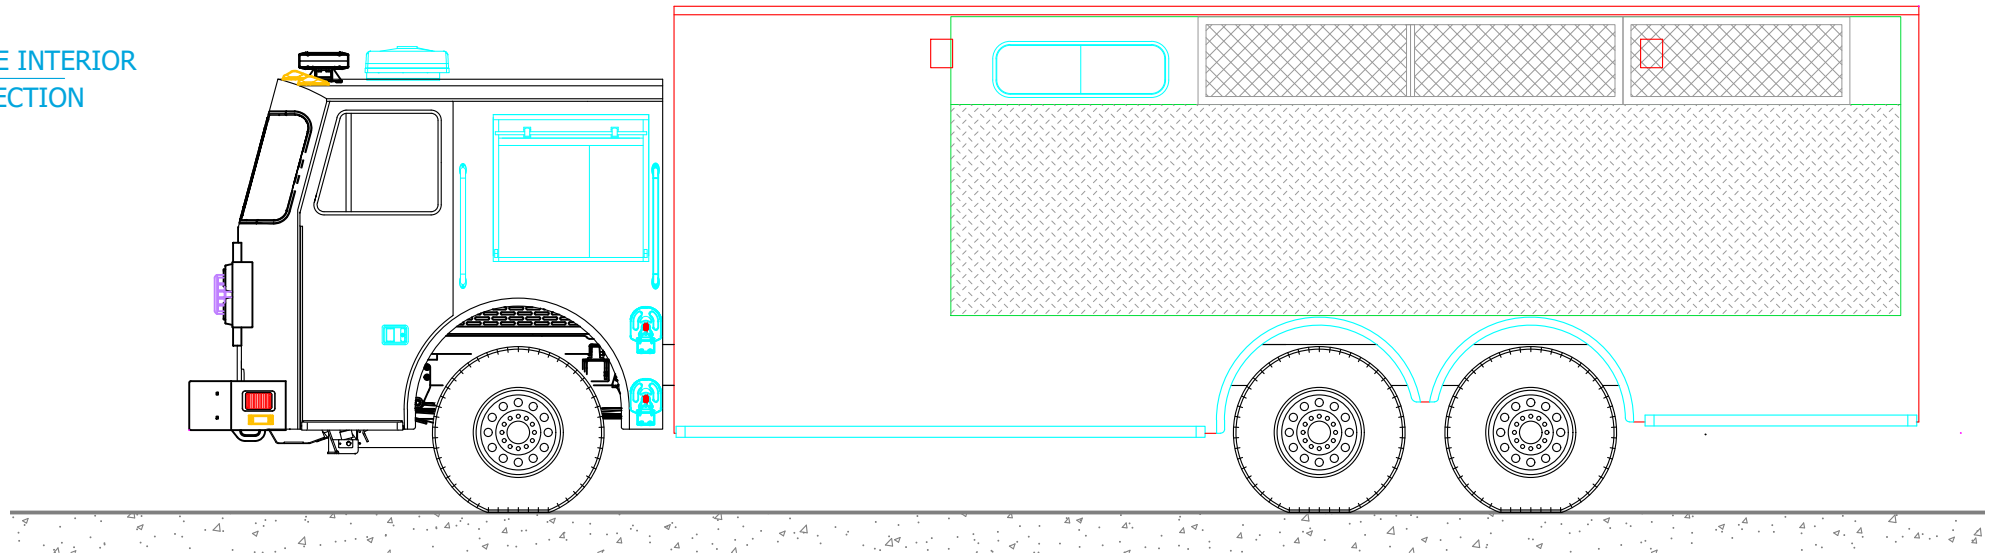


STREETSIDE INTERIOR
CROSS-SECTION

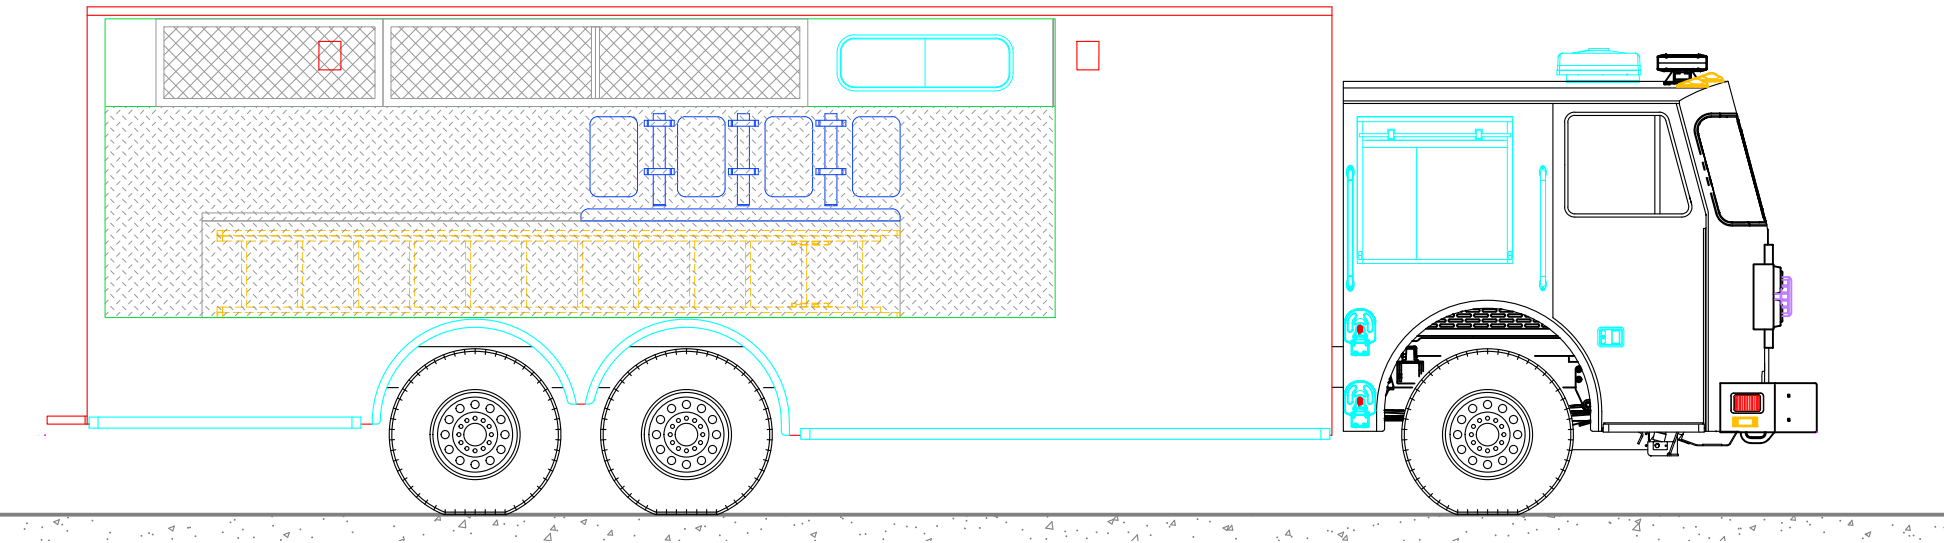

REVISIONS			
REV	DESCRIPTION	DATE	BY

NOTE 1: Do not scale drawing. This drawing is for general truck configuration only. All items and dimensions shown are approximate and may vary with final production. The drawing may not provide illustration for all items in the specification. In all situations where the drawing may contradict the specifications, the specifications shall prevail. This drawing and all data herein are provided as confidential materials and shall not be reproduced without written consent of the manufacturer.

THIS PRINT IS PROVIDED ON A RESTRICTED BASIS AND IS NOT TO BE USED IN ANY WAY DETRIMENTAL TO THE INTEREST OF SUTPHEN CORPORATION.			
		SUTPHEN CORPORATION FIRE APPARATUS SINCE 1890 7000 COLUMBUS-MARYSVILLE ROAD AMLIN, OHIO 43002	
SCRANTON FIRE DEPARTMENT			
BODY SIZE: 26' BODY		UNIT TYPE: WALK-IN	
BODY MATERIAL: 3/16" ALUMINUM		TRUCK NO: SVI #1193	
CHASSIS TYPE: SUTPHEN		WHEELBASE:	226.75"
36"		CAB TO AXLE:	190.5"
FLAT		OVERALL LENGTH (OAL):	444"
TWO DOOR		OVERALL WIDTH (OAW):	100"
		OVERALL HEIGHT (OAH):	127"
DRAWN BY: KP		DATE: August 3, 2022	
		SCALE: 1/4" = 1'-0"	
DRAWING NO: Scranton PA hr AsBuilt		SHEET 3 OF 3	