


REVISIONS			
REV	DESCRIPTION	DATE	BY



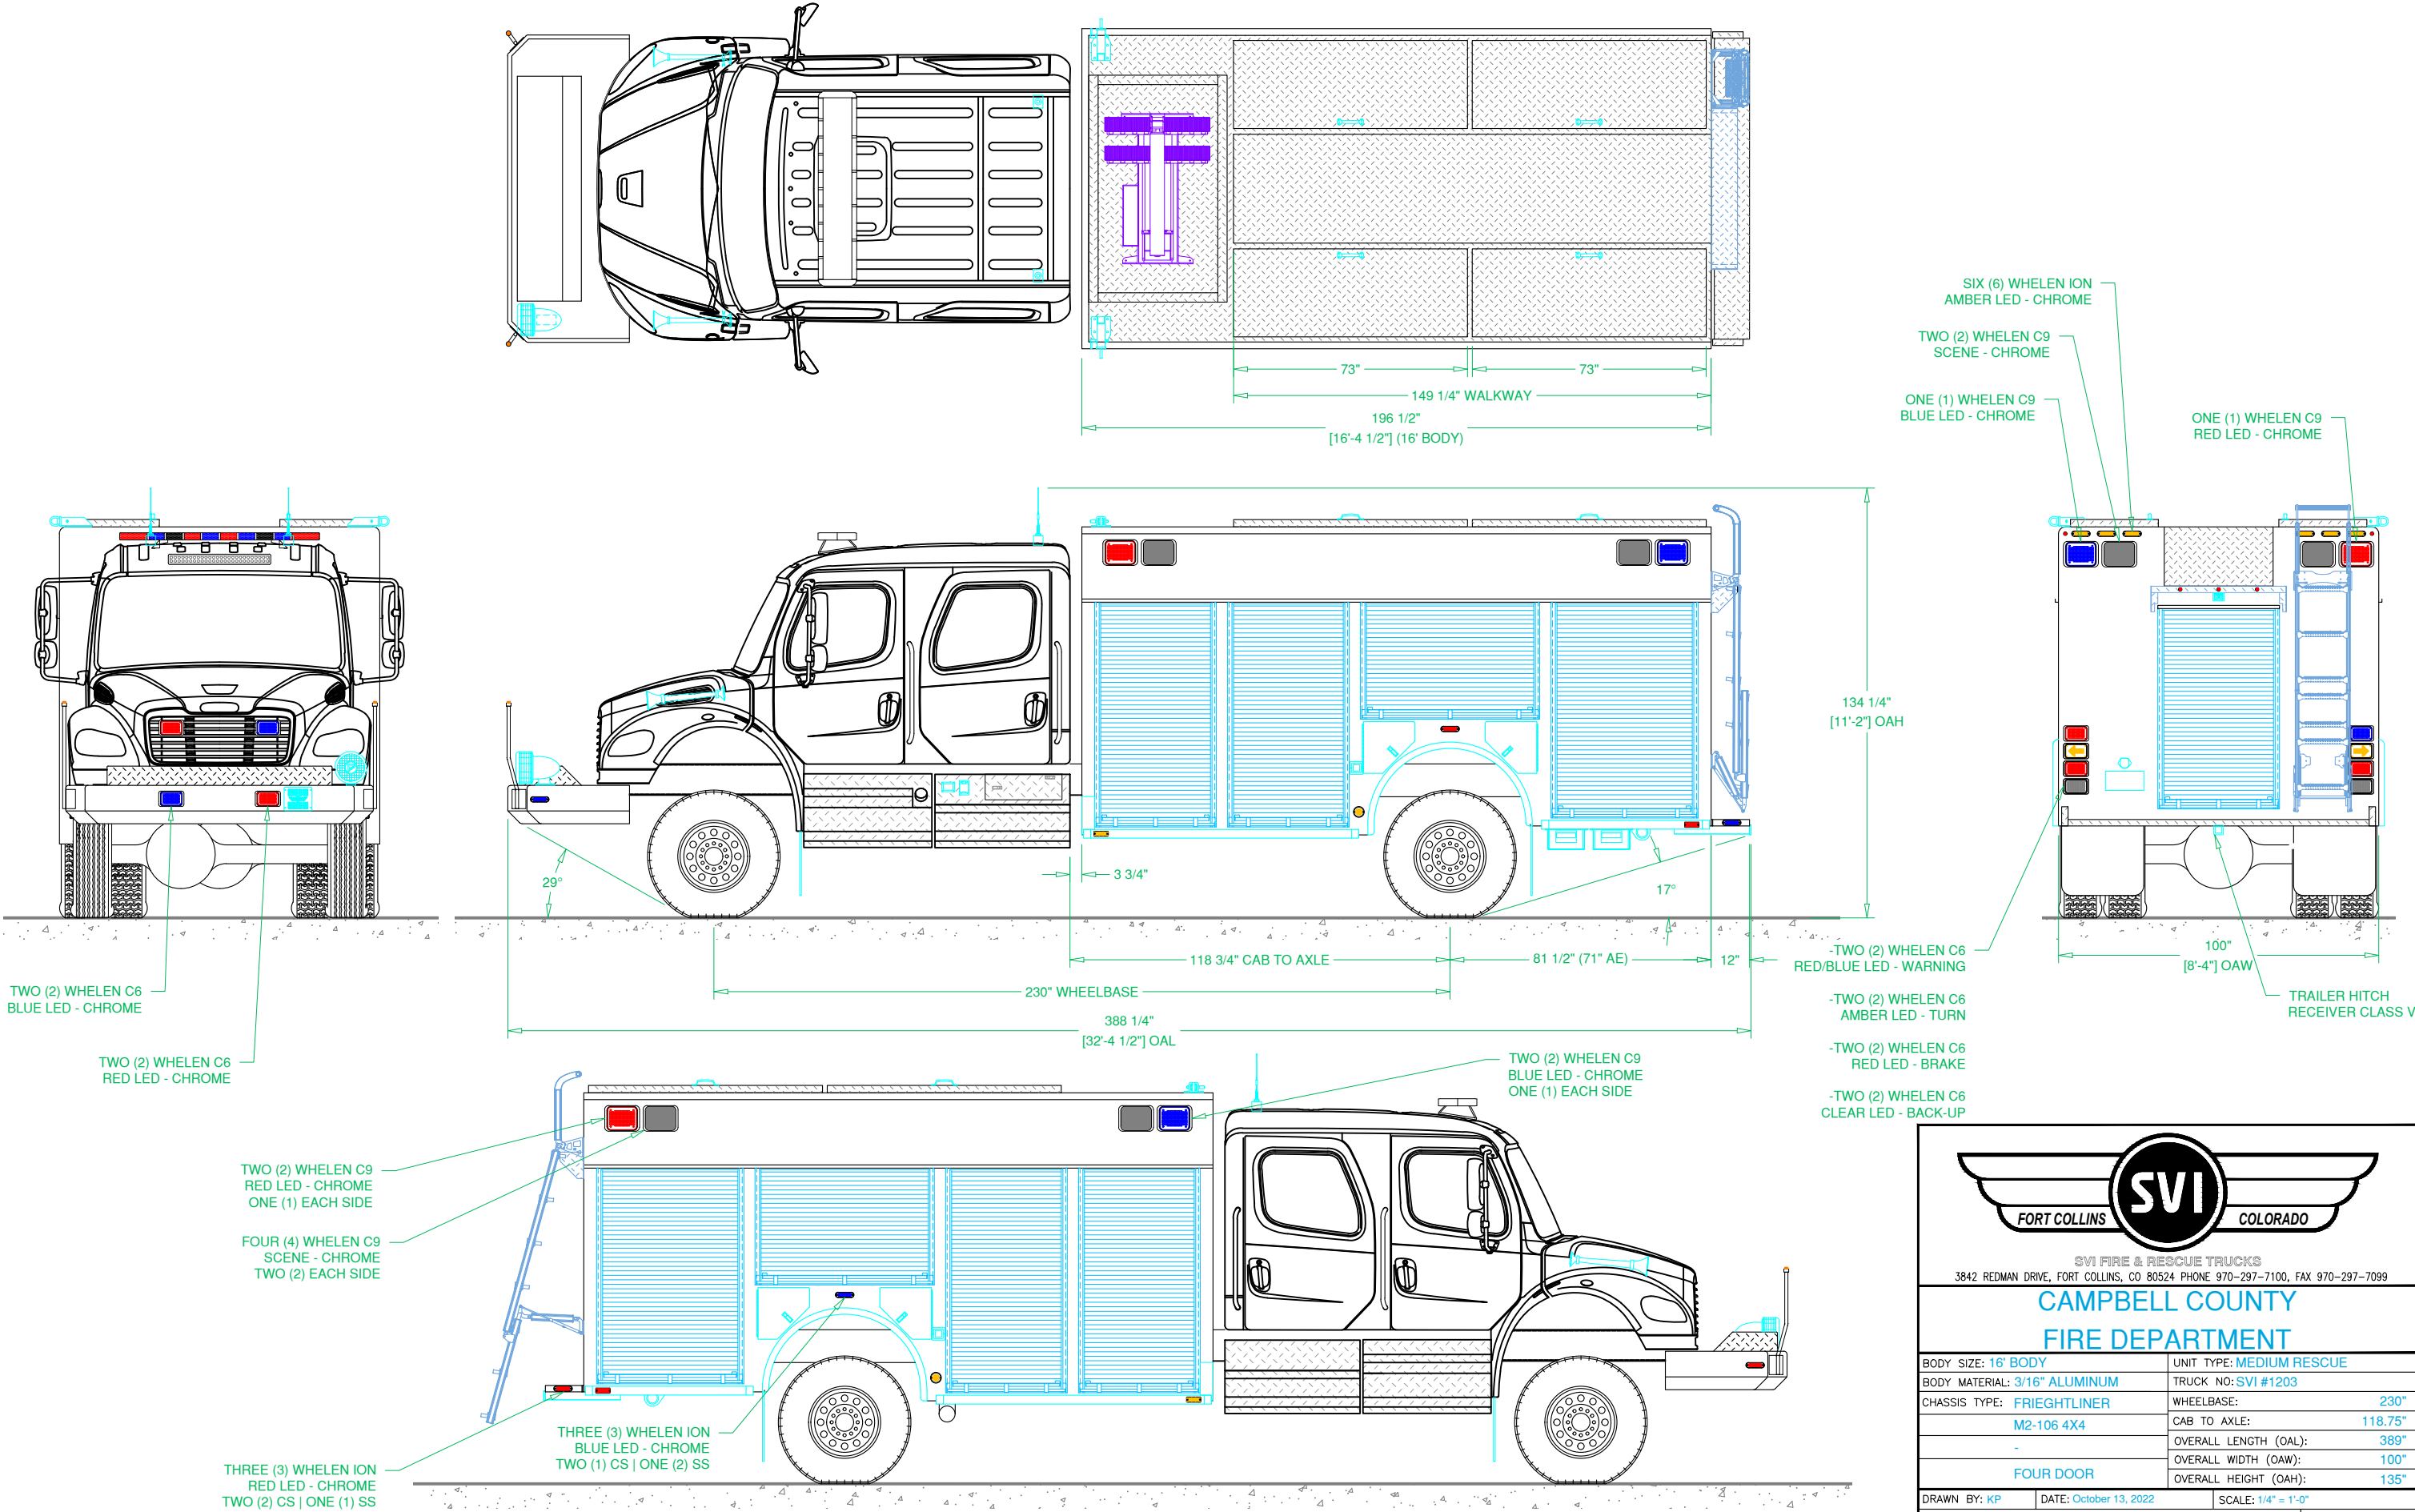

SVI FORT COLLINS COLORADO

SVI FIRE & RESCUE TRUCKS

3842 REDMAN DRIVE, FORT COLLINS, CO 80524 PHONE 970-297-7100, FAX 970-297-7099

CAMPBELL COUNTY

FIRE DEPARTMENT

BODY SIZE: 16' BODY	UNIT TYPE: MEDIUM RESCUE
BODY MATERIAL: 3/16" ALUMINUM	TRUCK NO: SVI #1203
CHASSIS TYPE: FRIEGHTLINER	WHEELBASE: 230"
M2-106 4X4	CAB TO AXLE: 118.75"
-	OVERALL LENGTH (OAL): 389"
FOUR DOOR	OVERALL WIDTH (OAW): 100"
	OVERALL HEIGHT (OAH): 135"

DRAWN BY: KP





DATE: October 13, 2022

SCALE: 1/4" = 1'-0"

DRAWING NO: CampbellCounty_WY_rr16_AsBuilt

SHEET 1 OF 2

REVISIONS			
REV	DESCRIPTION	DATE	BY

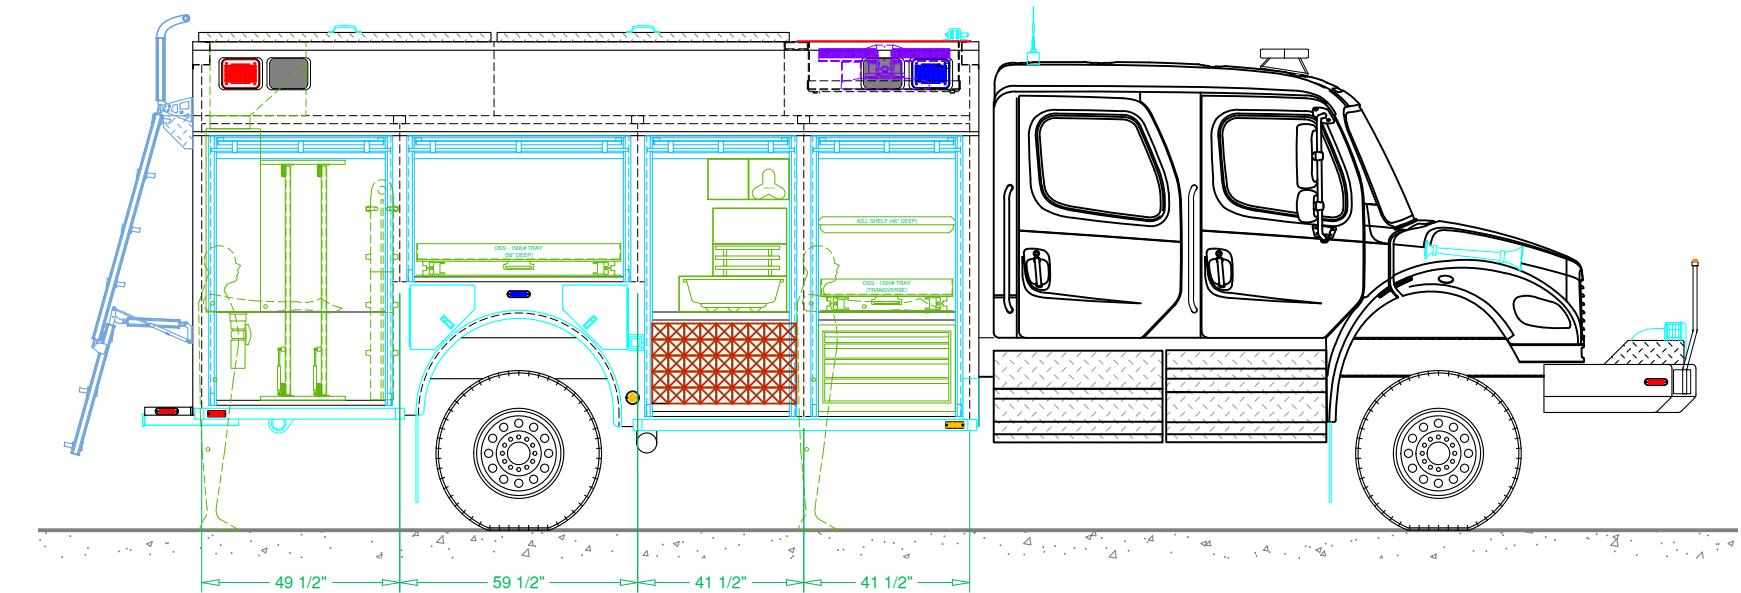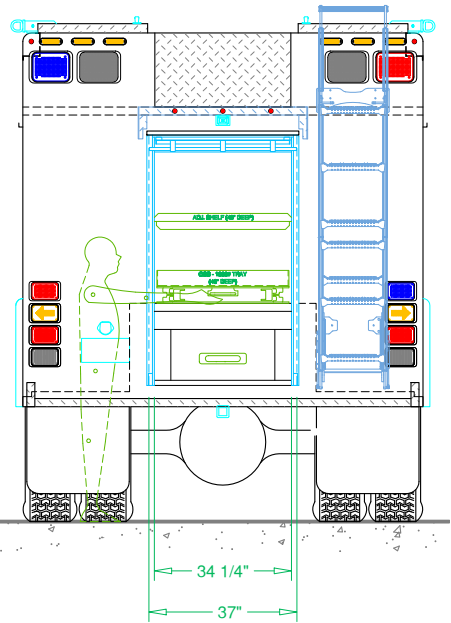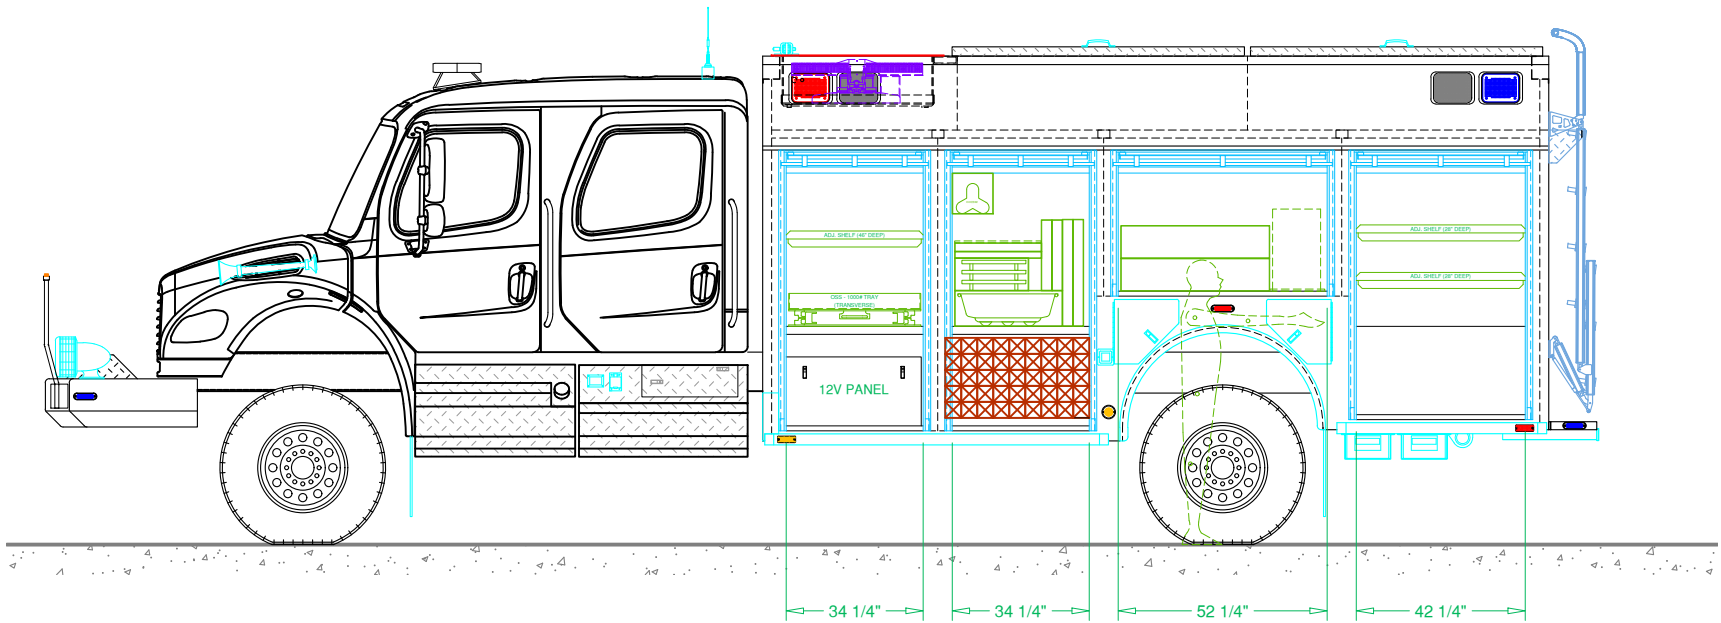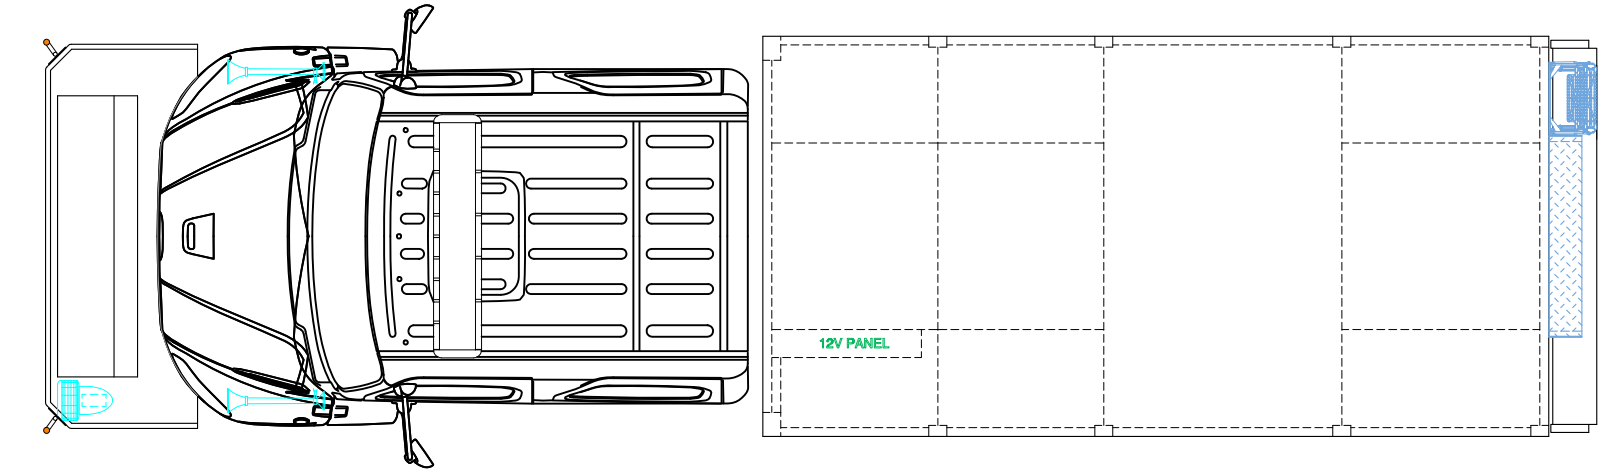



SVI FIRE & RESCUE TRUCKS
3842 REDMAN DRIVE, FORT COLLINS, CO 80524 PHONE 970-297-7100, FAX 970-297-7099

CAMPBELL COUNTY
FIRE DEPARTMENT

DRAWN BY: KP
DATE: Oct. 13, 22
SCALE: 1/4" = 1'-0"

DRAWING NO: CampbellCounty_WY_mr16_AsBuilt
SHEET 2 OF 2