


REVISIONS			
REV	DESCRIPTION	DATE	BY

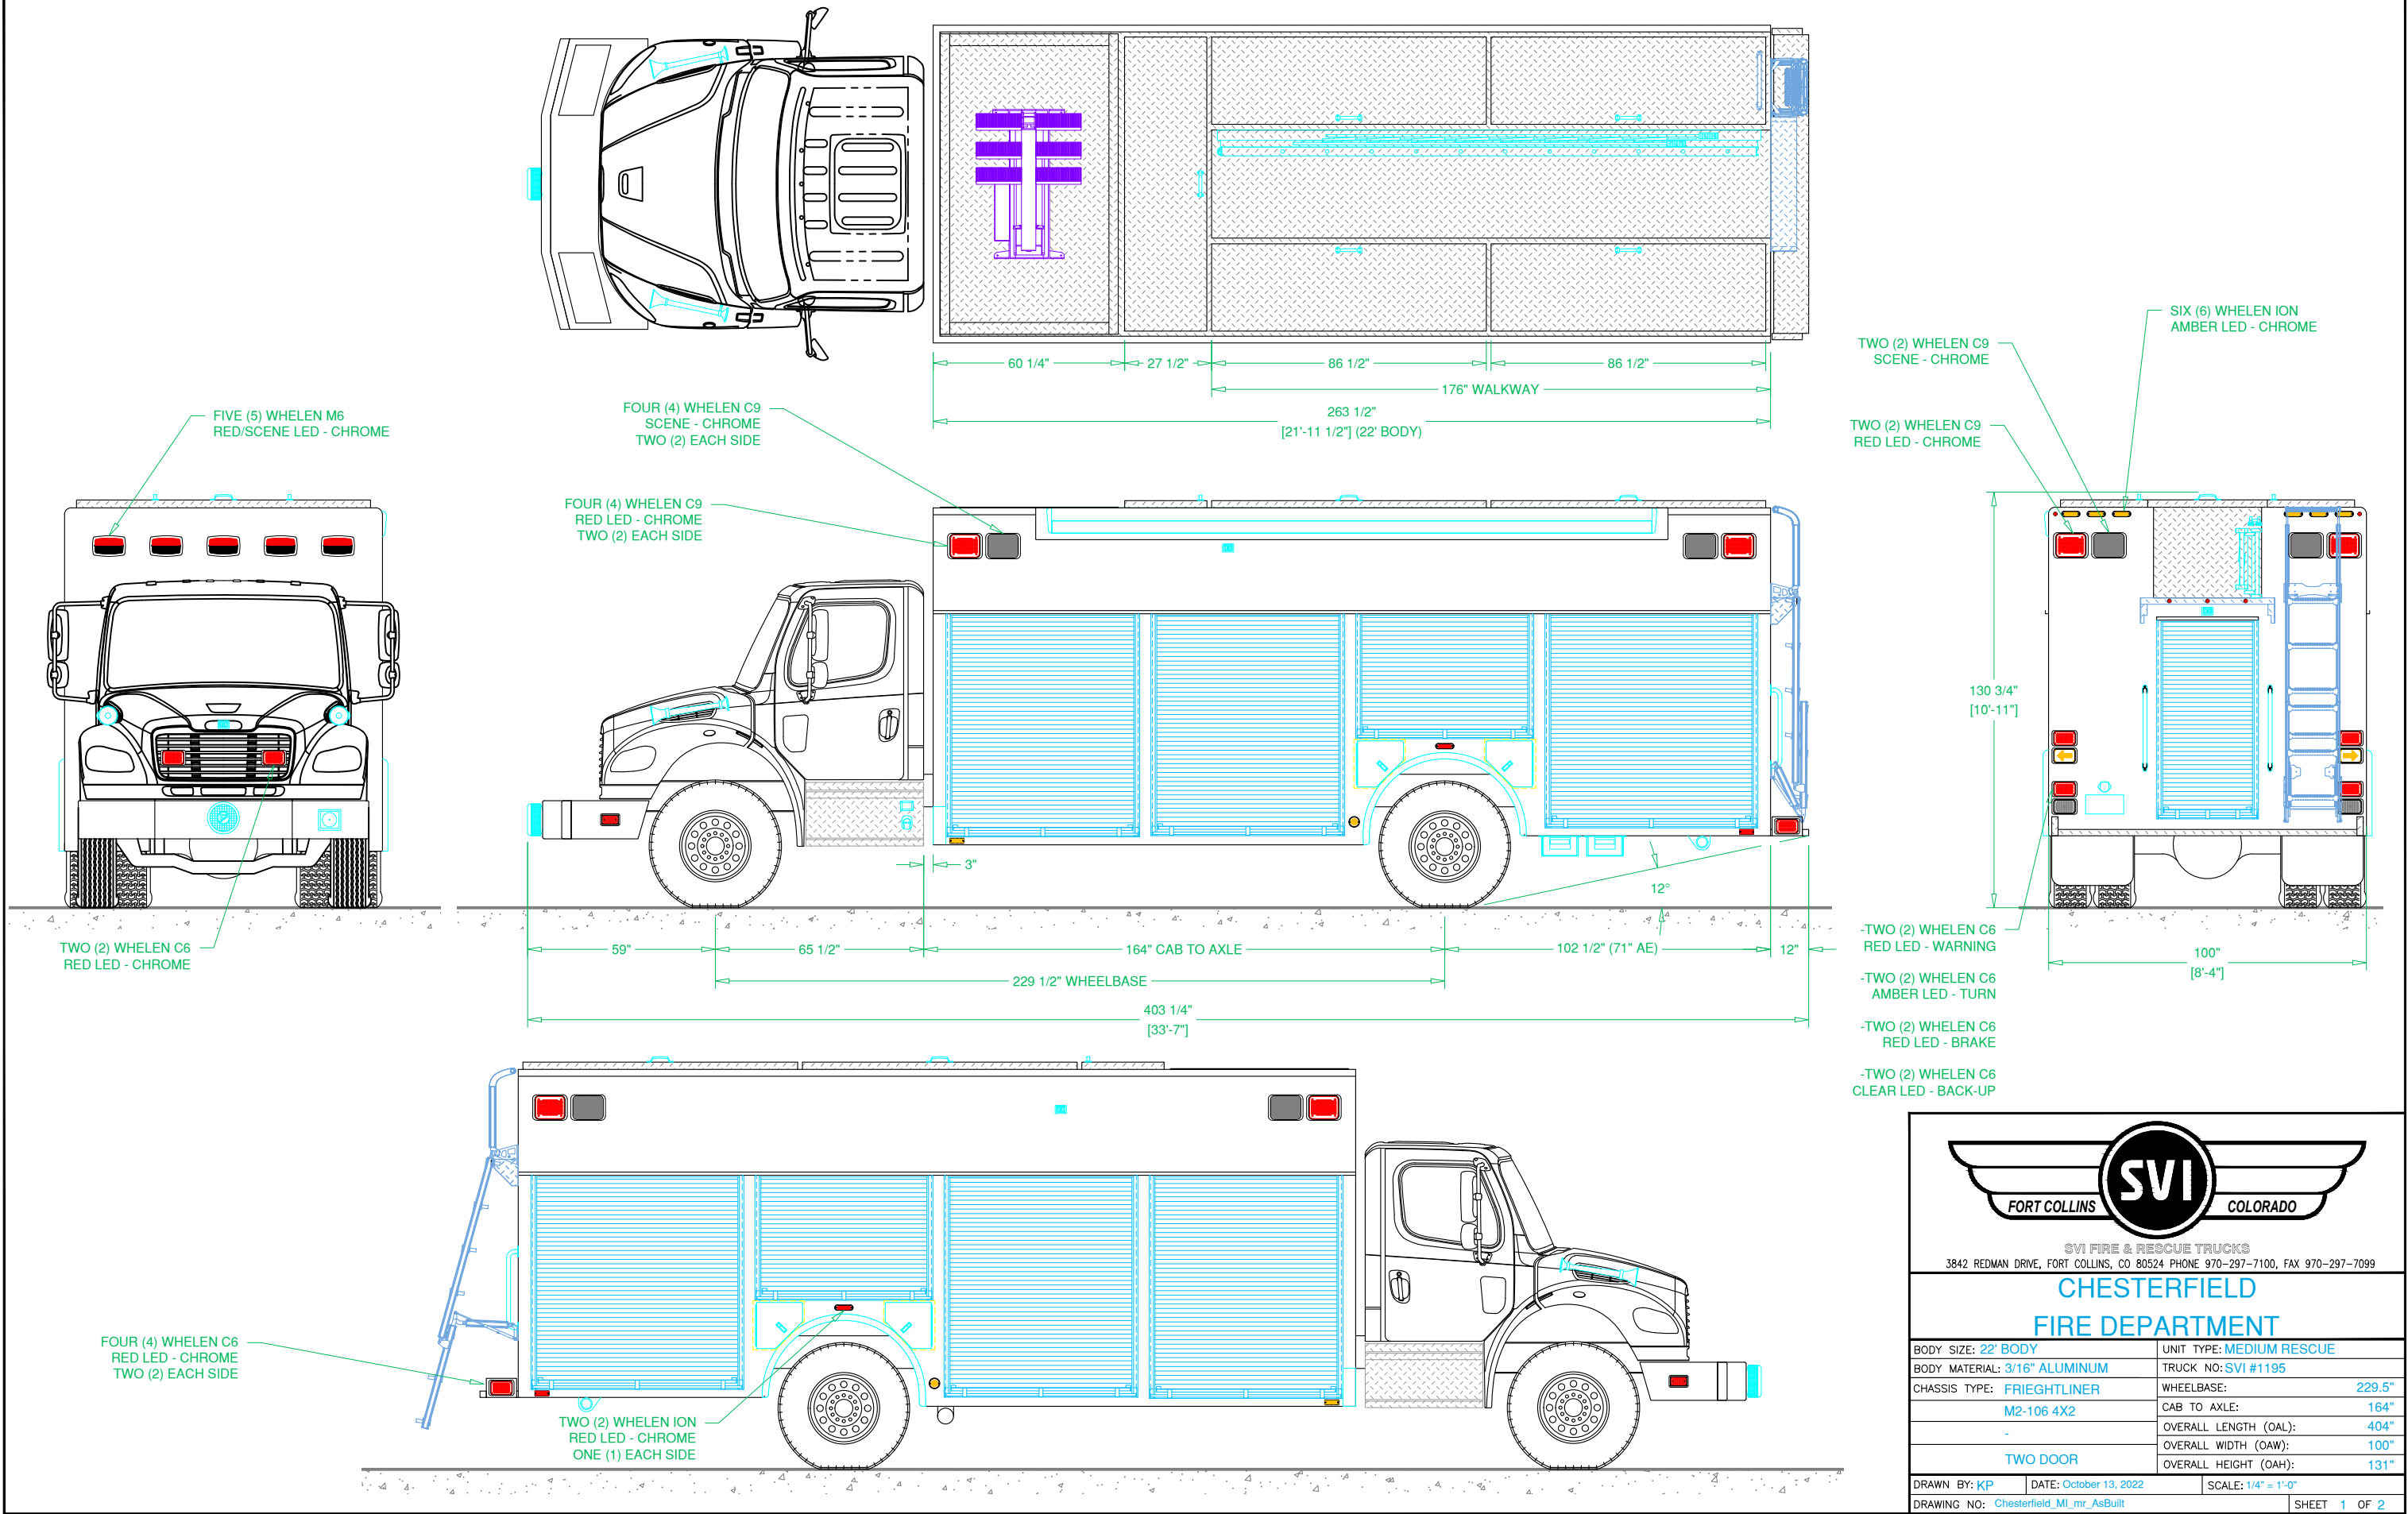





SVI FIRE & RESCUE TRUCKS
3842 REDMAN DRIVE, FORT COLLINS, CO 80524 PHONE 970-297-7100, FAX 970-297-7099

CHESTERFIELD FIRE DEPARTMENT

BODY SIZE: 22' BODY	UNIT TYPE: MEDIUM RESCUE
BODY MATERIAL: 3/16" ALUMINUM	TRUCK NO: SVI #1195
CHASSIS TYPE: FRIEGLTLINER	WHEELBASE: 229.5"
M2-106 4X2	CAB TO AXLE: 164"
-	OVERALL LENGTH (OAL): 404"
-	OVERALL WIDTH (OAW): 100"
TWO DOOR	OVERALL HEIGHT (OAH): 131"

DRAWN BY: KP	DATE: October 13, 2022	SCALE: 1/4" = 1'-0"
DRAWING NO: Chesterfield_MI_mr_AsBuilt	SHEET 1 OF 2	

REVISIONS			
REV	DESCRIPTION	DATE	BY

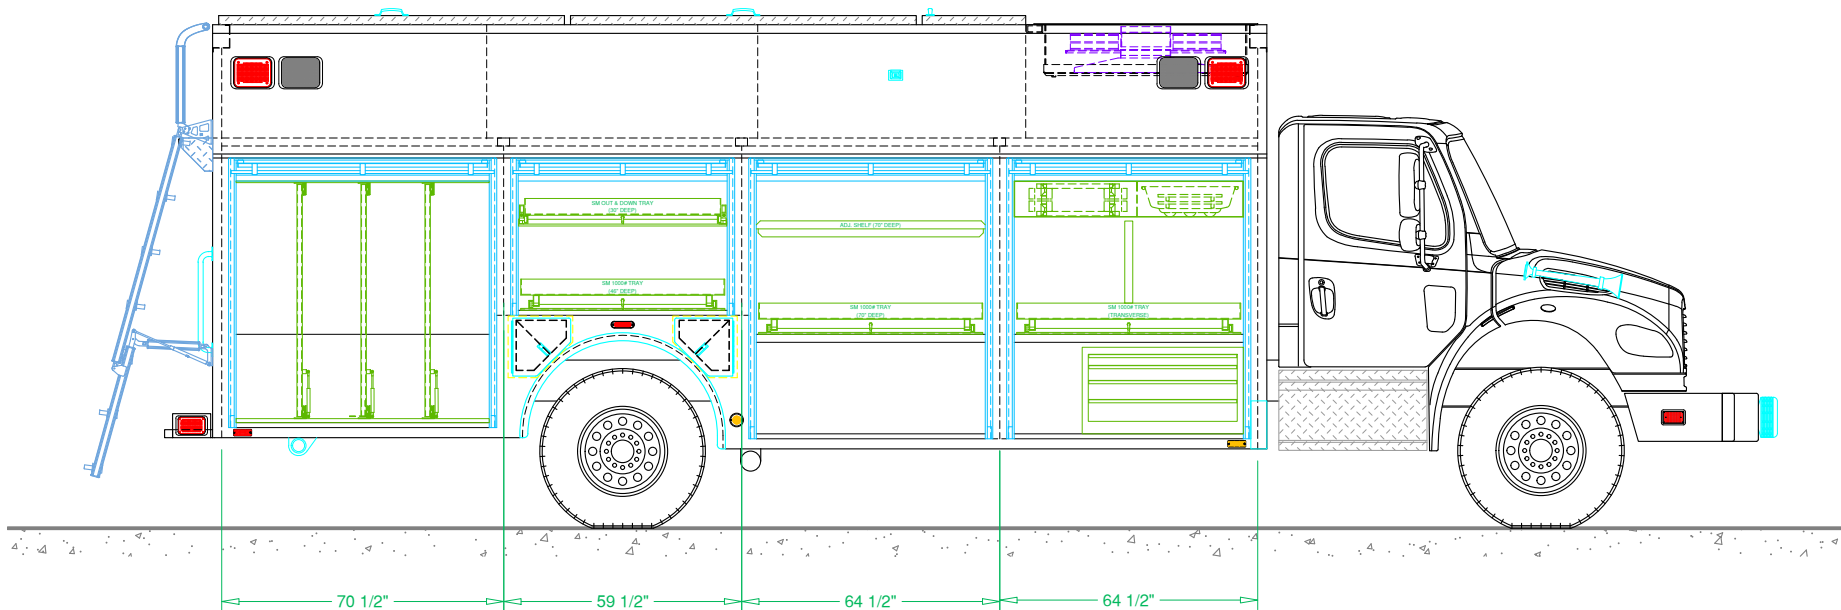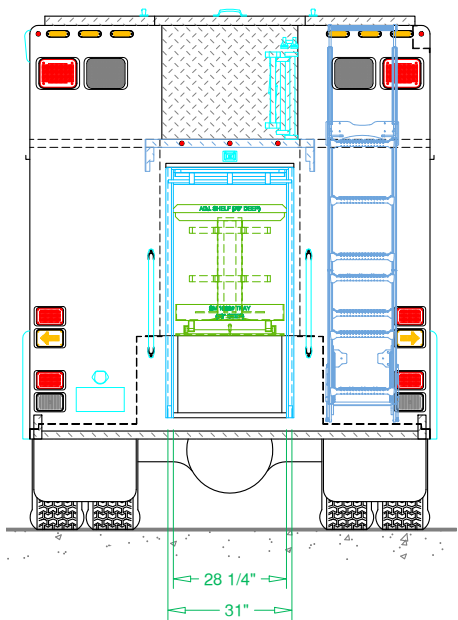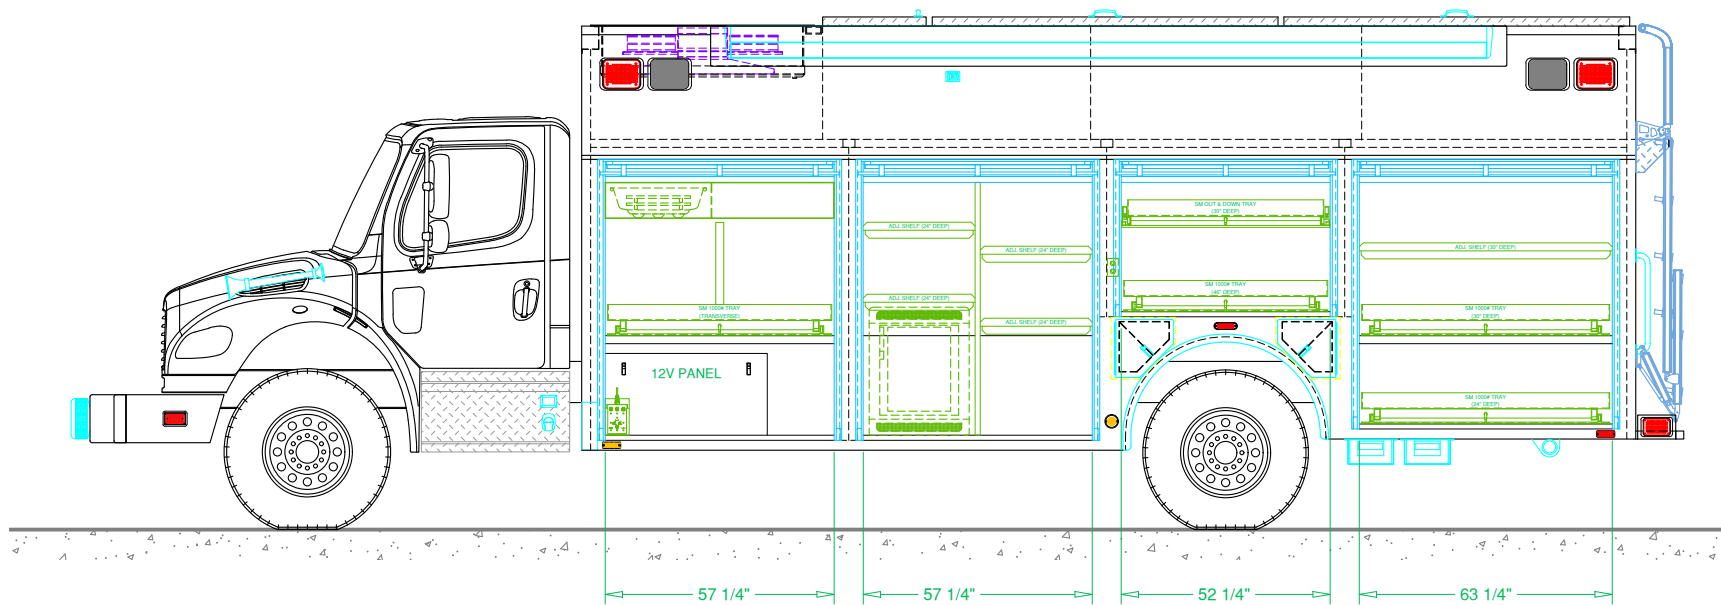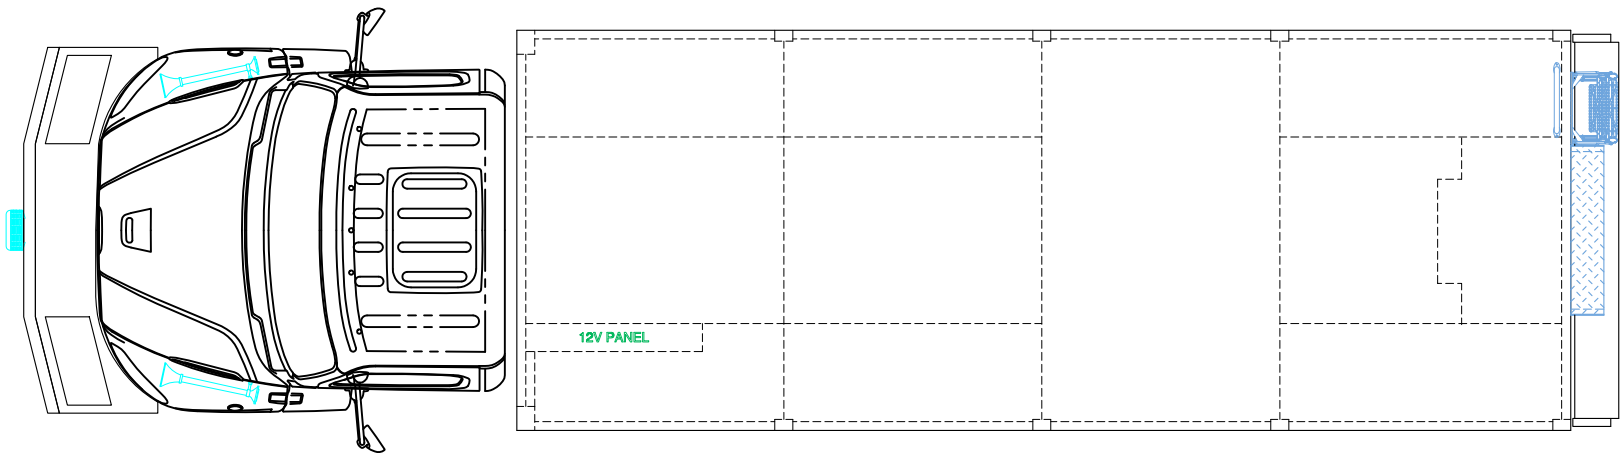

SVI FIRE & RESCUE TRUCKS
3842 REDMAN DRIVE, FORT COLLINS, CO 80524 PHONE 970-297-7100, FAX 970-297-7099

CHESTERFIELD
FIRE DEPARTMENT

DRAWN BY: KP	DATE: Oct. 13, 22	SCALE: 1/4" = 1'-0"
DRAWING NO: Chesterfield_MI_mr_AsBuilt	SHEET 2 OF 2	