


REVISIONS			
REV	DESCRIPTION	DATE	BY



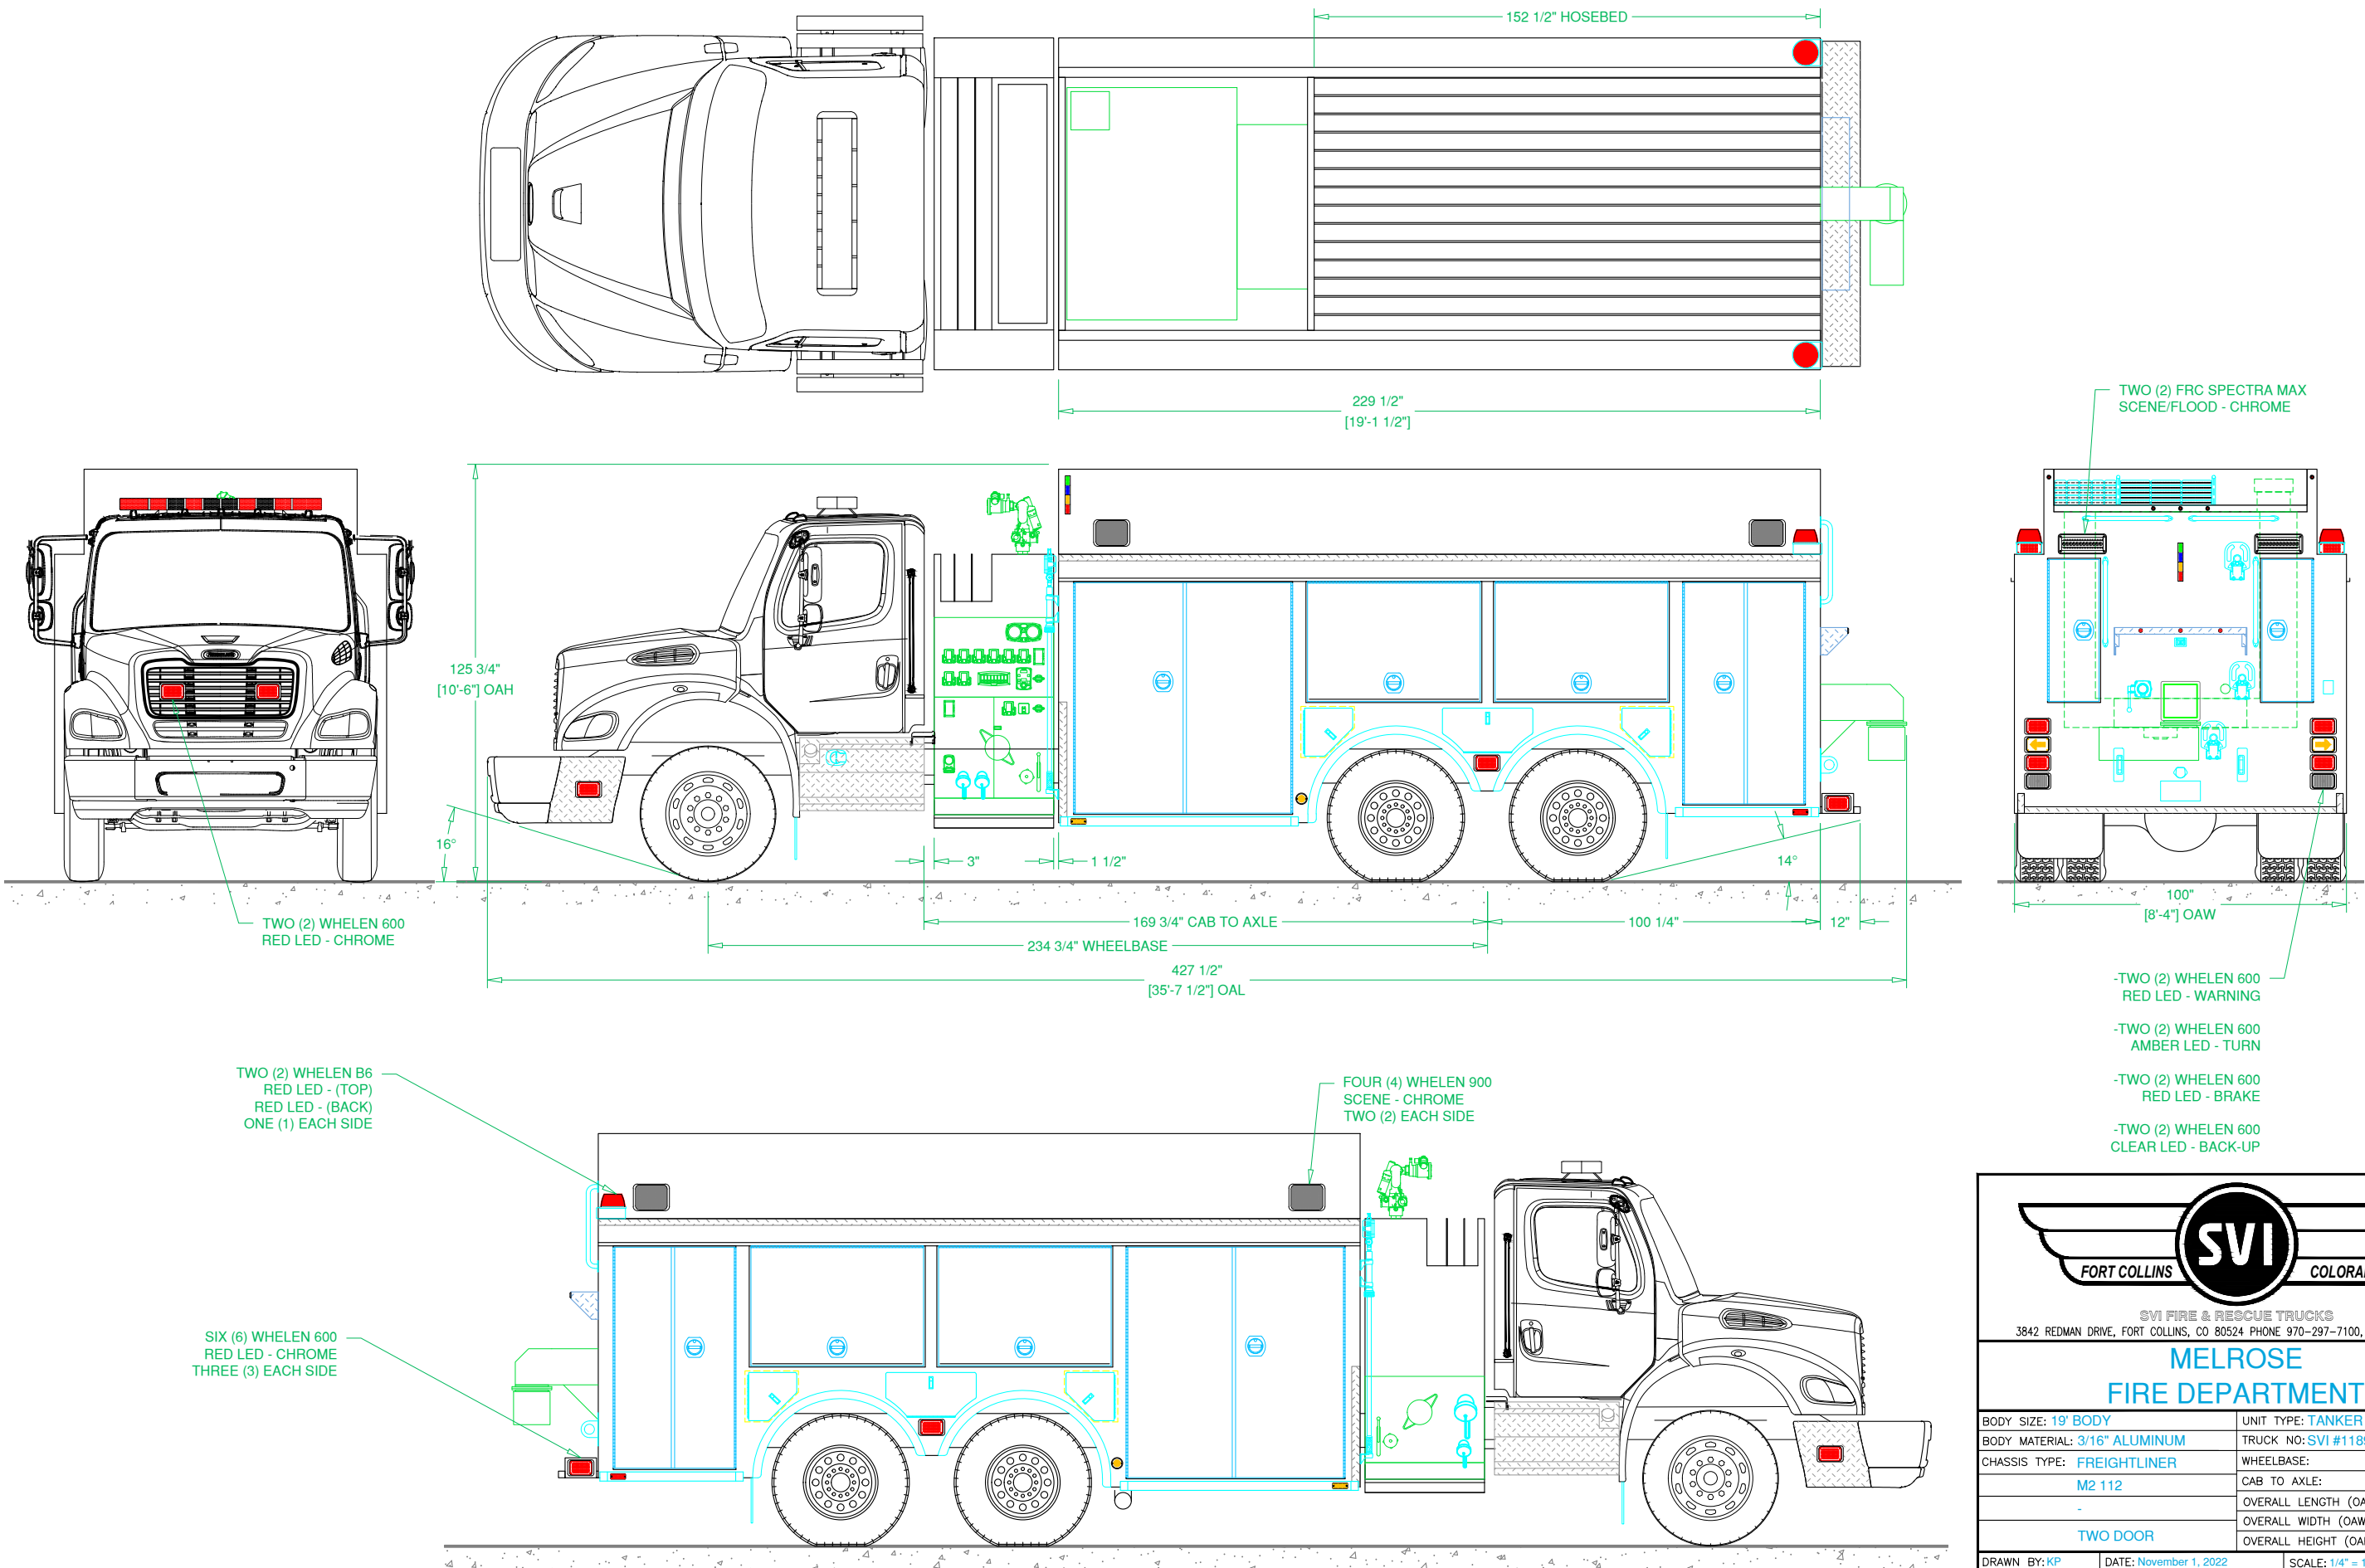

FORT COLLINS SVI COLORADO





SVI FIRE & RESCUE TRUCKS
3842 REDMAN DRIVE, FORT COLLINS, CO 80524 PHONE 970-297-7100, FAX 970-297-7099

MELROSE FIRE DEPARTMENT

BODY SIZE: 19' BODY	UNIT TYPE: TANKER
BODY MATERIAL: 3/16" ALUMINUM	TRUCK NO: SVI #1189
CHASSIS TYPE: FREIGHTLINER	WHEELBASE: 234.75"
M2 112	CAB TO AXLE: 169.75"
-	OVERALL LENGTH (OAL): 428"
-	OVERALL WIDTH (OAW): 100"
TWO DOOR	OVERALL HEIGHT (OAH): 126"

DRAWN BY: KP	DATE: November 1, 2022	SCALE: 1/4" = 1'-0"
DRAWING NO: MelroseFD NM tandem 3000tk AsBuilt		SHEET 1 OF 2

REVISIONS			
REV	DESCRIPTION	DATE	BY

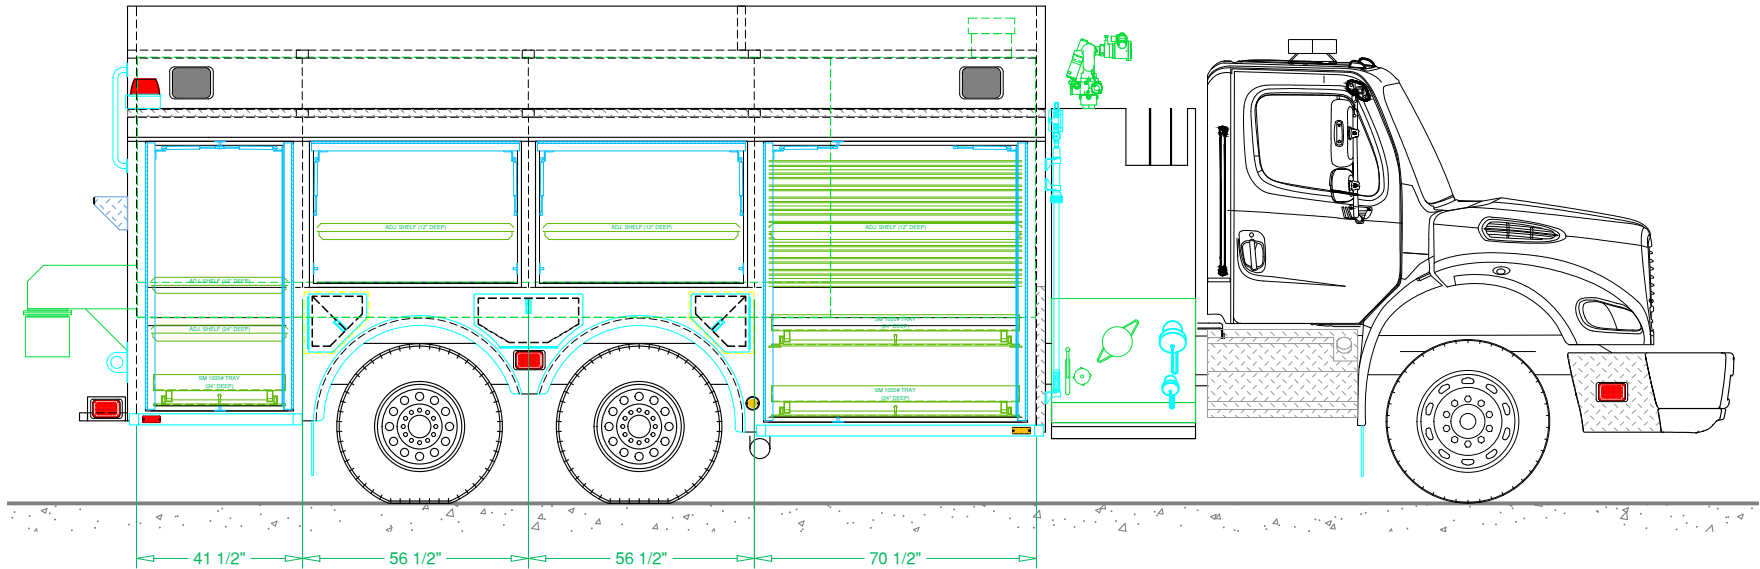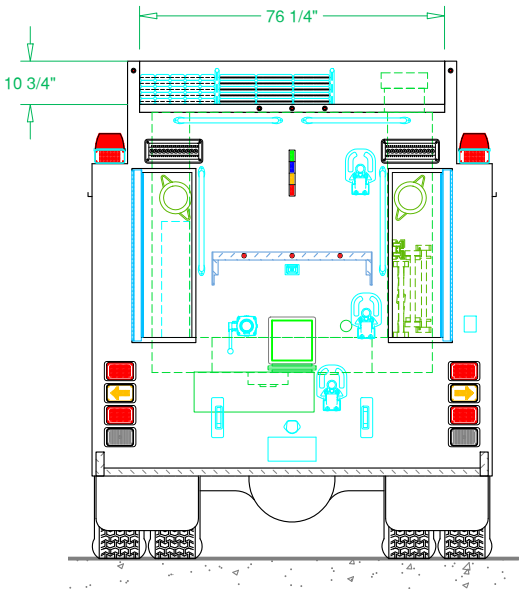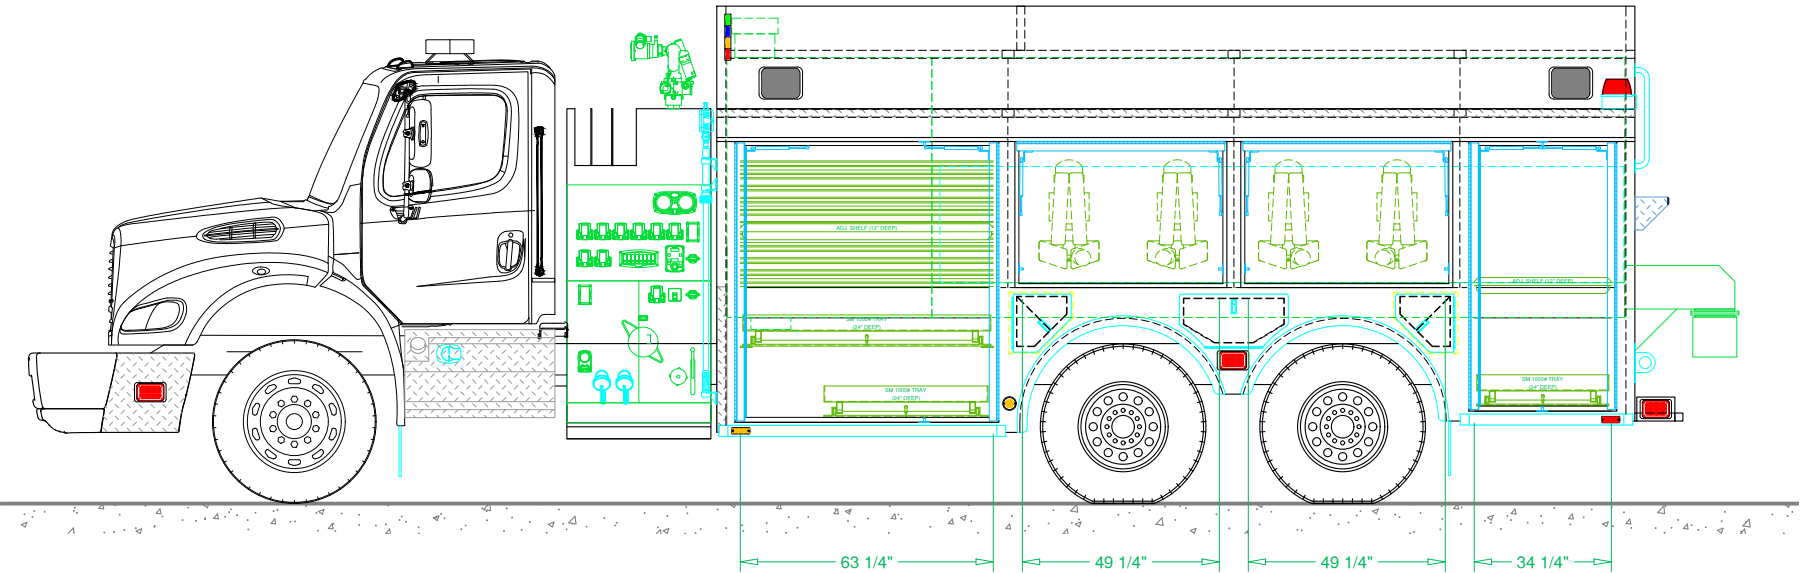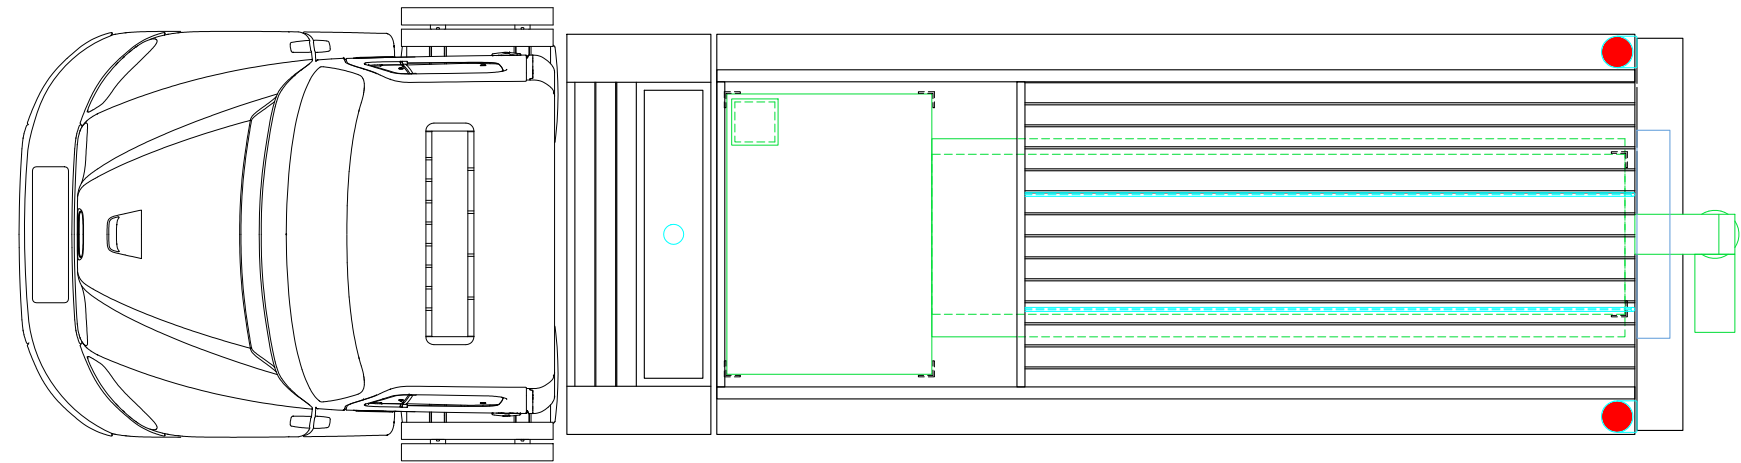

SVI FIRE & RESCUE TRUCKS
3842 REDMAN DRIVE, FORT COLLINS, CO 80524 PHONE 970-297-7100, FAX 970-297-7099

MELROSE
FIRE DEPARTMENT