

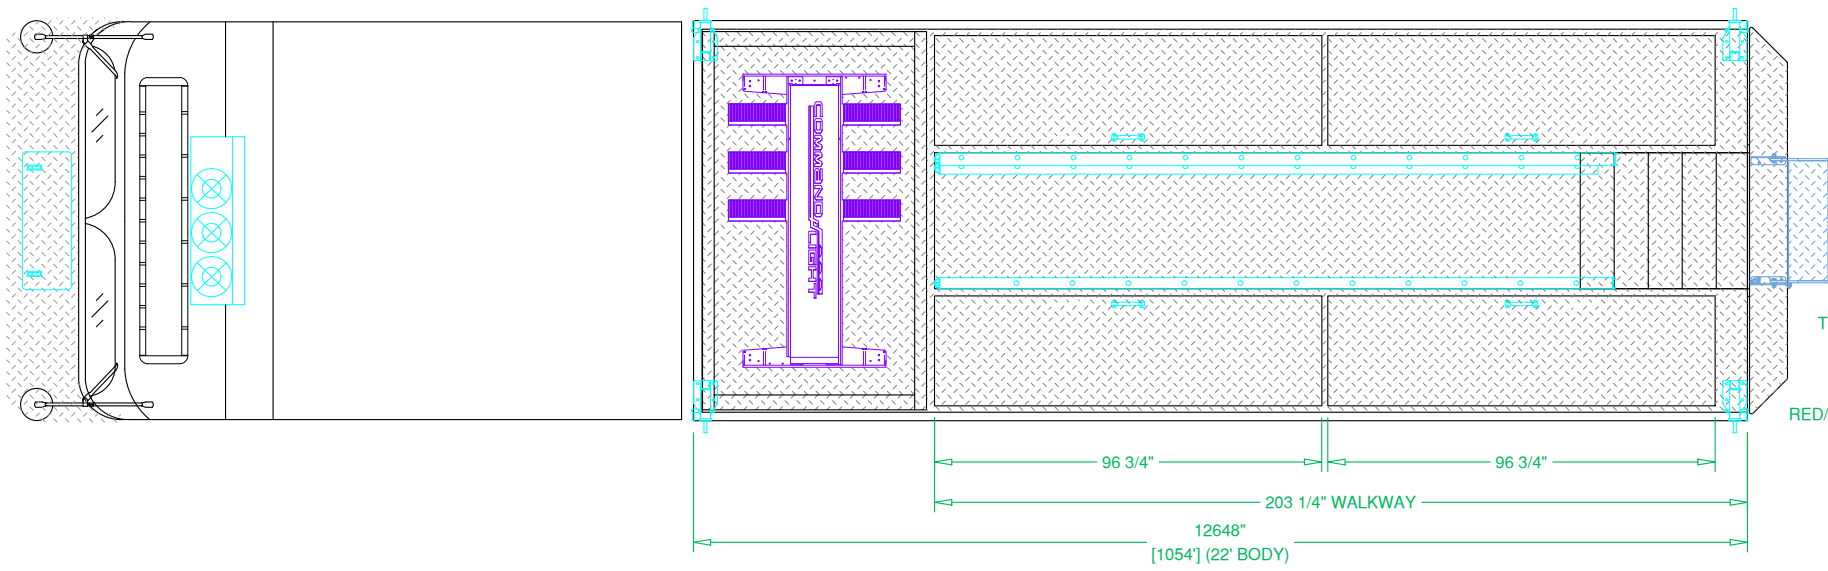
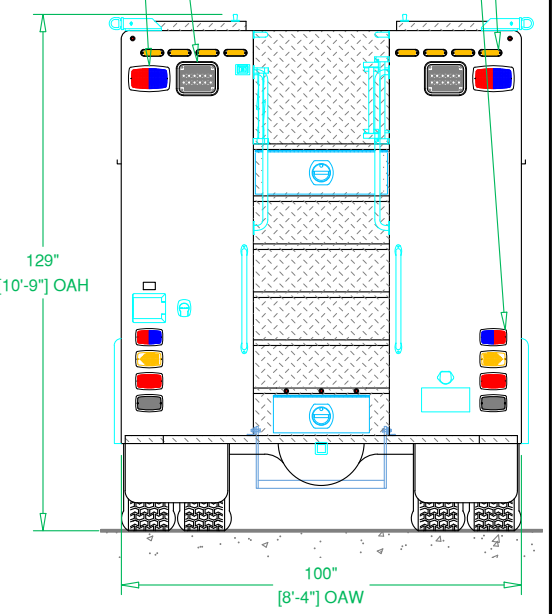


REVISIONS			
REV	DESCRIPTION	DATE	BY

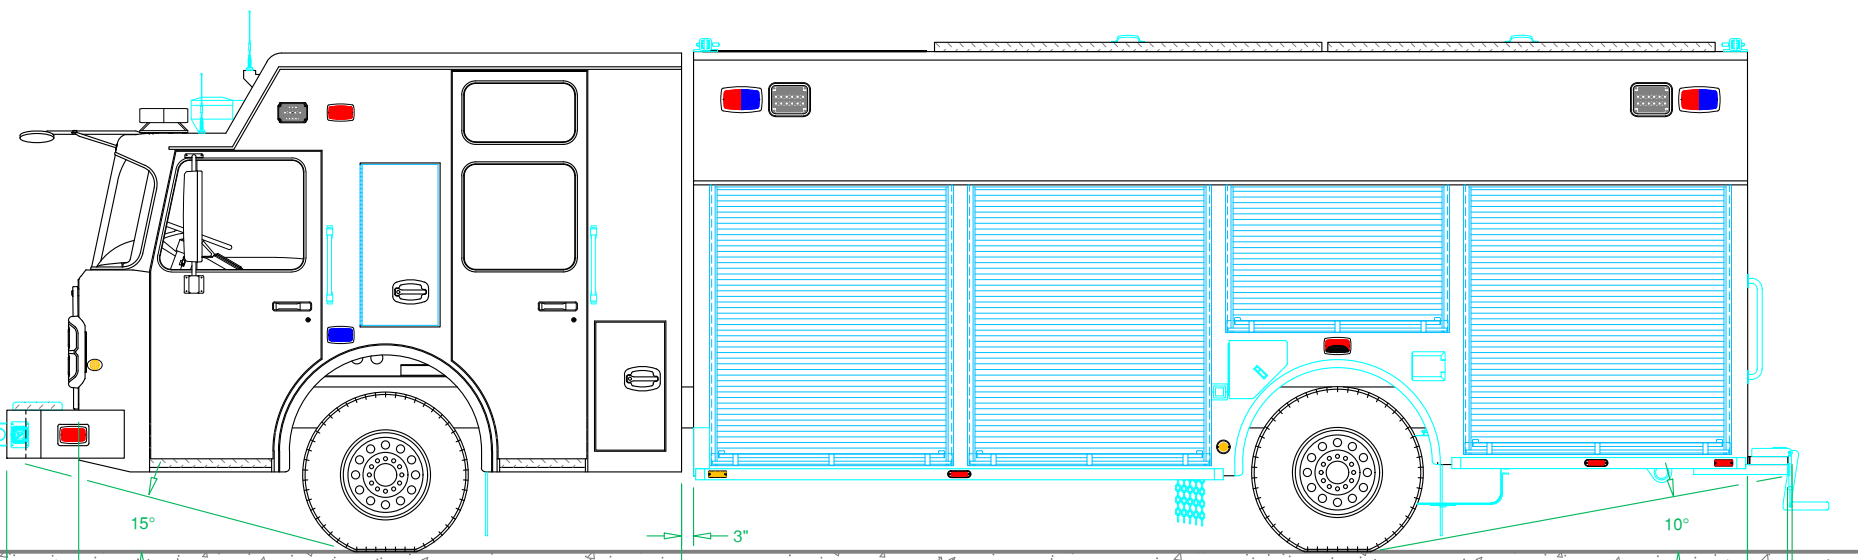

- TWO (2) HIZIV GUARDIAN SCENE - CHROME
- TWO (2) WHELEN M9 RED/BLUE LED - CHROME
- EIGHT (8) WHELEN ION AMBER LED - CHROME
- TWO (2) WHELEN M6 RED/BLUE LED - WARNING
- TWO (2) WHELEN M6 AMBER LED - TURN
- TWO (2) WHELEN M6 RED LED - BRAKE
- TWO (2) WHELEN M6 CLEAR LED - BACK-UP

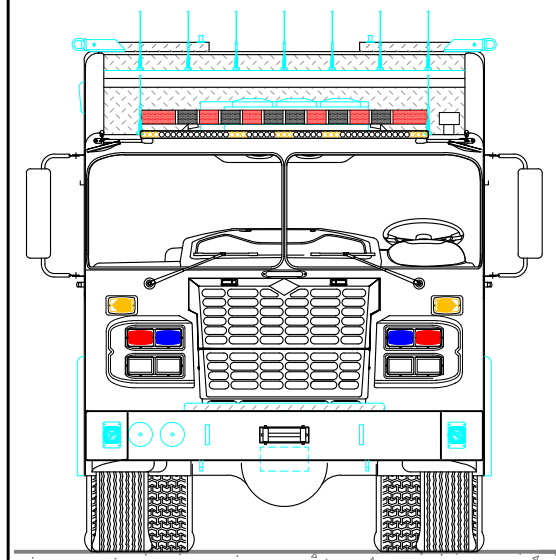

FOUR (4) HIZIV GUARDIAN SCENE - CHROME  
TWO (2) EACH SIDE

FOUR (4) WHELEN M9 RED/BLUE LED - CHROME  
TWO (2) EACH SIDE

FOUR (4) WHELEN M6 RED LED - CHROME  
TWO (2) EACH SIDE

FOUR (4) WHELEN ION RED LED - CHROME  
TWO (2) EACH SIDE

TWO (2) WHELEN M6 V-SERIES RED/SCENE LED - CHROME  
ONE (1) EACH SIDE

TWO (2) WHELEN M6 RED LED - CHROME  
ONE (1) EACH SIDE

**SVI**  
FORT COLLINS COLORADO





SVI FIRE & RESCUE TRUCKS  
3842 REDMAN DRIVE, FORT COLLINS, CO 80524 PHONE 970-297-7100, FAX 970-297-7099

**AUSTIN  
FIRE DEPARTMENT**

BODY SIZE: 22' BODY	UNIT TYPE: HEAVY RESCUE
BODY MATERIAL: 3/16" ALUMINUM	TRUCK NO: SVI #1202
CHASSIS TYPE: SPARTAN	WHEELBASE: 238"
GLADIATOR ELFD	CAB TO AXLE: 164"
20" RR	OVERALL LENGTH (OAL): 452"
FOUR DOOR	OVERALL WIDTH (OAW): 100"
	OVERALL HEIGHT (OAH): 130"

DRAWN BY: KP    DATE: October 13, 2022    SCALE: 1/4" = 1'-0"  
DRAWING NO: Austin TX hr AsBuilt    SHEET 1 OF 2

REVISIONS			
REV	DESCRIPTION	DATE	BY

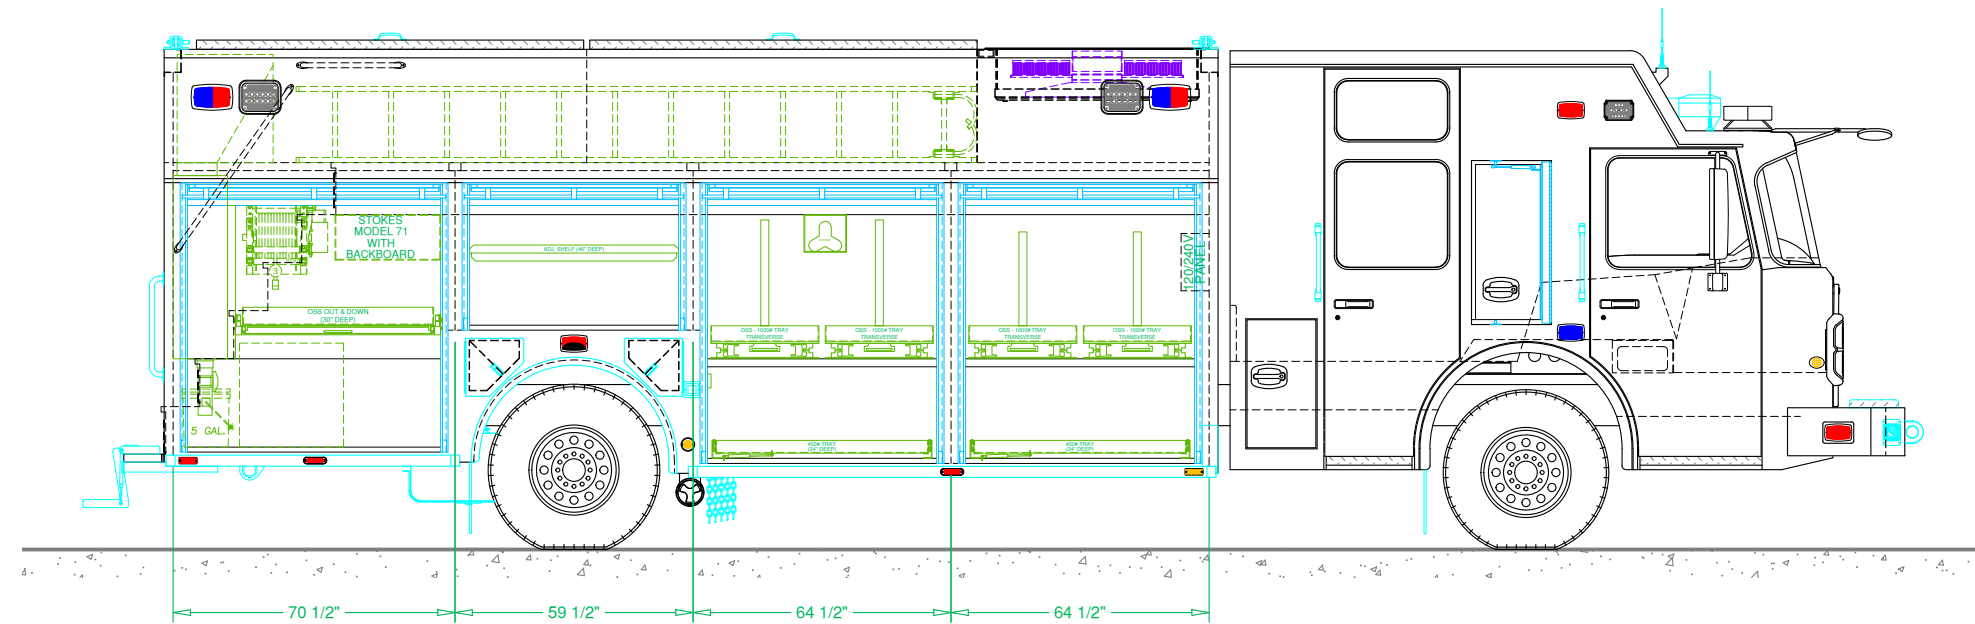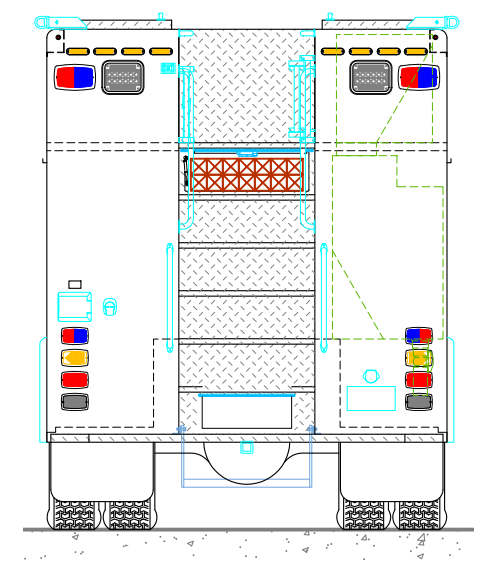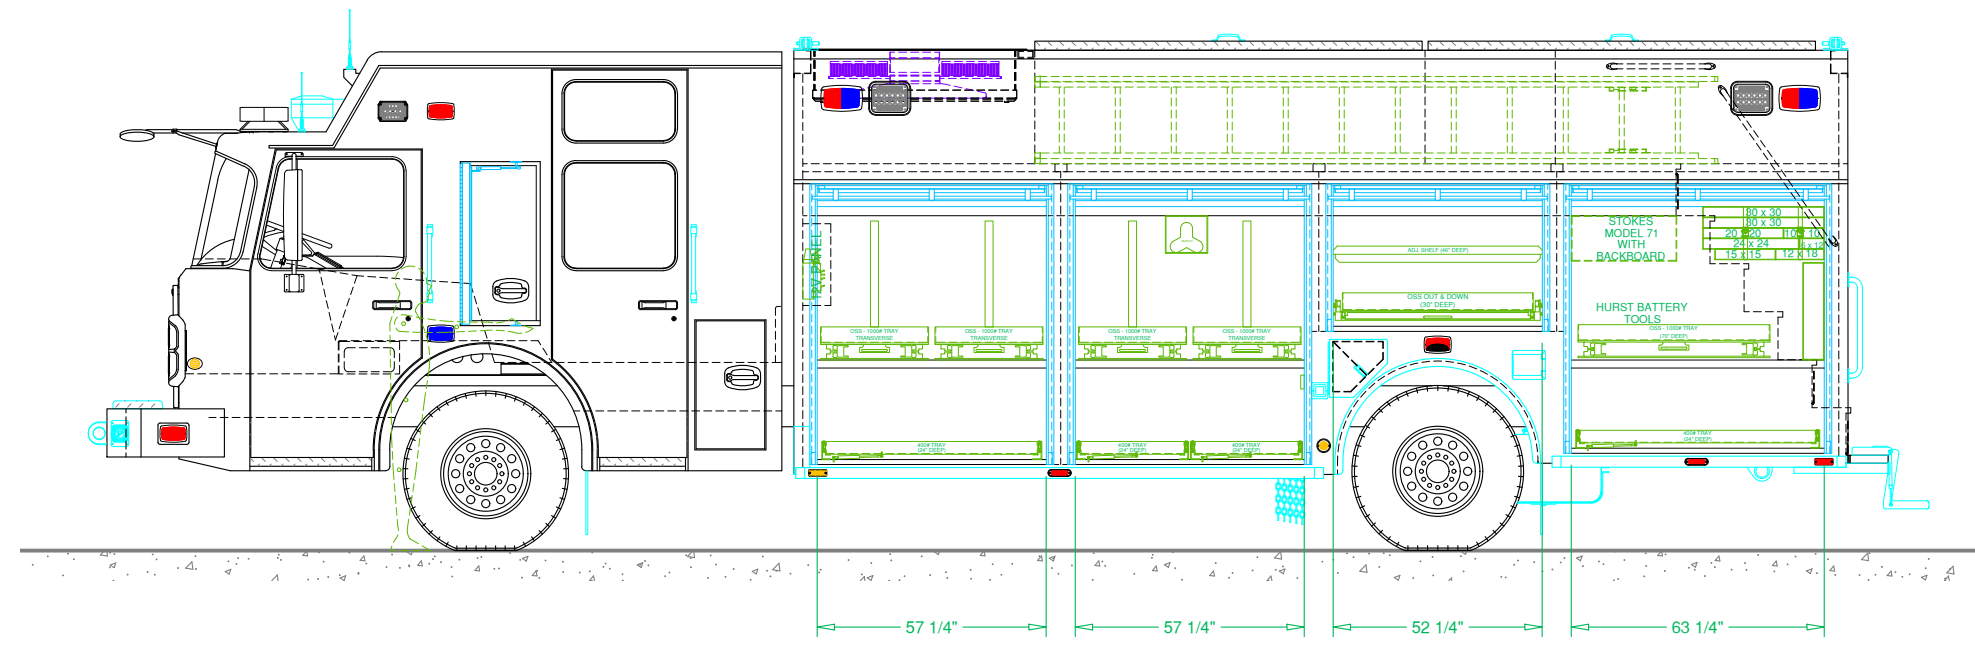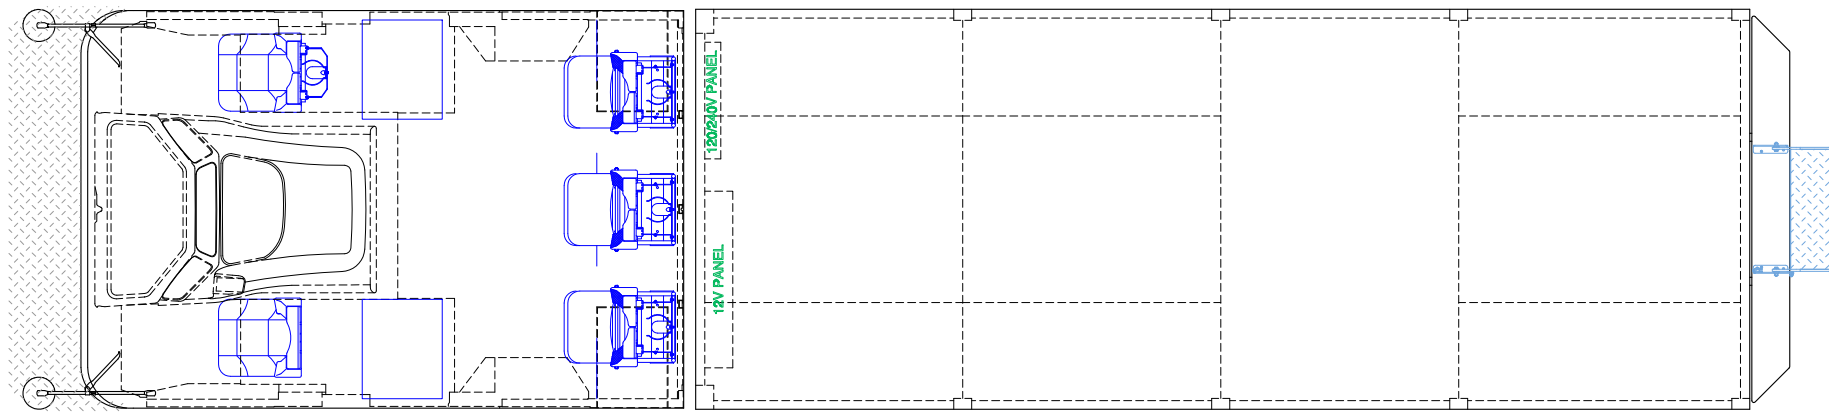



**SVI**

FORT COLLINS COLORADO

SVI FIRE & RESCUE TRUCKS  
3842 REDMAN DRIVE, FORT COLLINS, CO 80524 PHONE 970-297-7100, FAX 970-297-7099

**AUSTIN**  
**FIRE DEPARTMENT**

DRAWN BY: KP	DATE: Oct. 13, 22	SCALE: 1/4" = 1'-0"
DRAWING NO: Austin TX hr AsBuilt		SHEET 2 OF 2