



REVISIONS			
REV	DESCRIPTION	DATE	BY

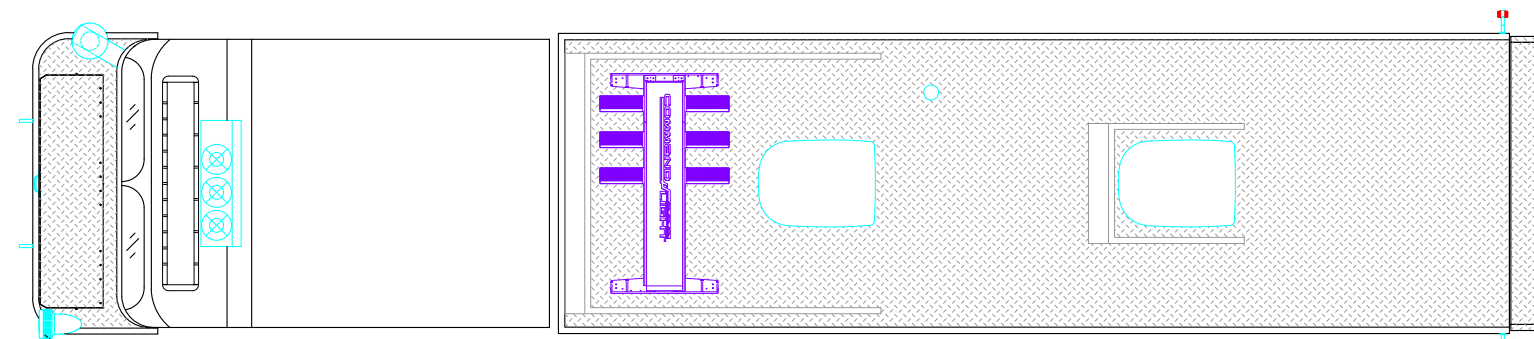

- TWO (2) WHELEN M9 RED LED - CHROME
- TWO (2) WHELEN PIONEER SCENE - CHROME
- VOYAGER BACKUP CAMERA
- TWO (2) WHELEN M6 RED LED - BRAKE
- TWO (2) WHELEN M6 AMBER LED - TURN
- TWO (2) WHELEN M6 RED LED - BRAKE
- TWO (2) WHELEN M6 CLEAR LED - BACK-UP

- TWO (2) DOMESTIC PENGUIN II HVAC
- COMMAND LIGHT CL602A-W2 6-LED LIGHT-TOWER
- WHELEN FN-72 72" LIGHT-BAR
- TWO (2) WHELEN PIONEER SCENE - CHROME BROW-LIGHT

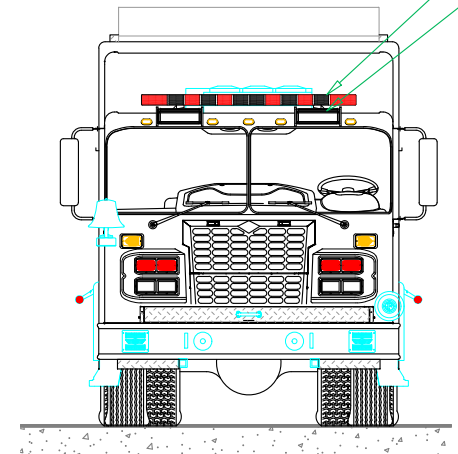

141"
[11'-9"] OAH

12°

28"

3"

190 1/2" CAB TO AXLE

258" WHEELBASE


507 3/4"

[42'-3 1/2"] OAL

129 1/2"


10°

10"

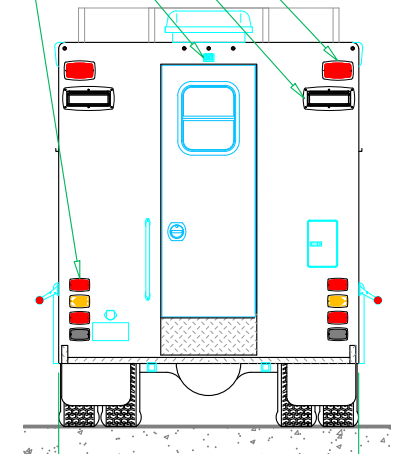

100"
[8'-4"] OAW

- SIX (6) WHELEN PIONEER SCENE - CHROME FOUR (4) EACH SIDE
- SIX (6) WHELEN PIONEER SCENE - CHROME FOUR (4) EACH SIDE
- SIX (6) WHELEN M6 RED LED - CHROME TWO (3) EACH SIDE
- TWO (2) WHELEN M6 V-SERIES LED - CHROME ONE (1) EACH SIDE




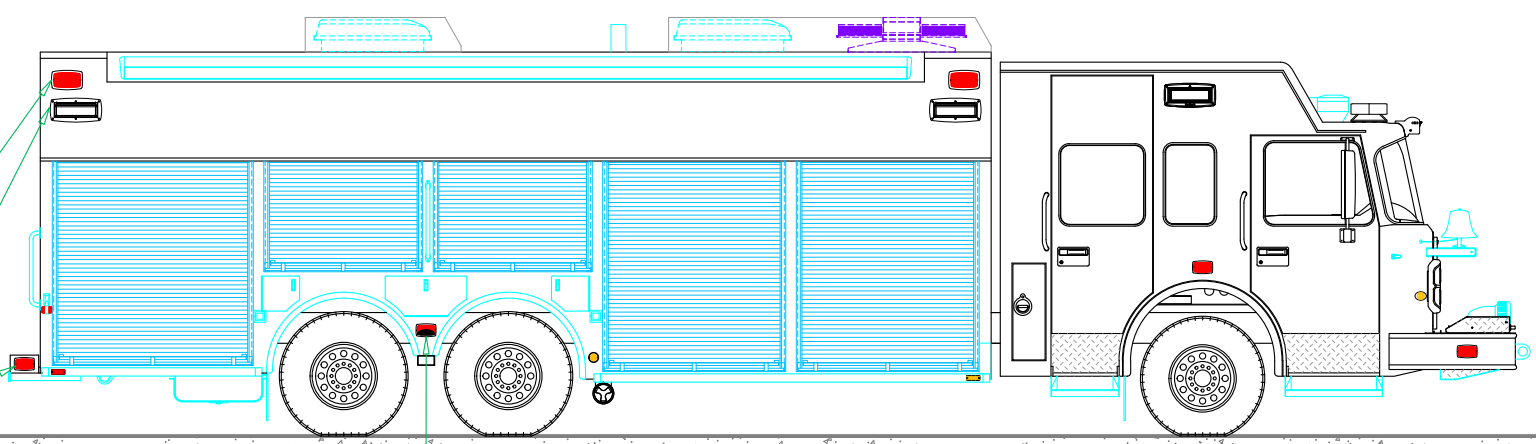



SVI FIRE & RESCUE TRUCKS
3842 REDMAN DRIVE, FORT COLLINS, CO 80524 PHONE 970-297-7100, FAX 970-297-7099

**CITY OF MIAMI
FIRE - RESCUE**

BODY SIZE: 26' BODY	UNIT TYPE: WALK-IN RESCUE
BODY MATERIAL: 3/16" ALUMINUM	TRUCK NO: SVI #1205
CHASSIS TYPE: SPARTAN	WHEELBASE: 258.00"
GLADIATOR - LFD	CAB TO AXLE: 190.50"
20" RR	OVERALL LENGTH (OAL): 508.00"
FOUR DOOR	OVERALL WIDTH (OAW): 100.00"
	OVERALL HEIGHT (OAH): 140.00"

REVISIONS			
REV	DESCRIPTION	DATE	BY

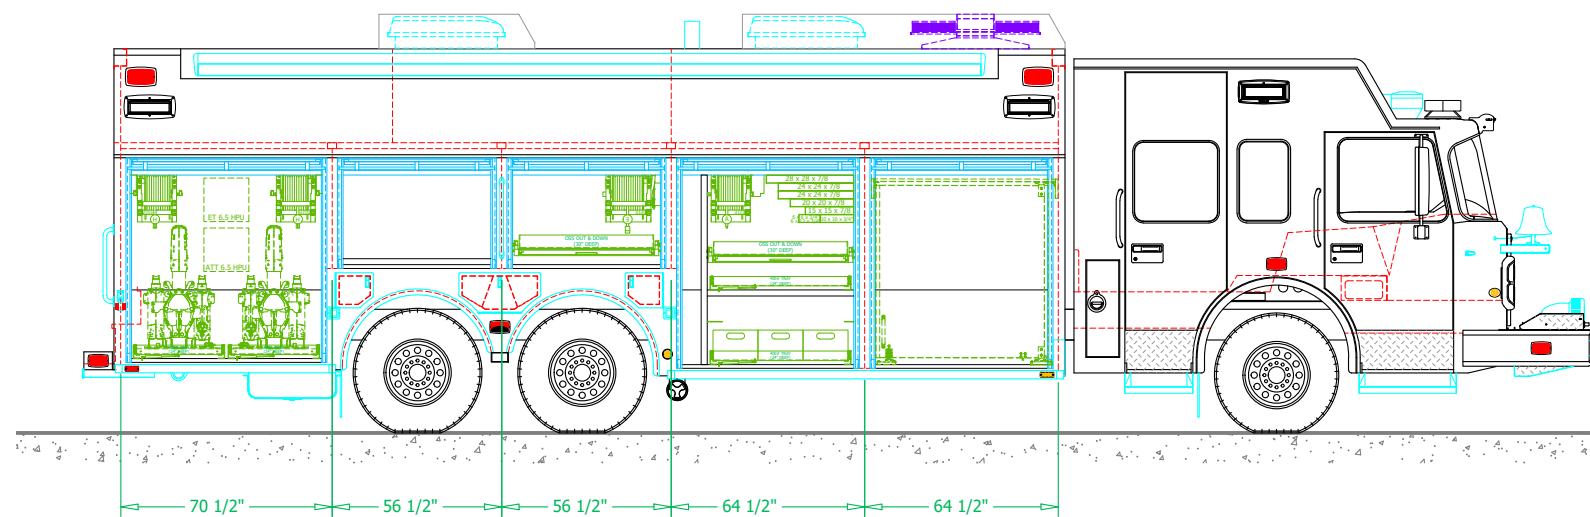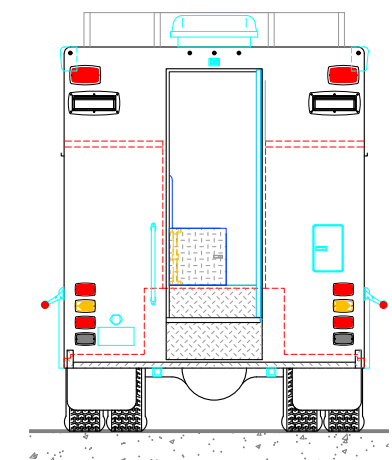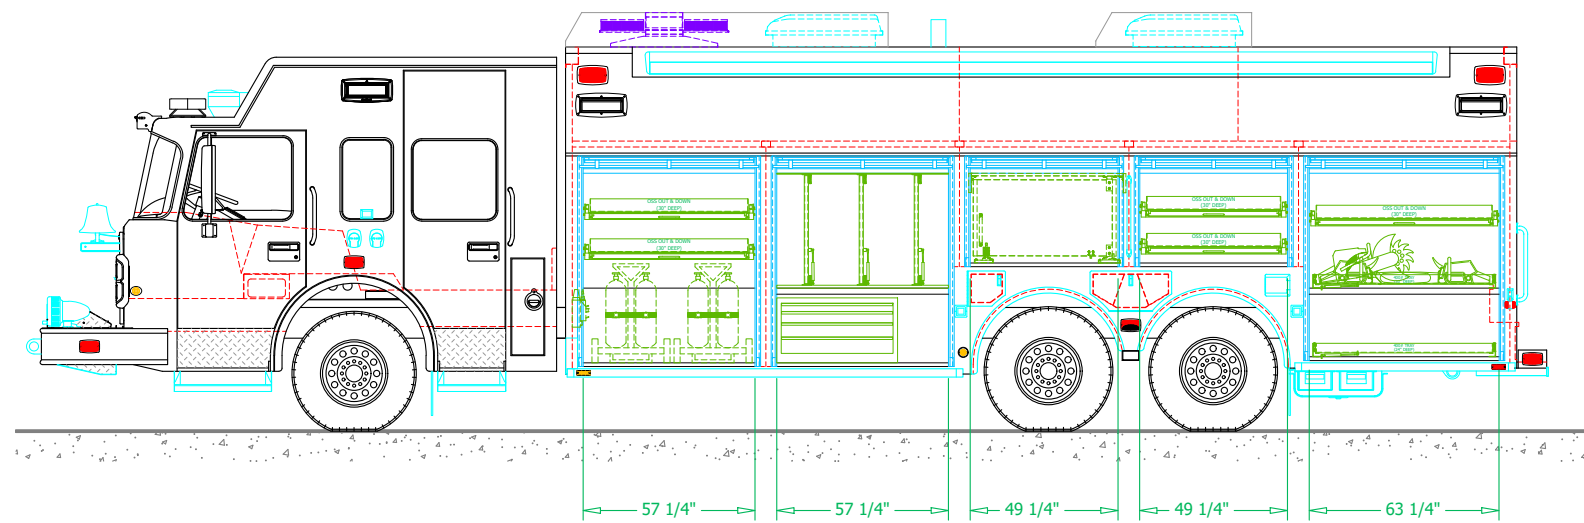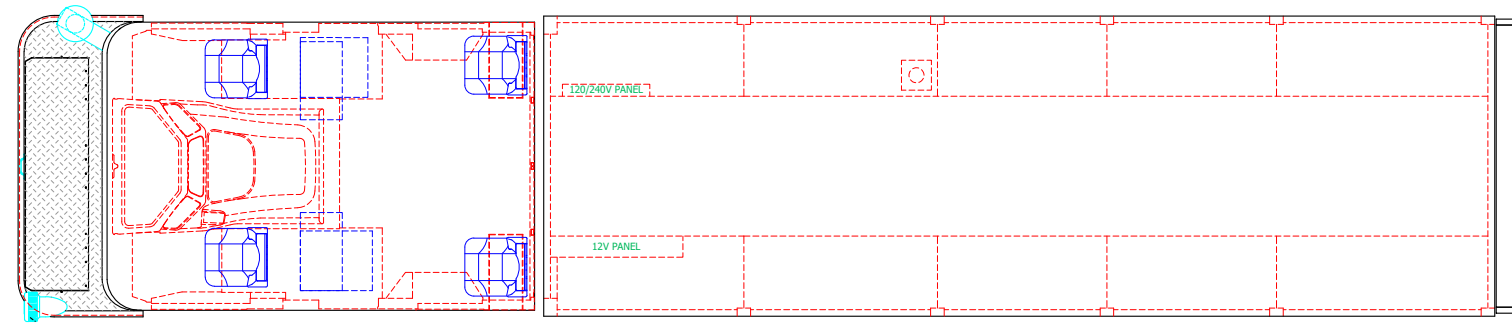




SVI FIRE & RESCUE TRUCKS
3842 REDMAN DRIVE, FORT COLLINS, CO 80524 PHONE 970-297-7100, FAX 970-297-7099

CITY OF MIAMI
FIRE - RESCUE


DRAWN BY: KP	DATE: December 14, 2022	SCALE: 1/4" = 1'-0"
DRAWING NO: CityofMiami FL Spartan HR AsBuilt		SHEET 2 OF 3

REVISIONS			
REV	DESCRIPTION	DATE	BY


PLAN VIEW
CROSS-SECTION

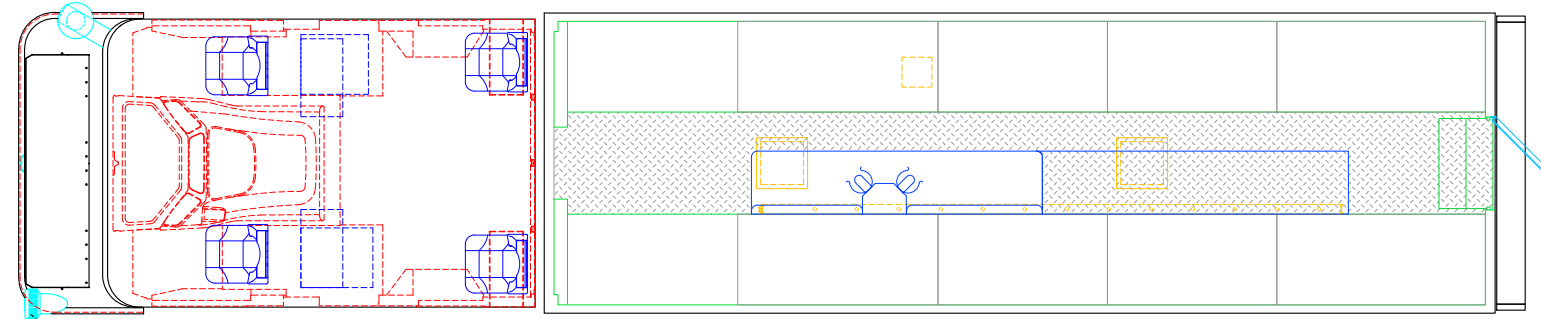


CURBSIDE INTERIOR
CROSS-SECTION

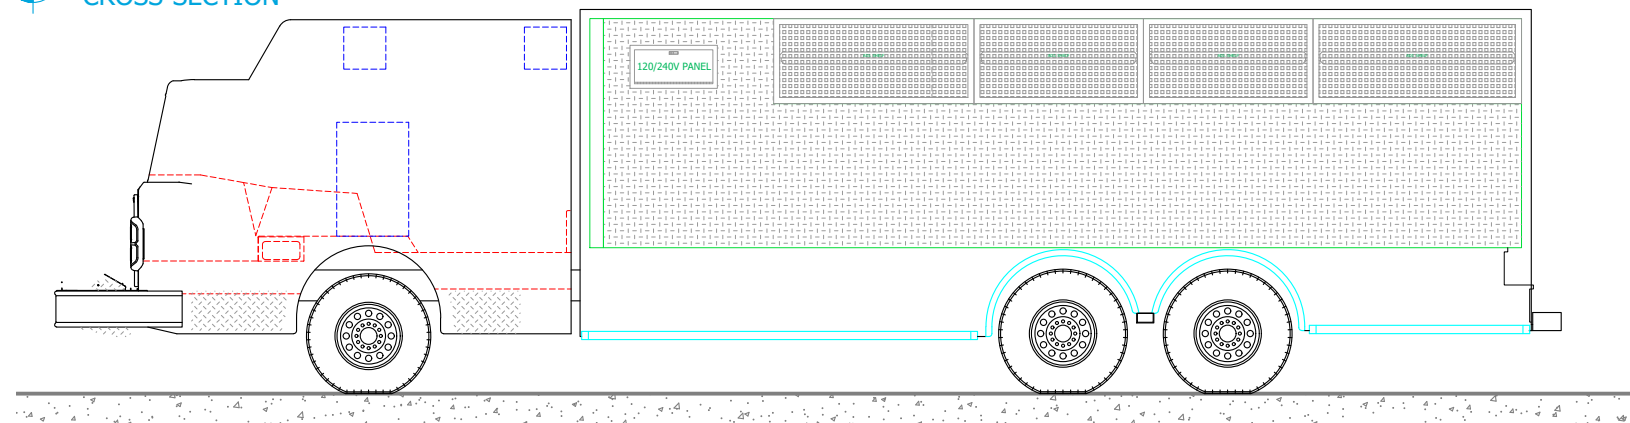


REAR VIEW
CROSS-SECTION

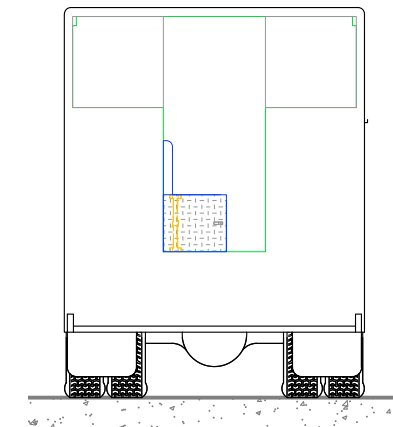

STREETSIDE INTERIOR
CROSS-SECTION

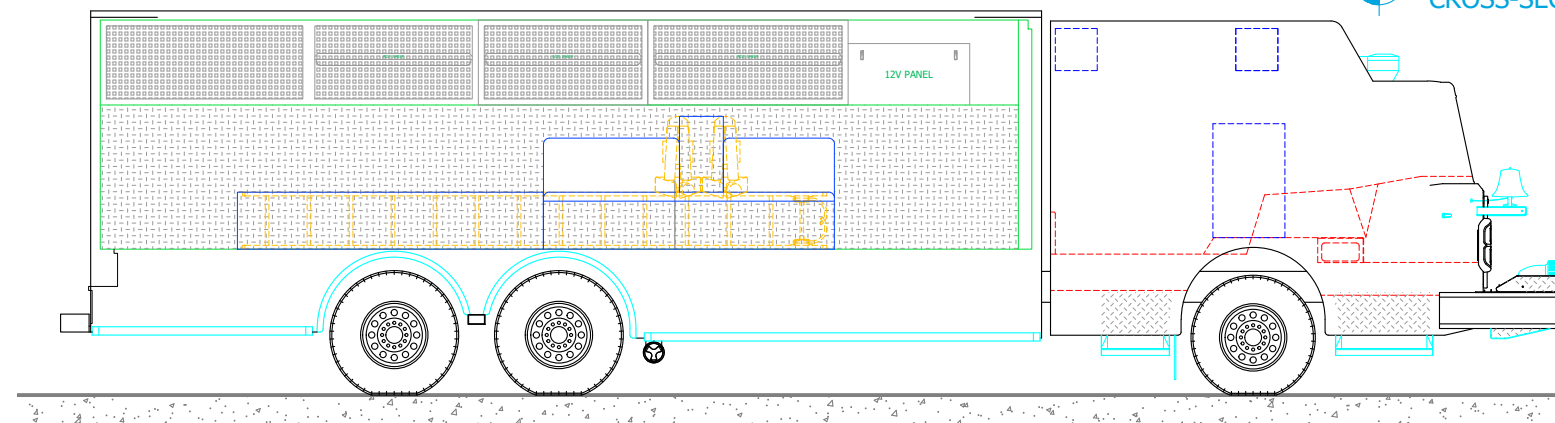



SVI FIRE & RESCUE TRUCKS
3842 REDMAN DRIVE, FORT COLLINS, CO 80524 PHONE 970-297-7100, FAX 970-297-7099

**CITY OF MIAMI
FIRE - RESCUE**

DRAWN BY: KP	DATE: December 14, 2022	SCALE: 1/4" = 1'-0"
DRAWING NO: CityofMiami FL Spartan HR AsBuilt		SHEET 3 OF 3