
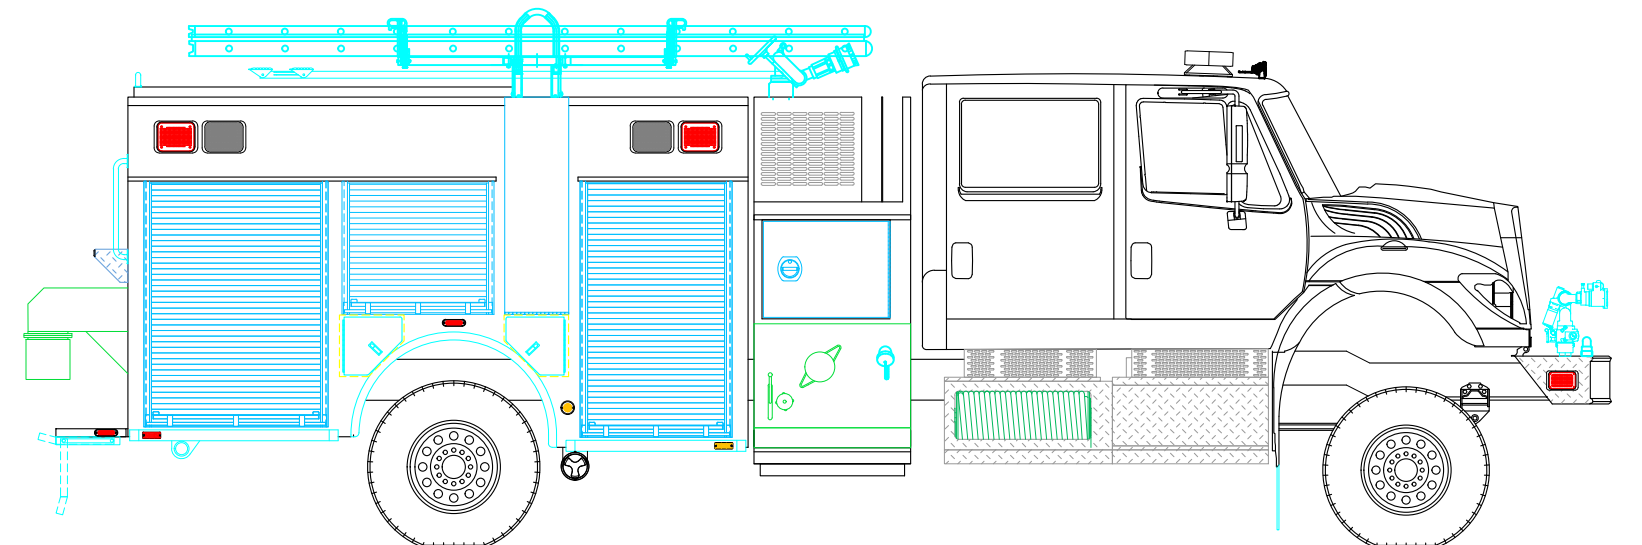
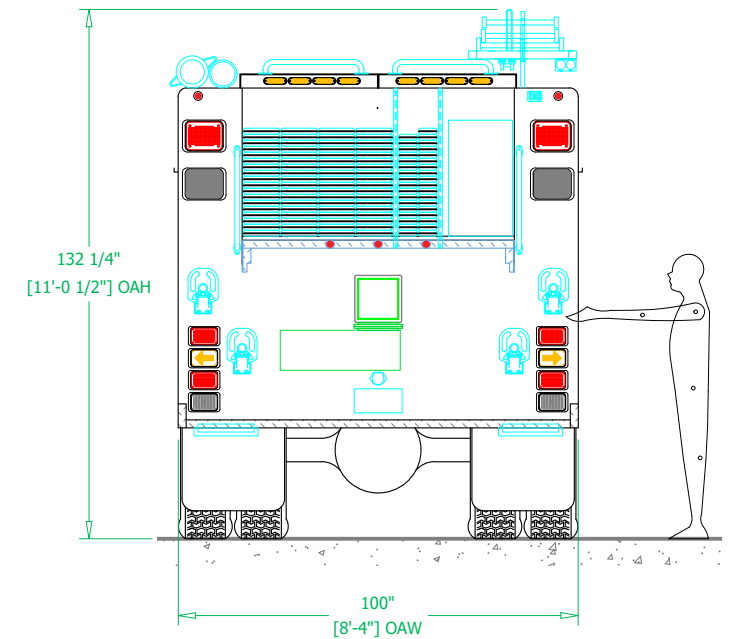
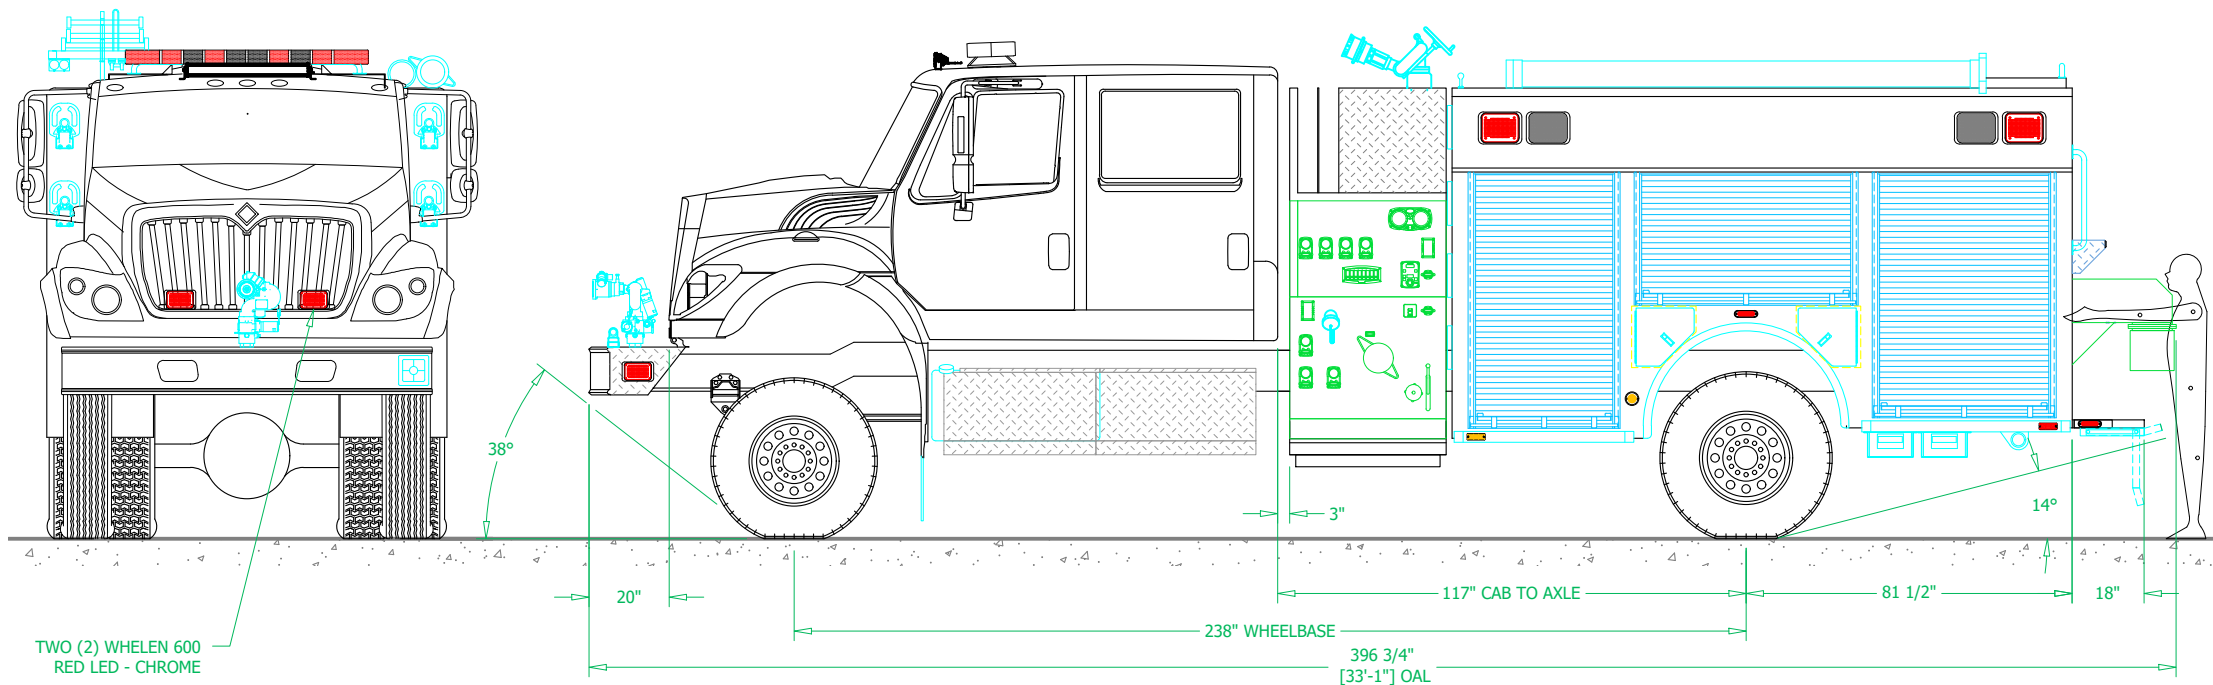


REVISIONS			
REV	DESCRIPTION	DATE	BY



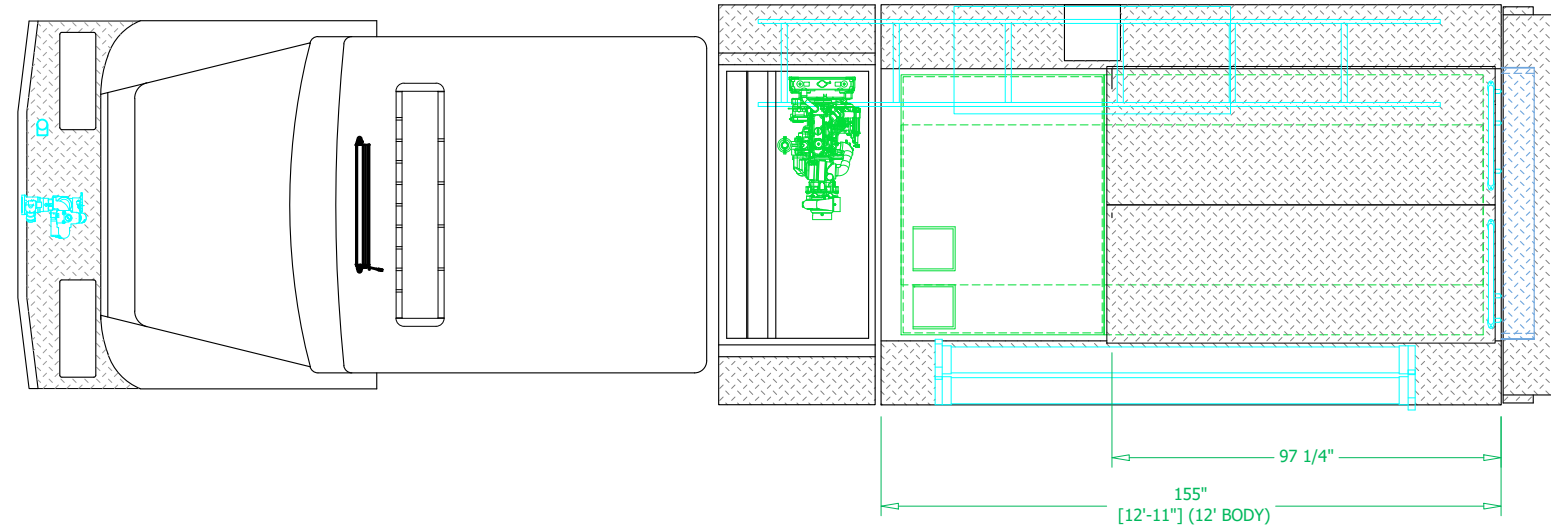


SVI FIRE & RESCUE TRUCKS  
3842 REDMAN DRIVE, FORT COLLINS, CO 80524 PHONE 970-297-7100, FAX 970-297-7099

### DEER TRAIL FIRE PROTECTION DISTRICT

BODY SIZE: 12' BODY	UNIT TYPE: RESCUE PUMPER
BODY MATERIAL: 3/16" ALUMINUM	TRUCK NO: SVI #1188
CHASSIS TYPE: INTERNATIONAL	WHEELBASE: 238"
HV	CAB TO AXLE: 117"
-	OVERALL LENGTH (OAL): 397"
FOUR DOOR	OVERALL WIDTH (OAW): 100"
	OVERALL HEIGHT (OAH): 132.5"

REVISIONS			
REV	DESCRIPTION	DATE	BY

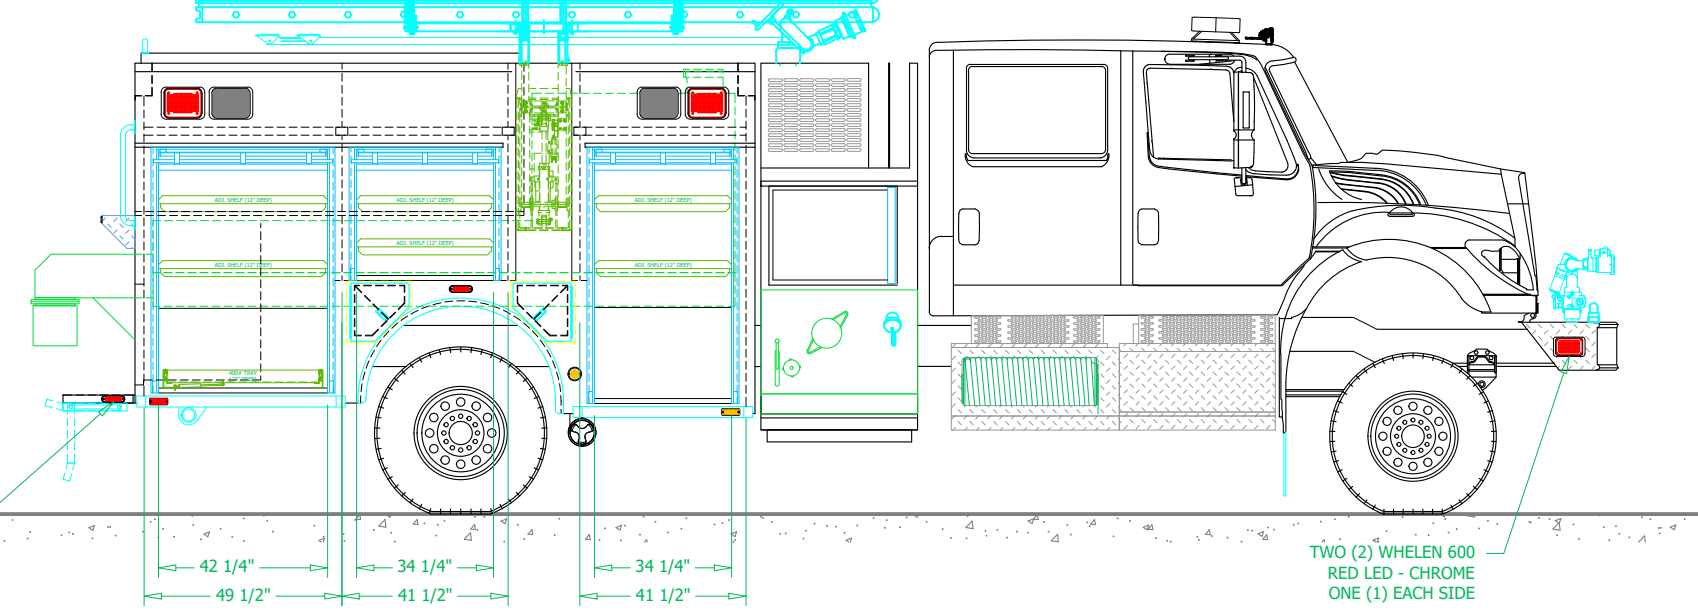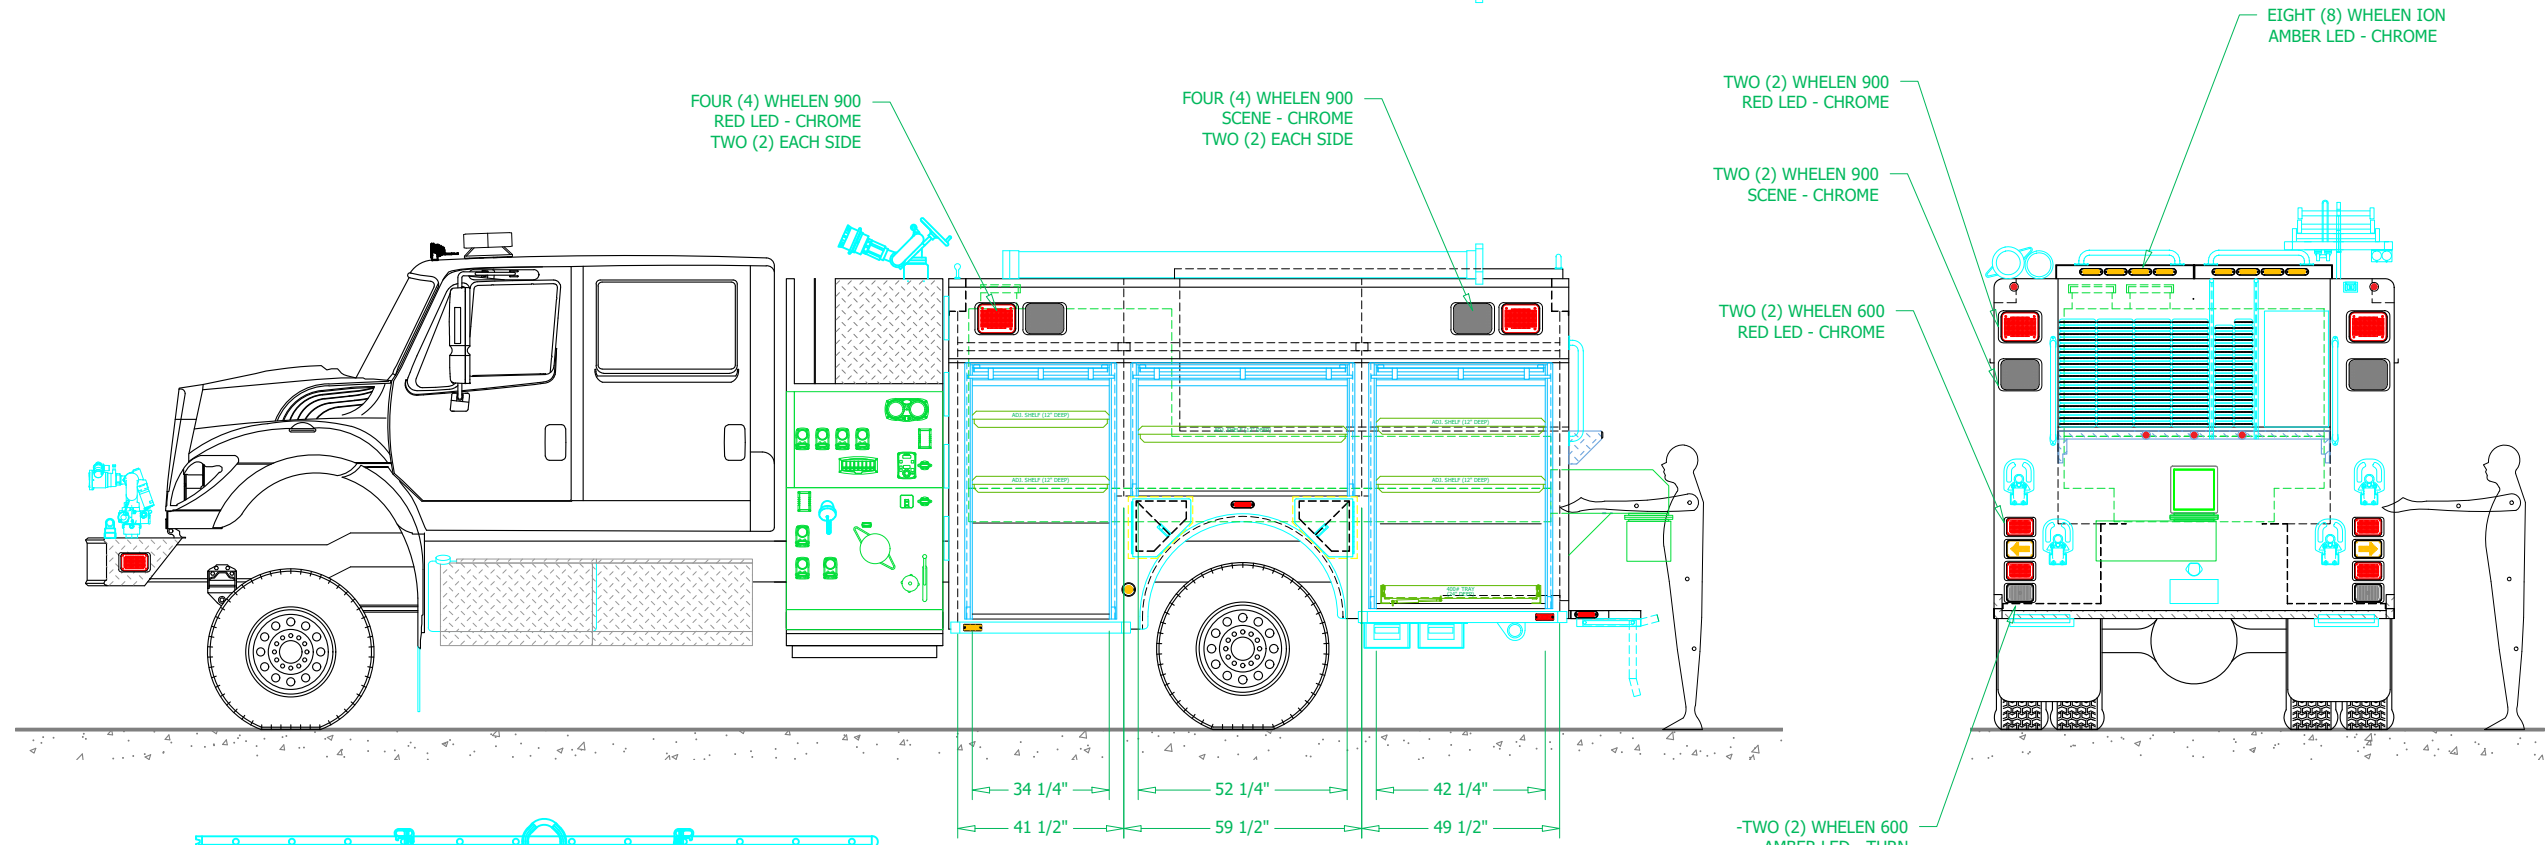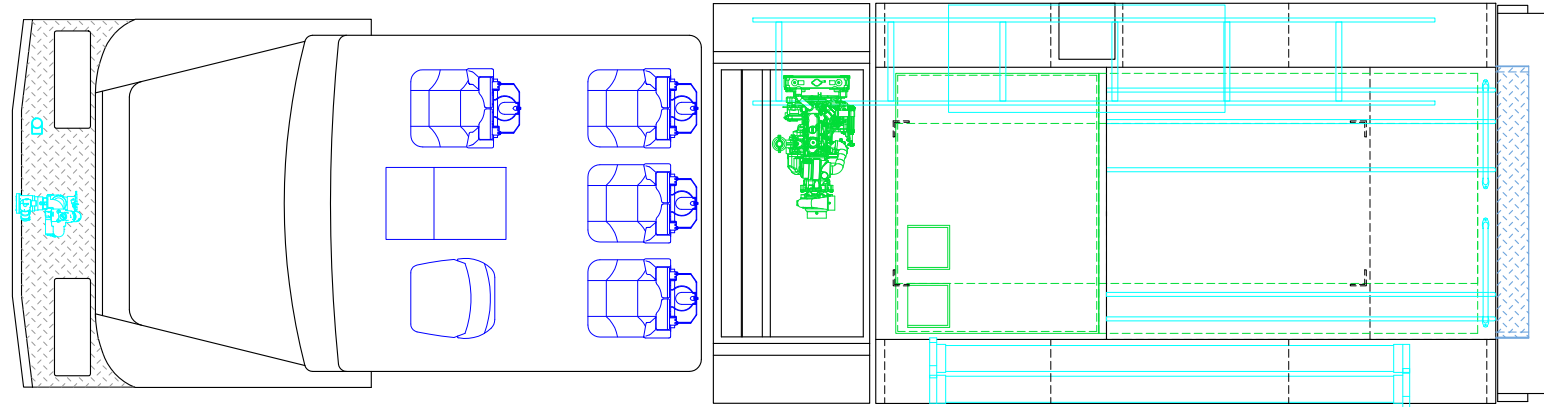

SVI FIRE & RESCUE TRUCKS  
3842 REDMAN DRIVE, FORT COLLINS, CO 80524 PHONE 970-297-7100, FAX 970-297-7099

**DEER TRAIL**  
**FIRE PROTECTION DISTRICT**

DRAWN BY: ----	DATE: Nov. 1, 22	SCALE: 1/4" = 1'-0"
DRAWING NO: DeerTrail CO pm AsBuilt	SHEET 2 OF 2	