



REVISIONS			
REV	DESCRIPTION	DATE	BY

OPTICOM
WHELEN FN-72
LIGHT-BAR
HIVIZ FT-B-72-ML
LED VISOR LIGHT

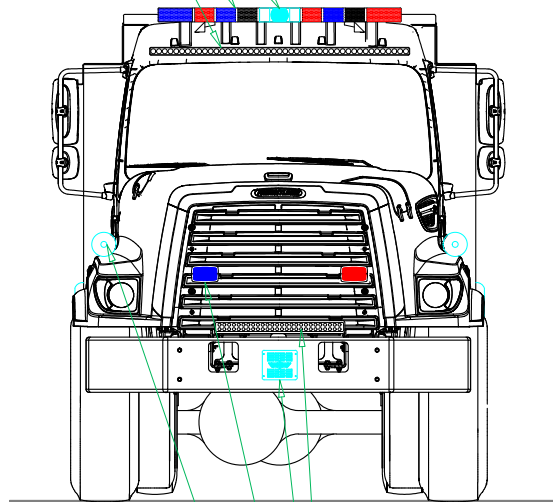

131"
[10'-11"] OAH

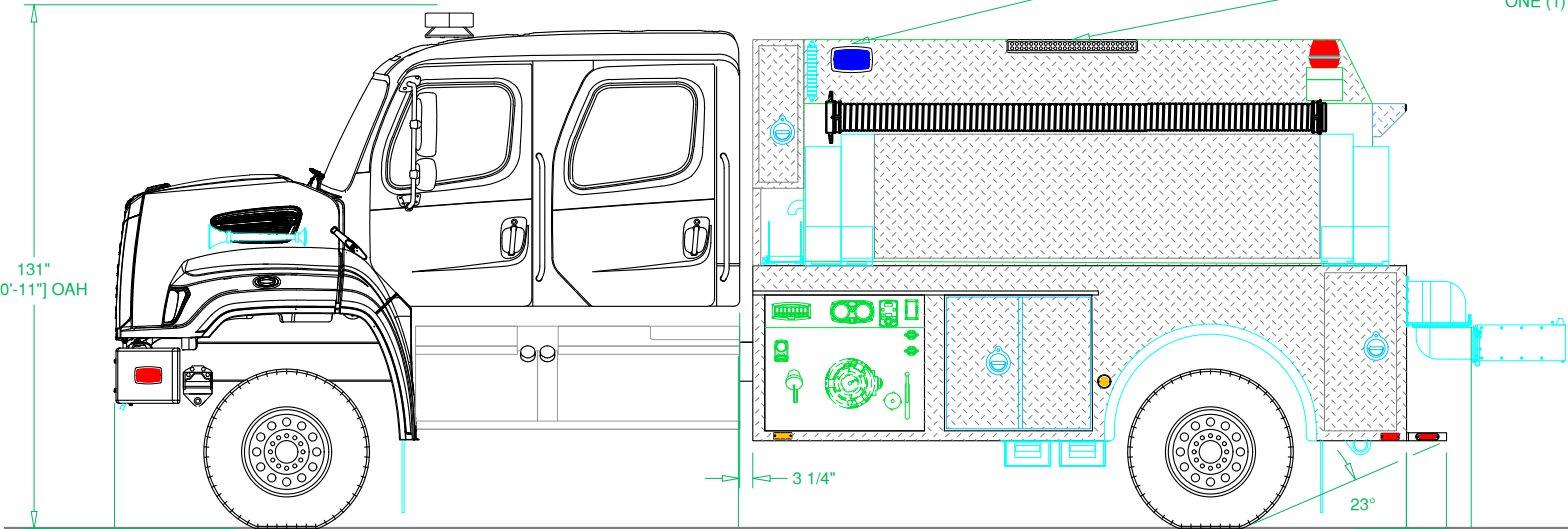

3 1/4"

231" WHEELBASE

339 1/4"
[28'-3"] OAL

118" CAB TO AXLE

49"

10"

-TWO (2) WHELEN M6
RED LED (CS) - WARNING
BLUE LED (SS) - WARNING

-TWO (2) WHELEN M6
AMBER LED - TURN

-TWO (2) WHELEN M6
RED LED - BRAKE

-TWO (2) WHELEN M6
CLEAR LED - BACK-UP


BOOSTER HOSE REEL

TWO (2) WHELEN M6
RED LED - CHROME
ONE (1) EACH SIDE

2000 GALLON WATER TANK
ONE (1) RIGID 30" LED
SPOT/FLOOD LIGHT - CHROME

TWO (2) WHELEN M9
BLUE LED - CHROME
ONE (1) EACH SIDE

TWO (2) RIGID 30" LED
SPOT/FLOOD LIGHT - CHROME
ONE (1) EACH SIDE

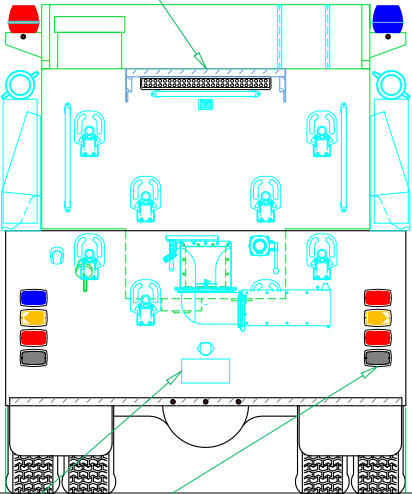

LED LICENSE
PLATE BRACKET

100"
[8'-4"] OAW

ONE (1) RIGID 30" LED
SPOT/FLOOD LIGHT - CHROME


SVI SPEAKER

TWO (2) WHELEN M6
RED LED - SS
BLUE LED - CS

TWO (2) AIR-HORNS

TWO (2) WHELEN L31
RED LED - SS
BLUE LED - CS

TWO (2) WHELEN ION
RED LED - CHROME
ONE (1) EACH SIDE

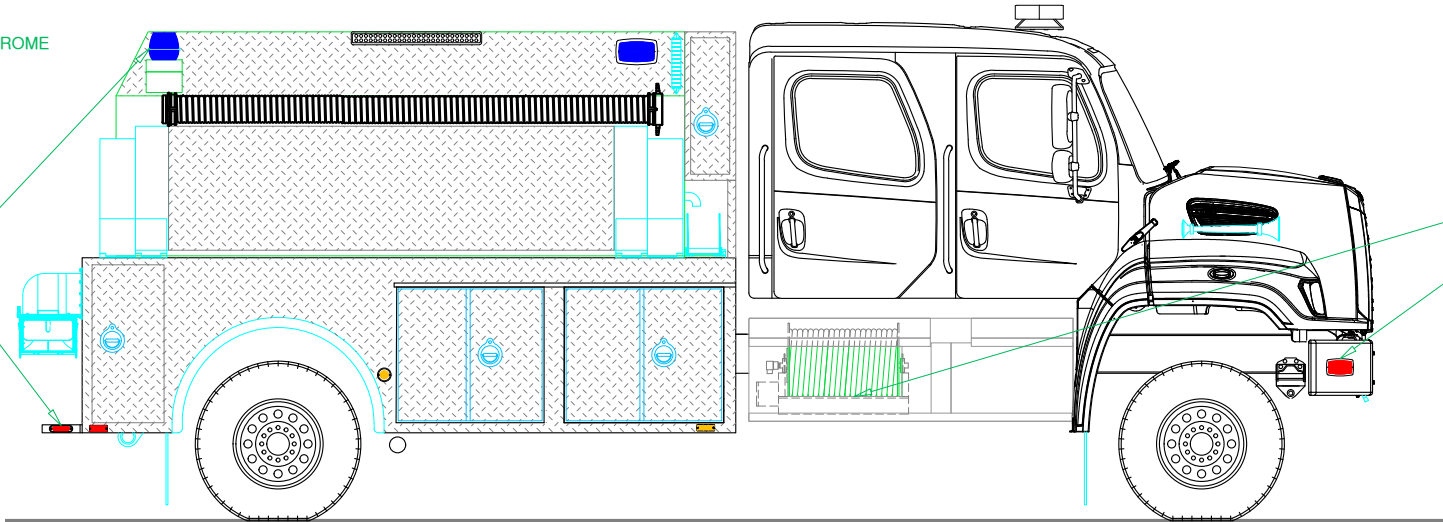





SVI FIRE & RESCUE TRUCKS
3842 REDMAN DRIVE, FORT COLLINS, CO 80524 PHONE 970-297-7100, FAX 970-297-7099

WEST METRO FIRE DEPARTMENT

BODY SIZE: 14' BODY	UNIT TYPE: TANKER
BODY MATERIAL: 3/16" ALUMINUM	TRUCK NO: SVI #1194
CHASSIS TYPE: FREIGHTLINER	WHEELBASE: 231.00"
SD108	CAB TO AXLE: 118.00"
-	OVERALL LENGTH (OAL): 340.00"
FOUR DOOR	OVERALL WIDTH (OAW): 100.00"
	OVERALL HEIGHT (OAH): 131.00"

DRAWN BY: KP	DATE: December 2, 2022	SCALE: 1/4" = 1'-0"
DRAWING NO: WestMetro_CO_TK_AsBuilt		SHEET 1 OF 2

REVISIONS			
REV	DESCRIPTION	DATE	BY

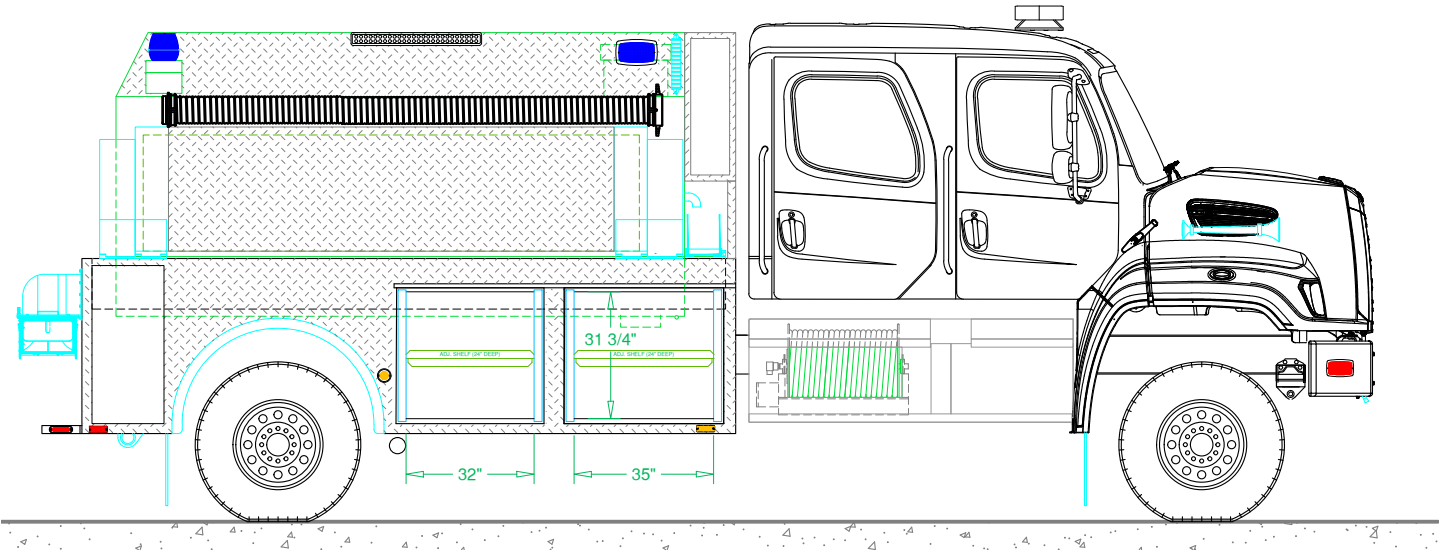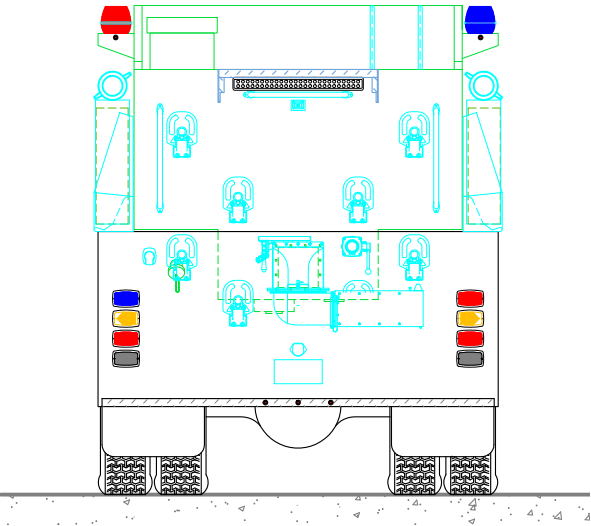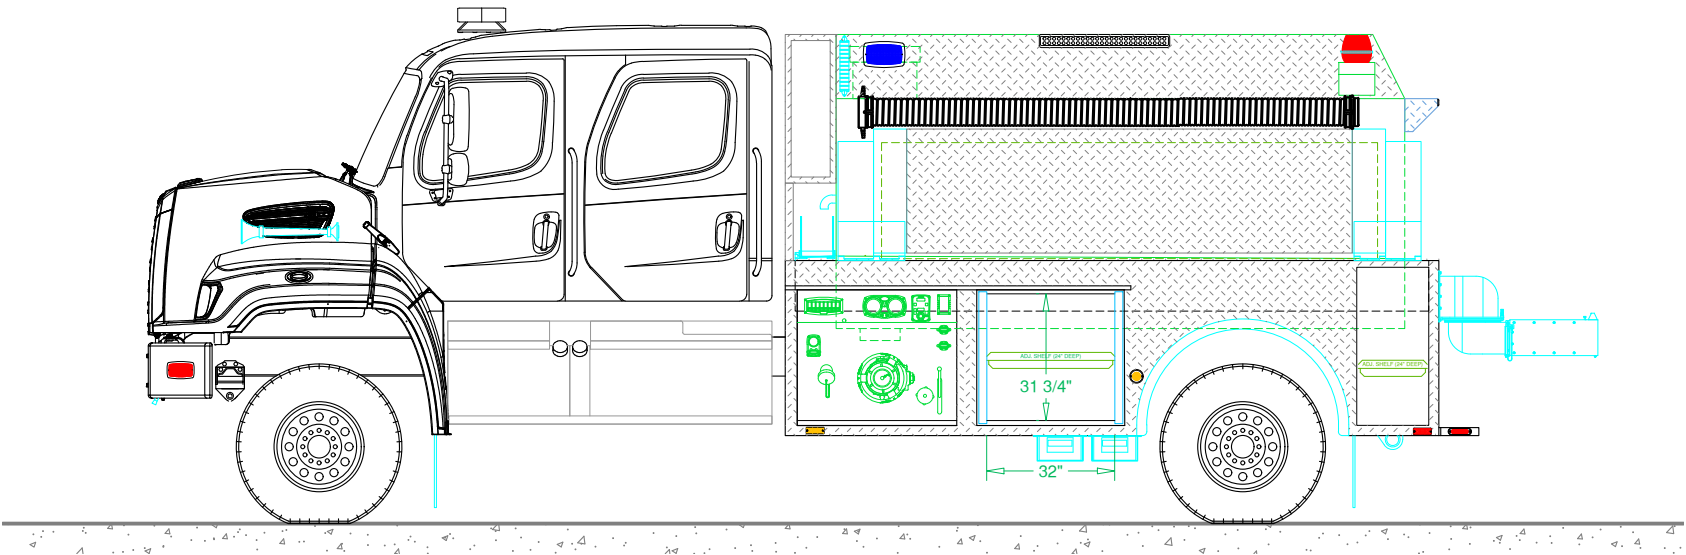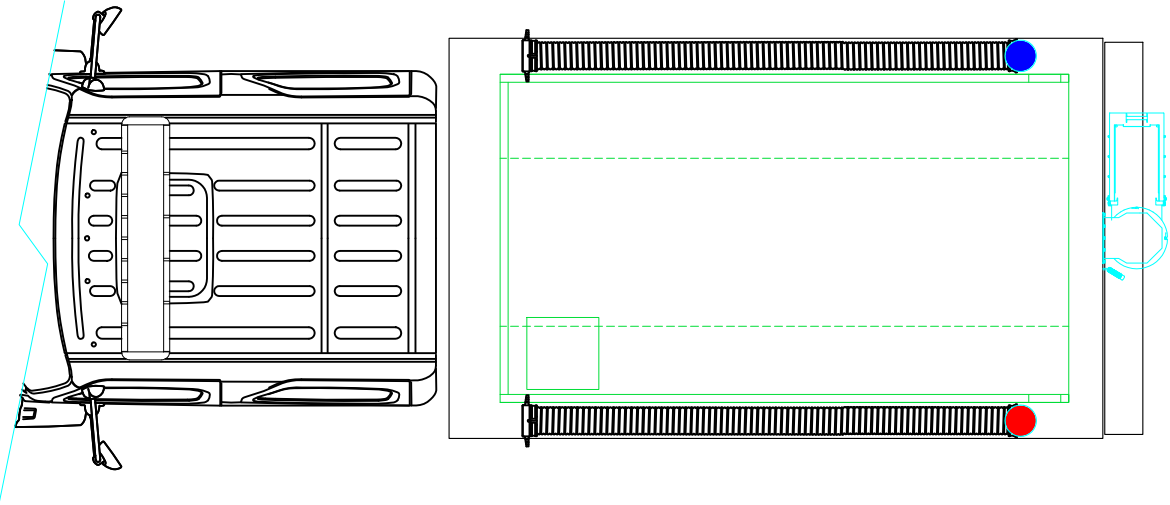



SVI FIRE & RESCUE TRUCKS
3842 REDMAN DRIVE, FORT COLLINS, CO 80524 PHONE 970-297-7100, FAX 970-297-7099

**WEST METRO
FIRE DEPARTMENT**

DRAWN BY: KP
DATE: Dec. 2, 22
SCALE: 1/4" = 1'-0"

DRAWING NO: WestMetro_CO_TK_AsBuilt
SHEET 2 OF 2