


REVISIONS			
REV	DESCRIPTION	DATE	BY



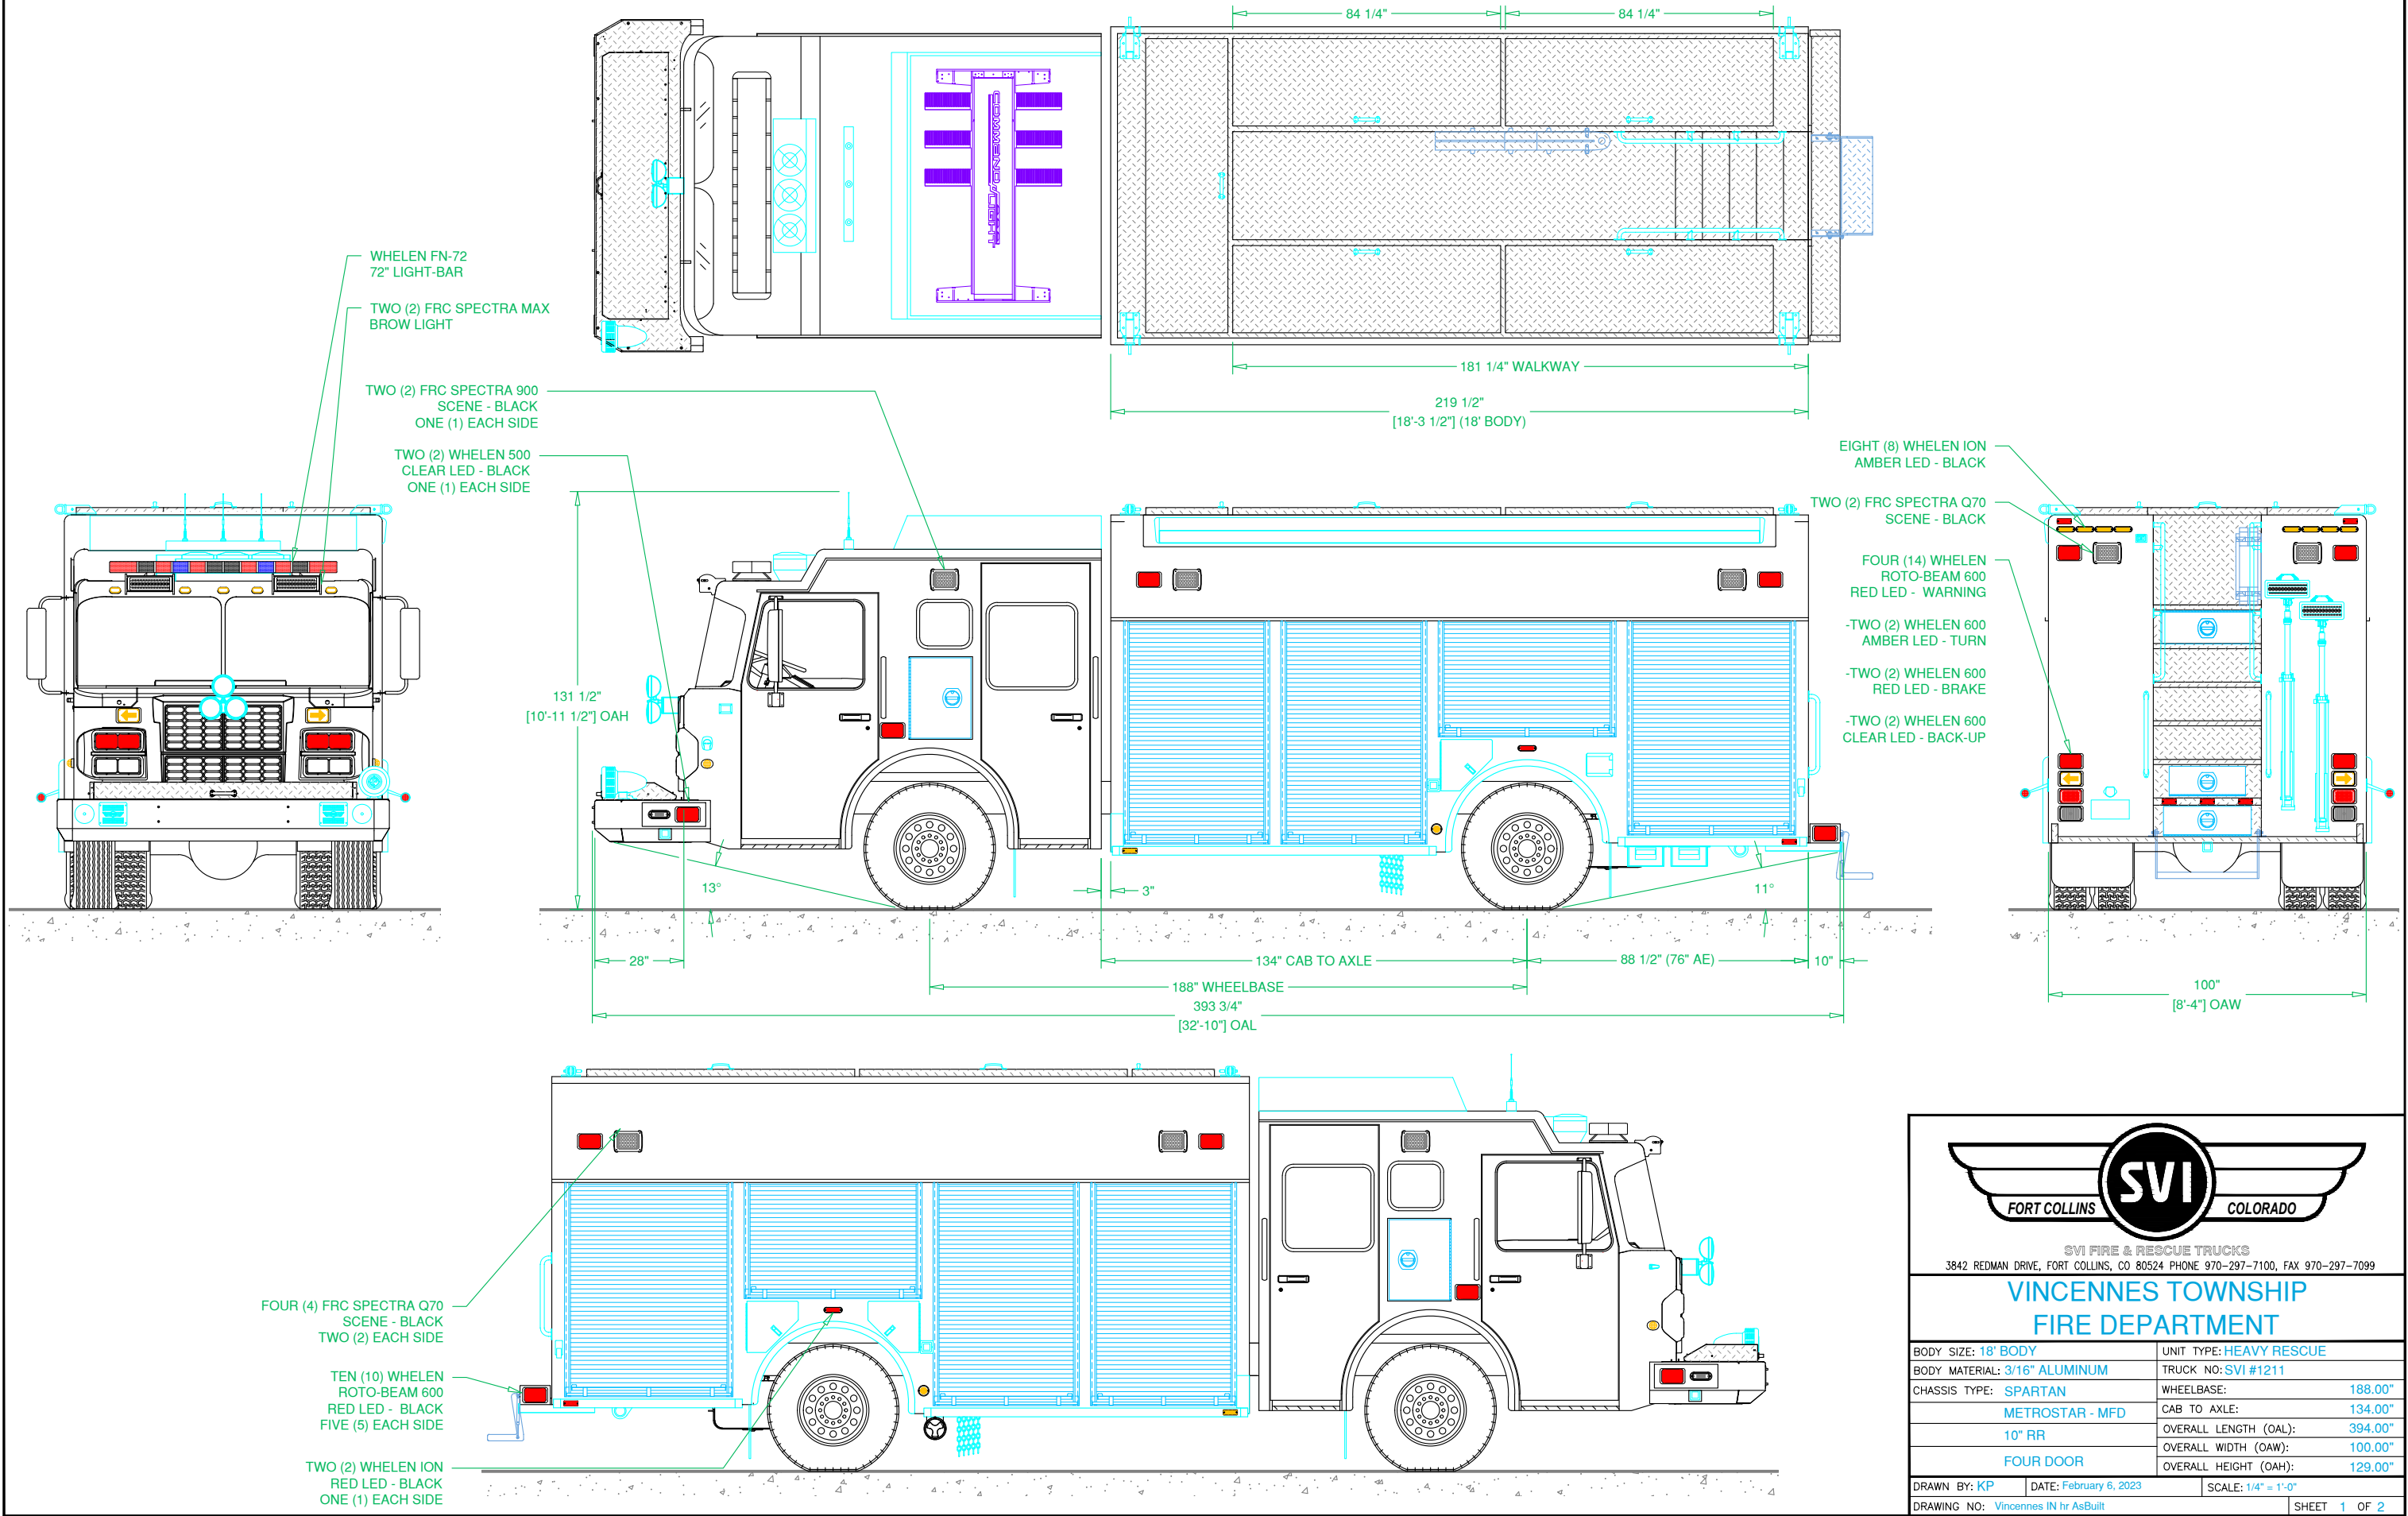

SVI
FORT COLLINS COLORADO

SVI FIRE & RESCUE TRUCKS

3842 REDMAN DRIVE, FORT COLLINS, CO 80524 PHONE 970-297-7100, FAX 970-297-7099





**VINCENNES TOWNSHIP
FIRE DEPARTMENT**

BODY SIZE: 18' BODY	UNIT TYPE: HEAVY RESCUE
BODY MATERIAL: 3/16" ALUMINUM	TRUCK NO: SVI #1211
CHASSIS TYPE: SPARTAN	WHEELBASE: 188.00"
METROSTAR - MFD	CAB TO AXLE: 134.00"
10" RR	OVERALL LENGTH (OAL): 394.00"
FOUR DOOR	OVERALL WIDTH (OAW): 100.00"
	OVERALL HEIGHT (OAH): 129.00"

DRAWN BY: KP
 DATE: February 6, 2023
 SCALE: 1/4" = 1'-0"

DRAWING NO: Vincennes IN hr AsBuilt
 SHEET 1 OF 2

REVISIONS			
REV	DESCRIPTION	DATE	BY

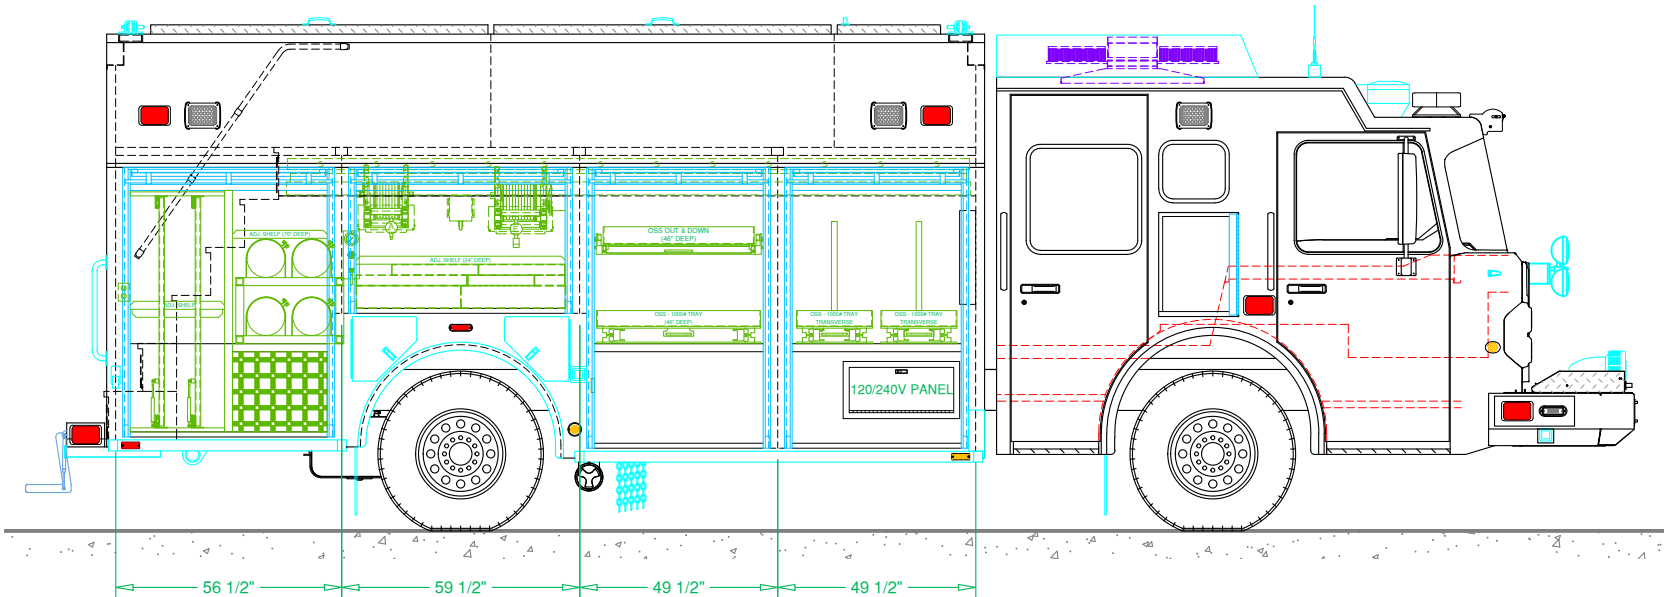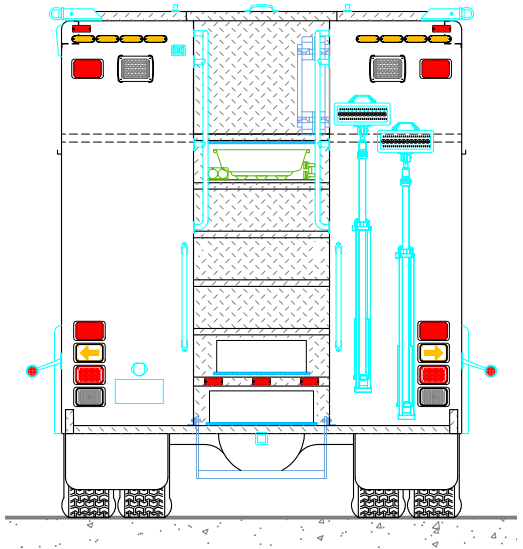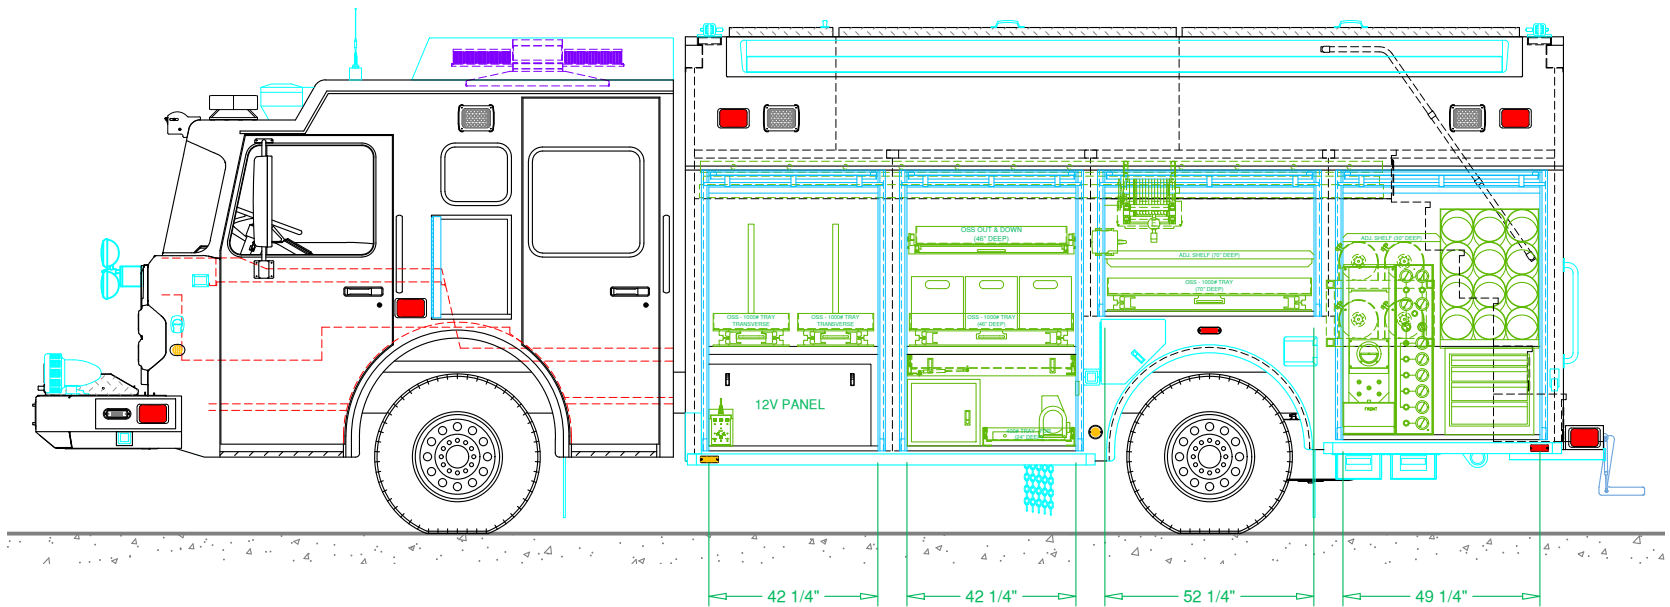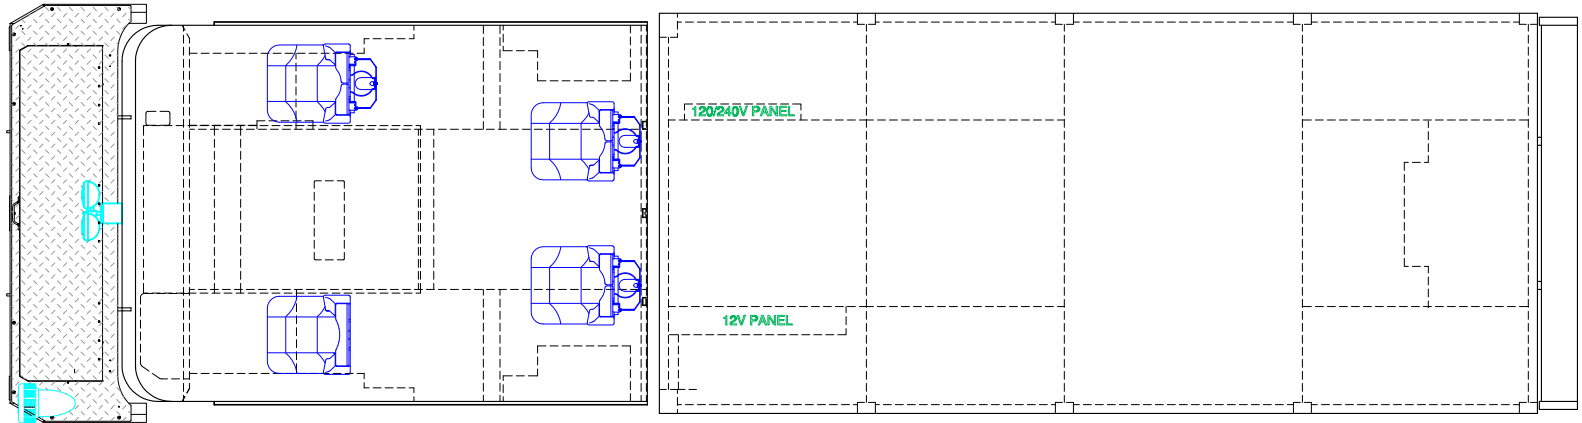

SVI FIRE & RESCUE TRUCKS
3842 REDMAN DRIVE, FORT COLLINS, CO 80524 PHONE 970-297-7100, FAX 970-297-7099

VINCENNES TOWNSHIP
FIRE DEPARTMENT