



REVISIONS			
REV	DESCRIPTION	DATE	BY



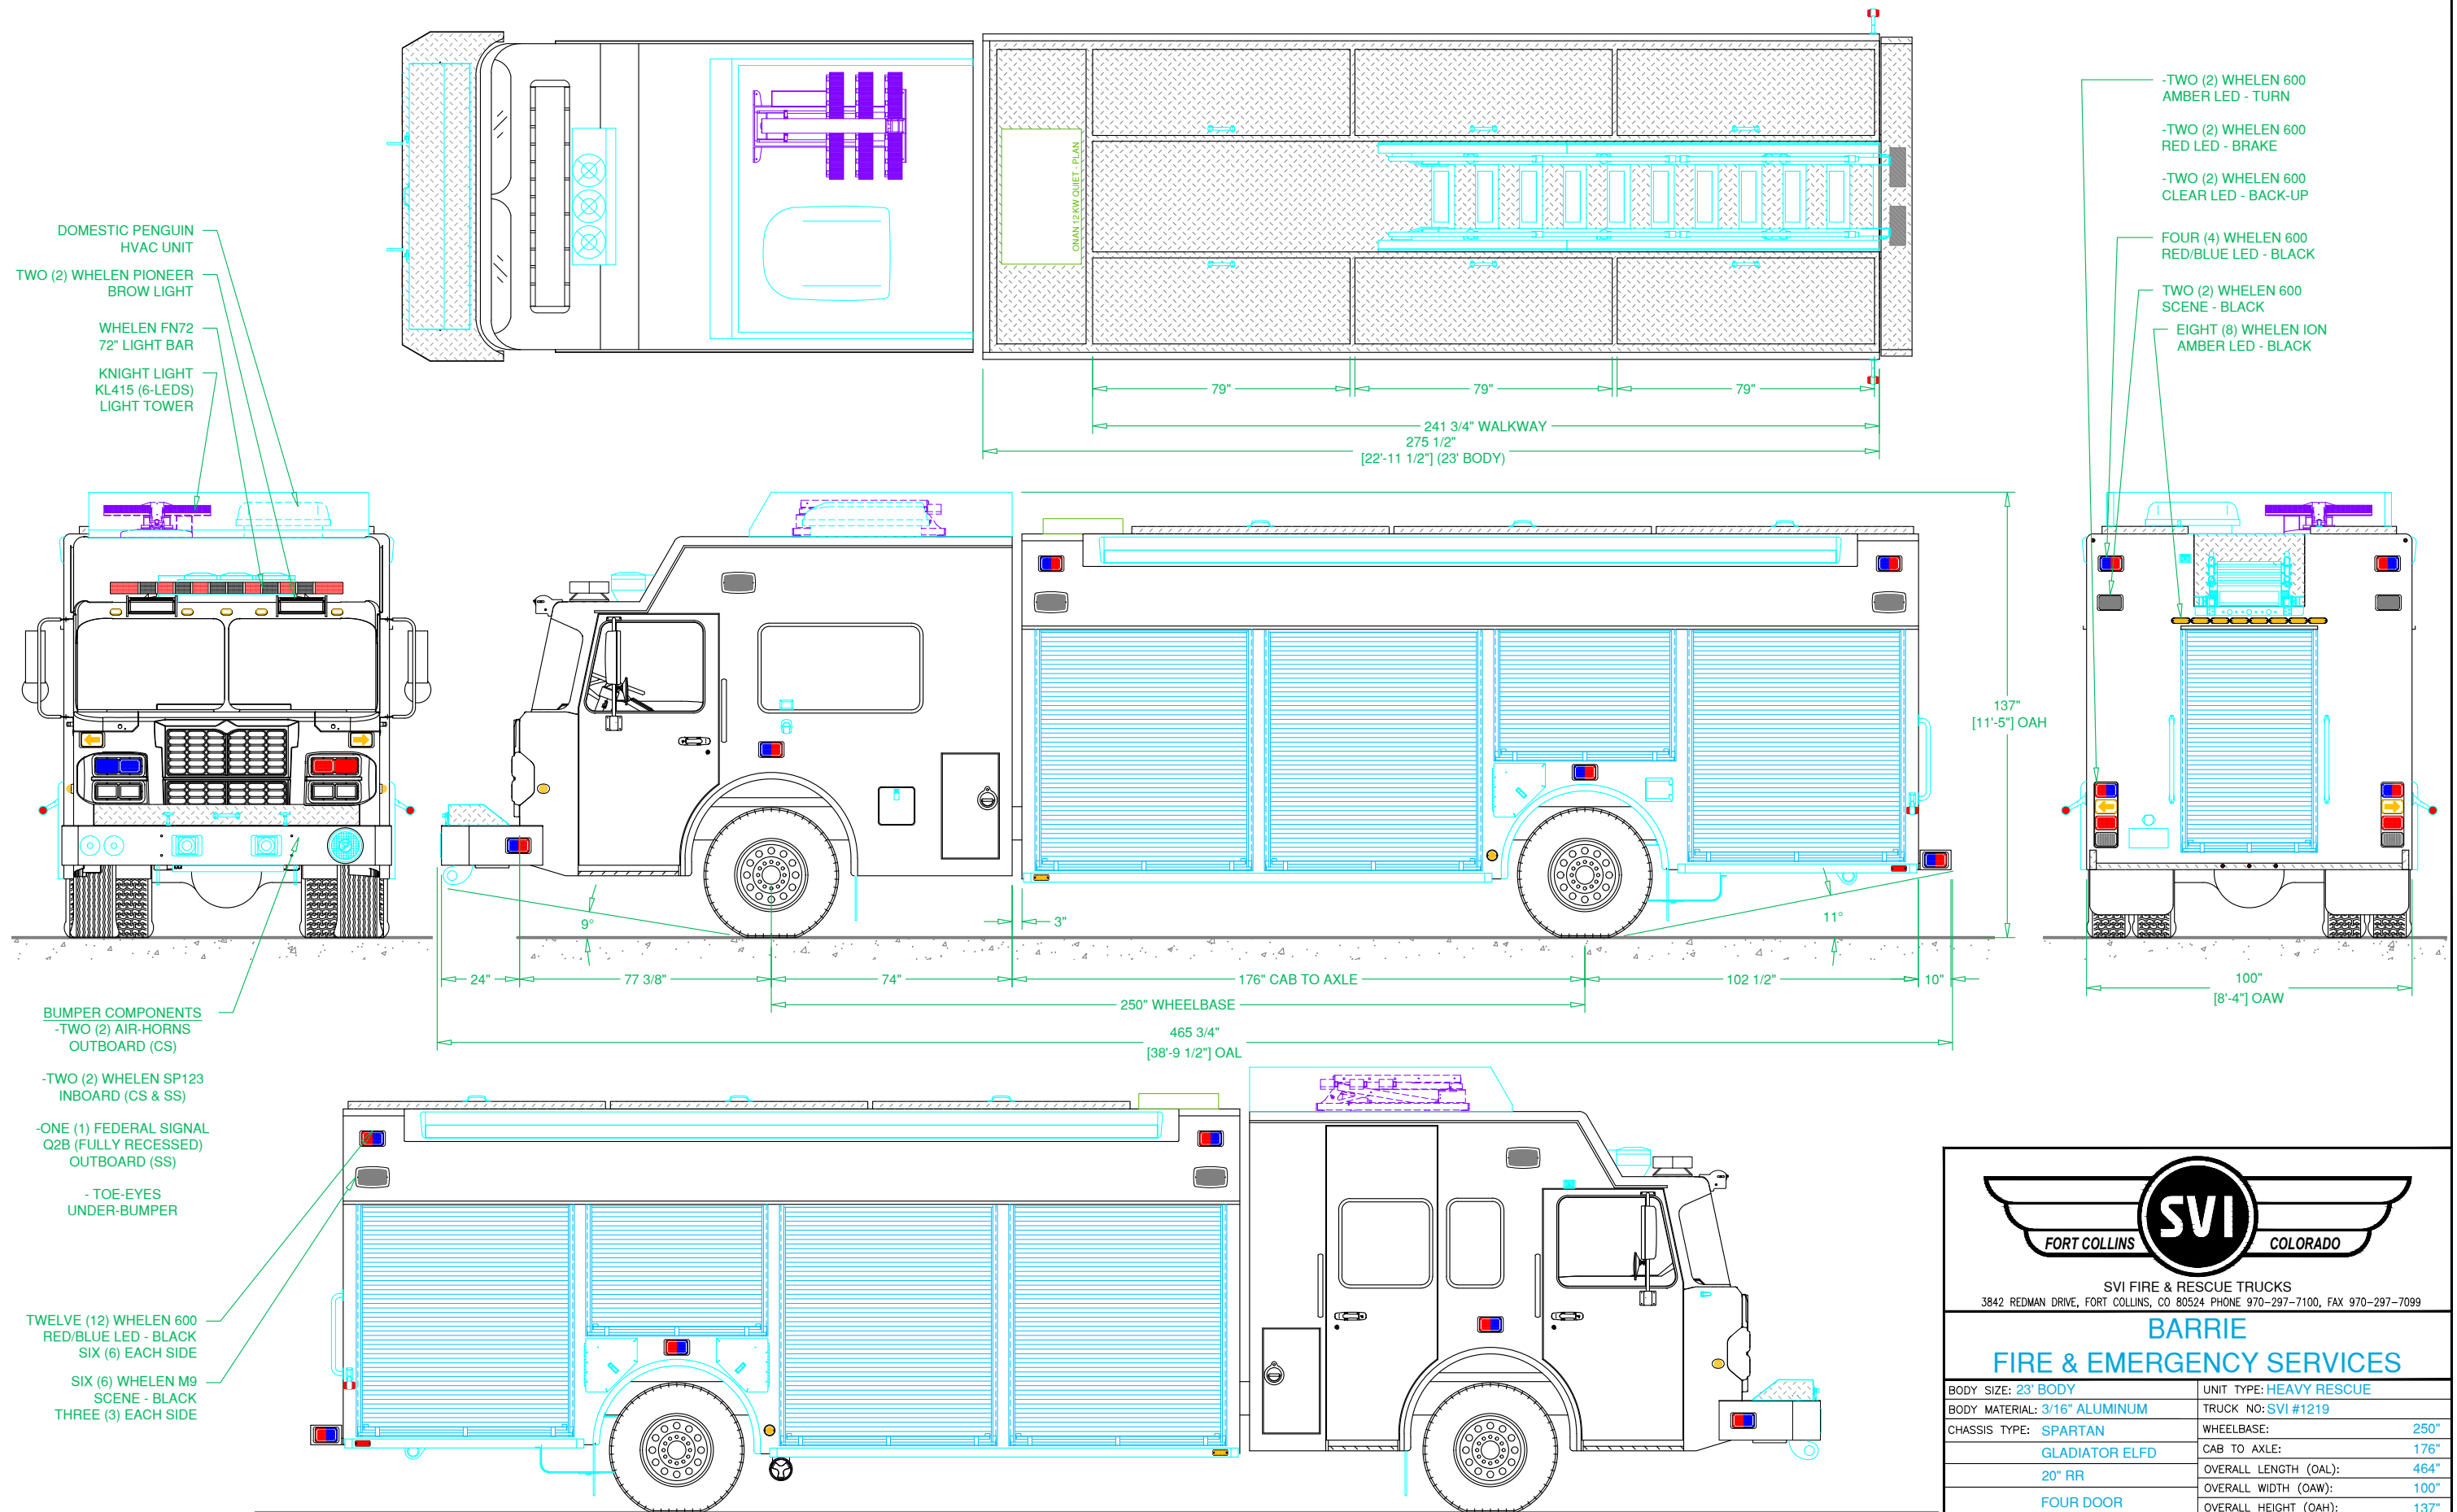

**SVI**  
FORT COLLINS COLORADO

SVI FIRE & RESCUE TRUCKS  
3842 REDMAN DRIVE, FORT COLLINS, CO 80524 PHONE 970-297-7100, FAX 970-297-7099





## BARRIE FIRE & EMERGENCY SERVICES


BODY SIZE: 23' BODY	UNIT TYPE: HEAVY RESCUE
BODY MATERIAL: 3/16" ALUMINUM	TRUCK NO: SVI #1219
CHASSIS TYPE: SPARTAN	WHEELBASE: 250"
GLADIATOR ELFD	CAB TO AXLE: 176"
20" RR	OVERALL LENGTH (OAL): 464"
FOUR DOOR	OVERALL WIDTH (OAW): 100"
	OVERALL HEIGHT (OAH): 137"

DRAWN BY: KP    DATE: February 17, 2023    SCALE: 1/4" = 1'-0"  
DRAWING NO: Barrie\_ON\_hz\_AsBuilt    SHEET 1 OF 2

REVISIONS			
REV	DESCRIPTION	DATE	BY

FRONT-CAB  
CROSS-SECTION

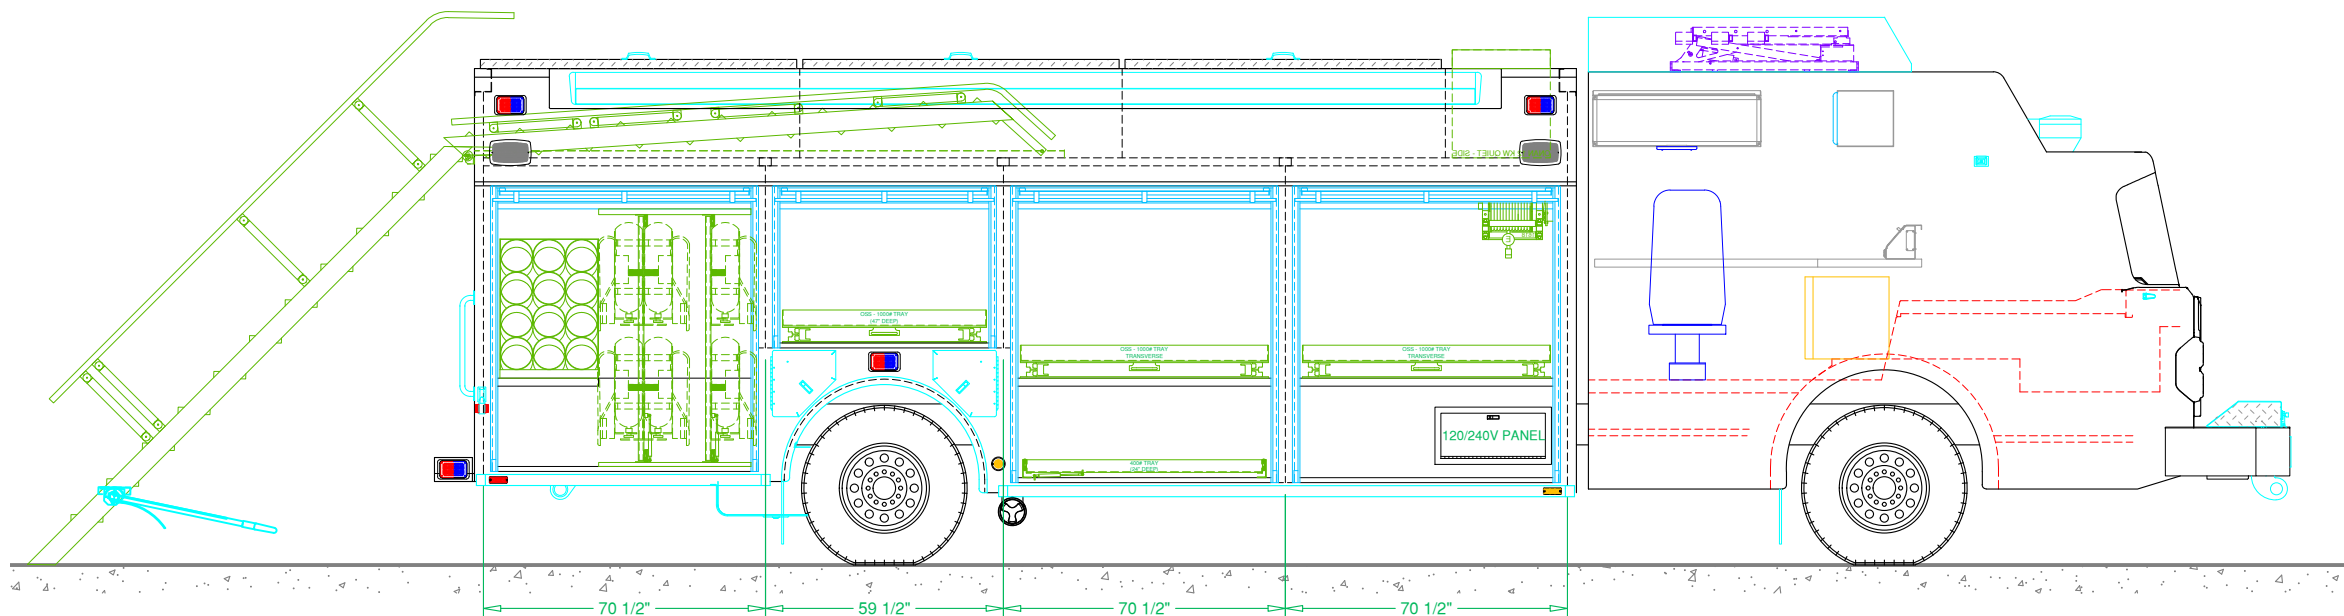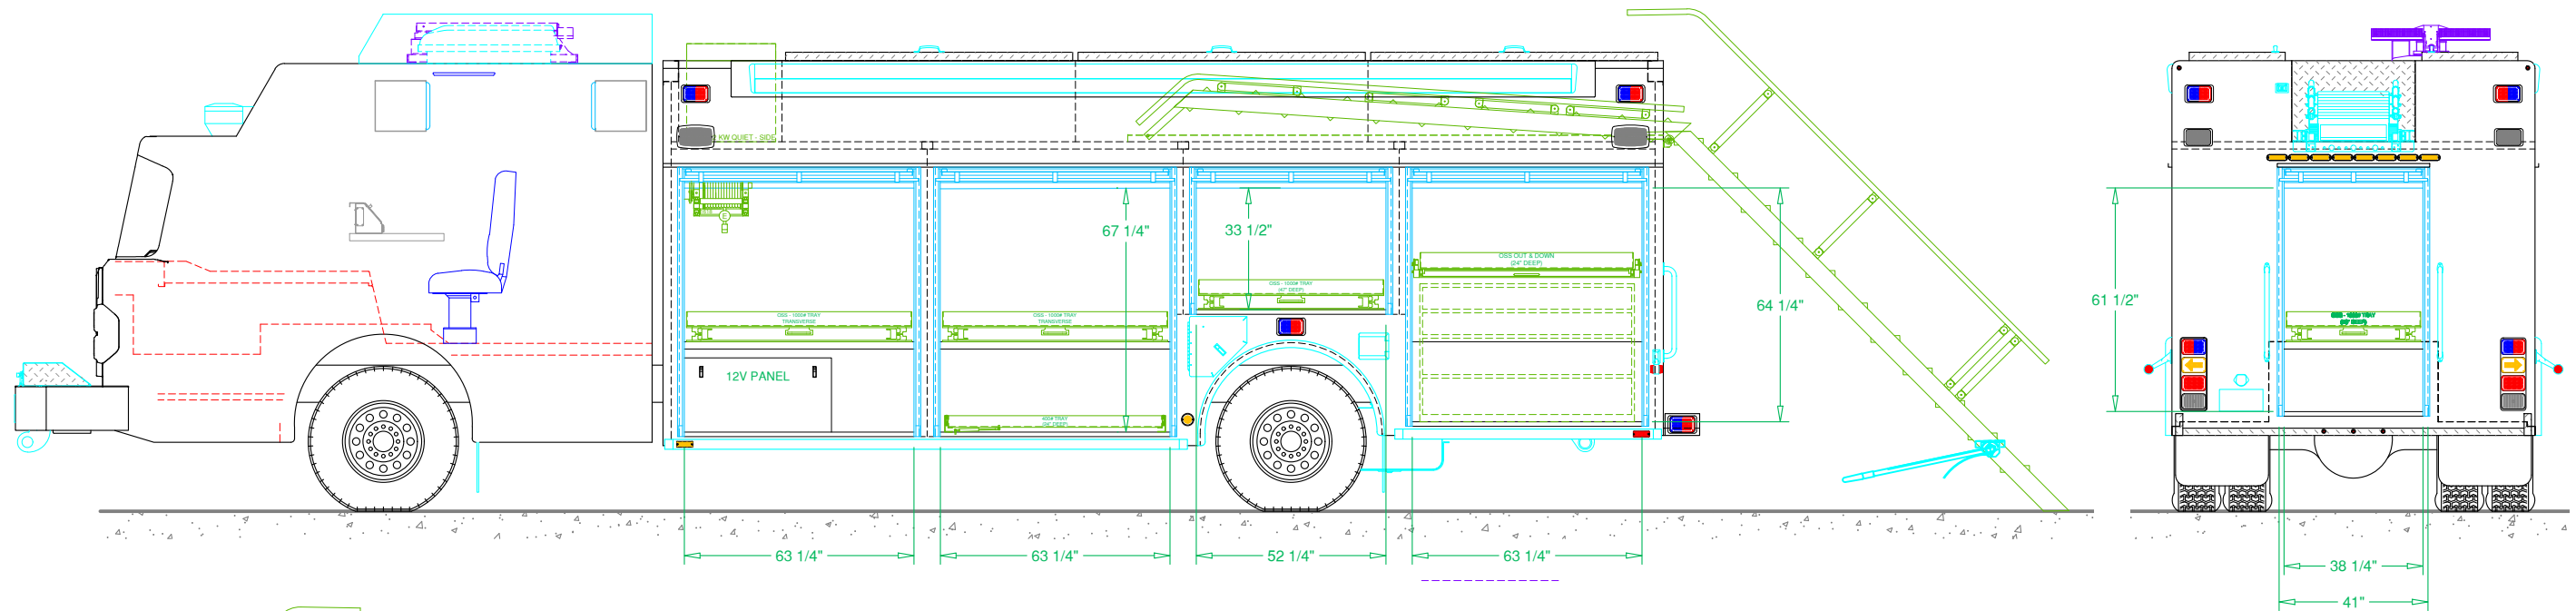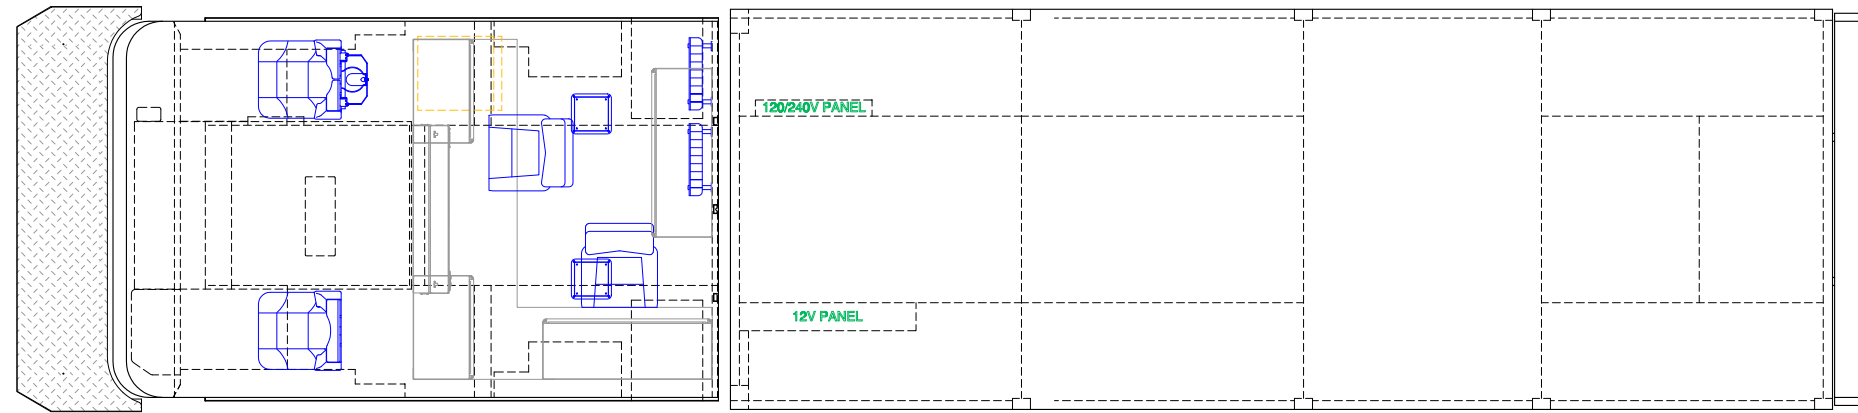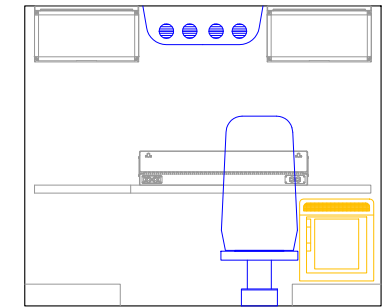



SVI FIRE & RESCUE TRUCKS  
3842 REDMAN DRIVE, FORT COLLINS, CO 80524 PHONE 970-297-7100, FAX 970-297-7099

**BARRIE**  
**FIRE & EMERGENCY SERVICES**

DRAWN BY: KP	DATE: Feb. 17, 23	SCALE: 1/4" = 1'-0"
DRAWING NO: Barrie_ON_hz_AsBuilt		SHEET 2 OF 2