

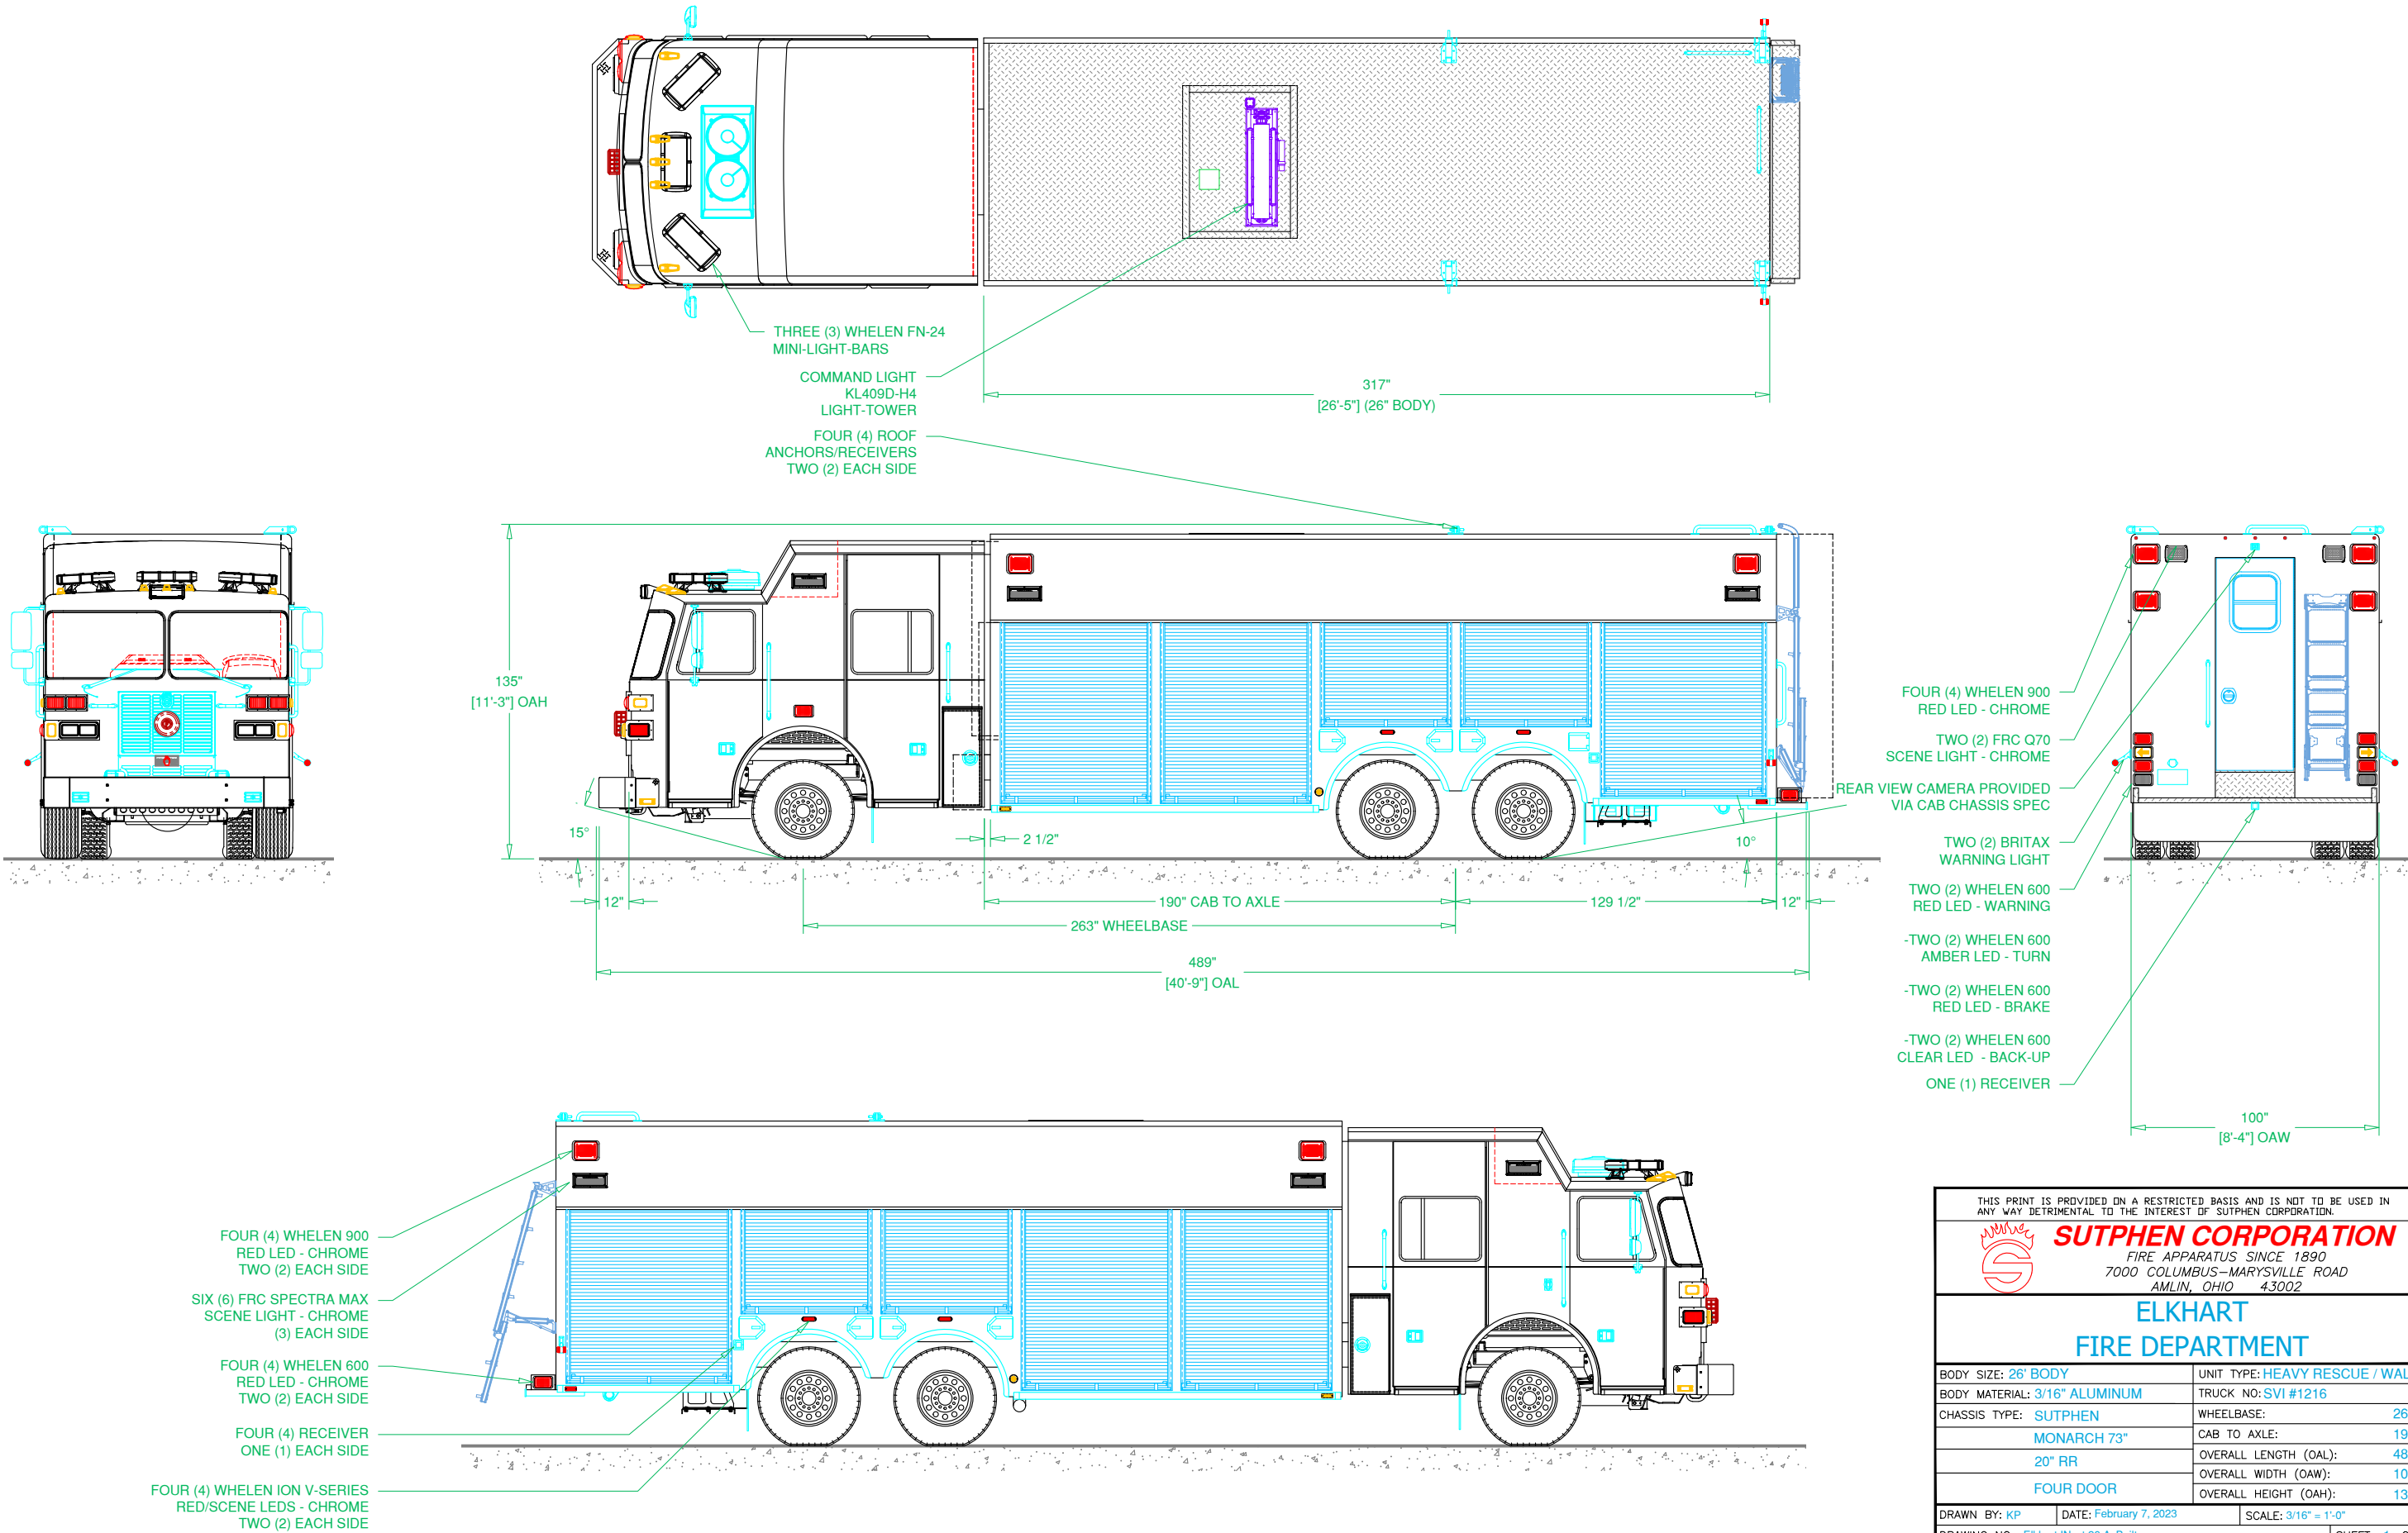
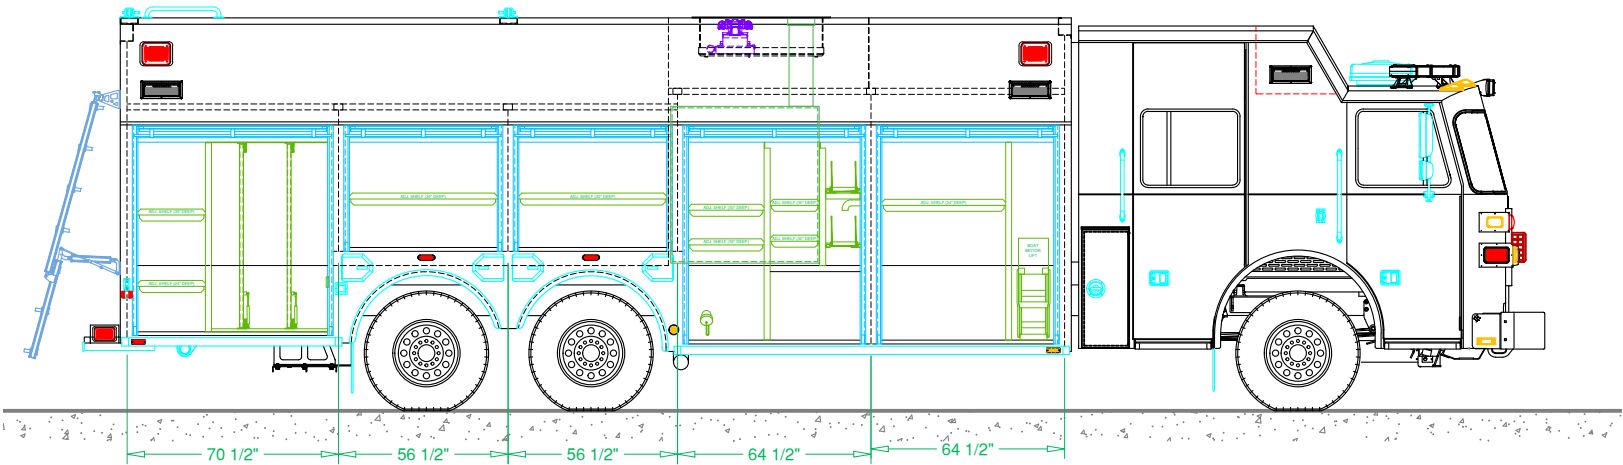
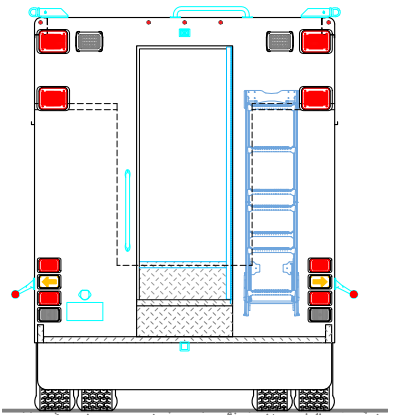


REVISIONS			
REV	DESCRIPTION	DATE	BY

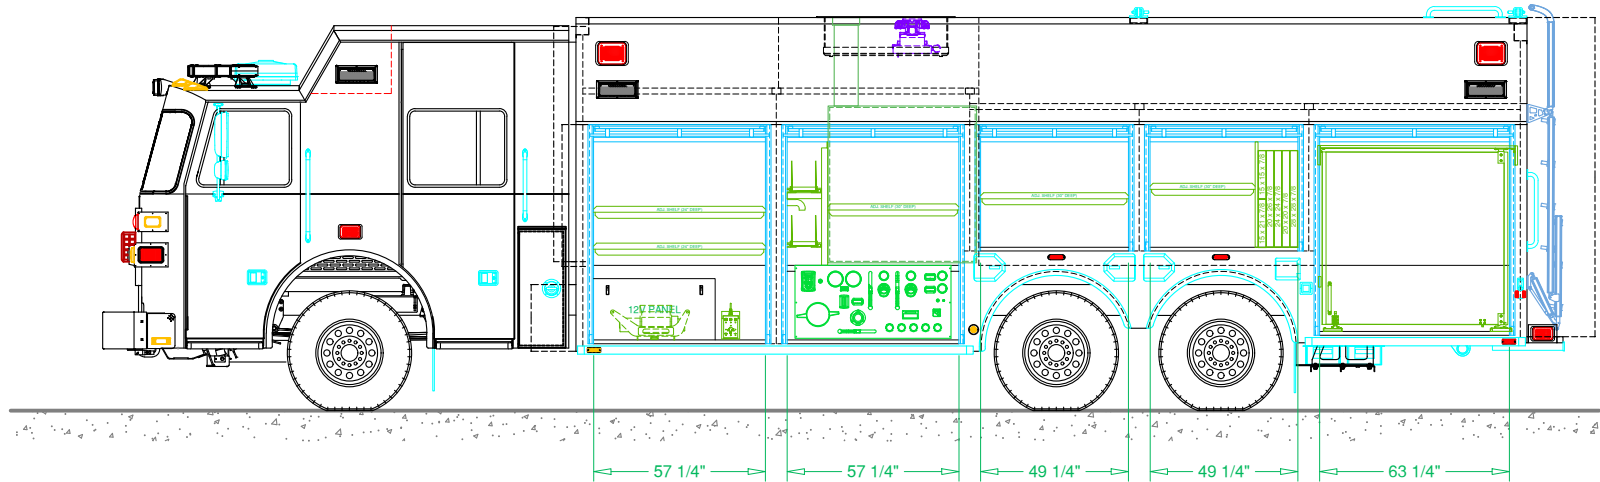

THIS PRINT IS PROVIDED ON A RESTRICTED BASIS AND IS NOT TO BE USED IN ANY WAY DETRIMENTAL TO THE INTEREST OF SUTPHEN CORPORATION.			
 SUTPHEN CORPORATION FIRE APPARATUS SINCE 1890 7000 COLUMBUS-MARYSVILLE ROAD AMLIN, OHIO 43002			
ELKHART FIRE DEPARTMENT			
BODY SIZE: 26' BODY	UNIT TYPE: HEAVY RESCUE / WALK-IN		
BODY MATERIAL: 3/16" ALUMINUM	TRUCK NO: SVI #1216		
CHASSIS TYPE: SUTPHEN	WHEELBASE:	263.00"	
MONARCH 73"	CAB TO AXLE:	190.00"	
20" RR	OVERALL LENGTH (OAL):	489.00"	
FOUR DOOR	OVERALL WIDTH (OAW):	100.00"	
	OVERALL HEIGHT (OAH):	135.00"	
DRAWN BY: KP	DATE: February 7, 2023	SCALE: 3/16" = 1'-0"	
DRAWING NO: Elkhart IN wt.26 AsBuilt			SHEET 1 OF 3

REVISIONS			
REV	DESCRIPTION	DATE	BY

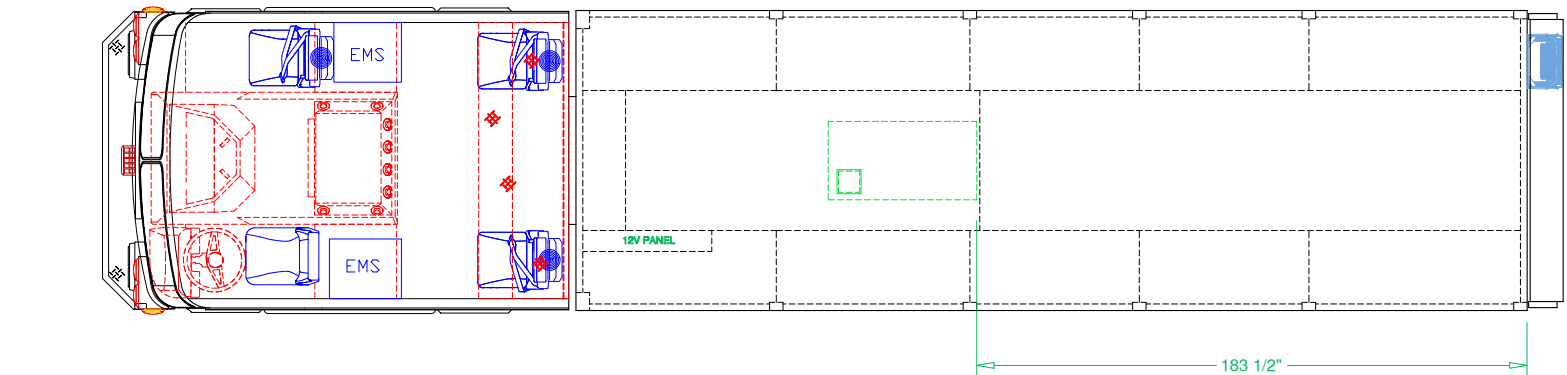

THIS PRINT IS PROVIDED ON A RESTRICTED BASIS AND IS NOT TO BE USED IN ANY WAY DETRIMENTAL TO THE INTEREST OF SUTPHEN CORPORATION.



SUTPHEN CORPORATION
FIRE APPARATUS SINCE 1890
7000 COLUMBUS-MARYSVILLE ROAD
AMLIN, OHIO 43002


ELKHART
FIRE DEPARTMENT

BODY SIZE: 26' BODY	UNIT TYPE: HEAVY RESCUE / WALK-IN
BODY MATERIAL: 3/16" ALUMINUM	TRUCK NO: SVI #1216
CHASSIS TYPE: SUTPHEN	WHEELBASE: 263.00"
MONARCH 73"	CAB TO AXLE: 190.00"
20" RR	OVERALL LENGTH (OAL): 489.00"
FOUR DOOR	OVERALL WIDTH (OAW): 100.00"
	OVERALL HEIGHT (OAH): 135.00"


DRAWN BY: KP	DATE: February 7, 2023	SCALE: 3/16" = 1'-0"
DRAWING NO: Elkhart IN wt.26 AsBuilt		SHEET 2 OF 3

REVISIONS			
REV	DESCRIPTION	DATE	BY


PLAN VIEW
CROSS-SECTION

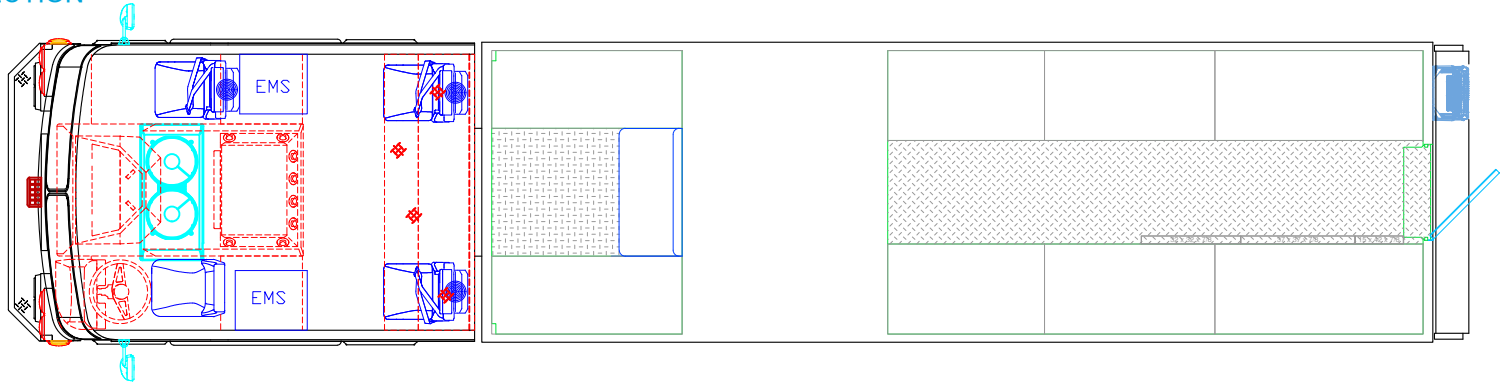

CURBSIDE INTERIOR
CROSS-SECTION

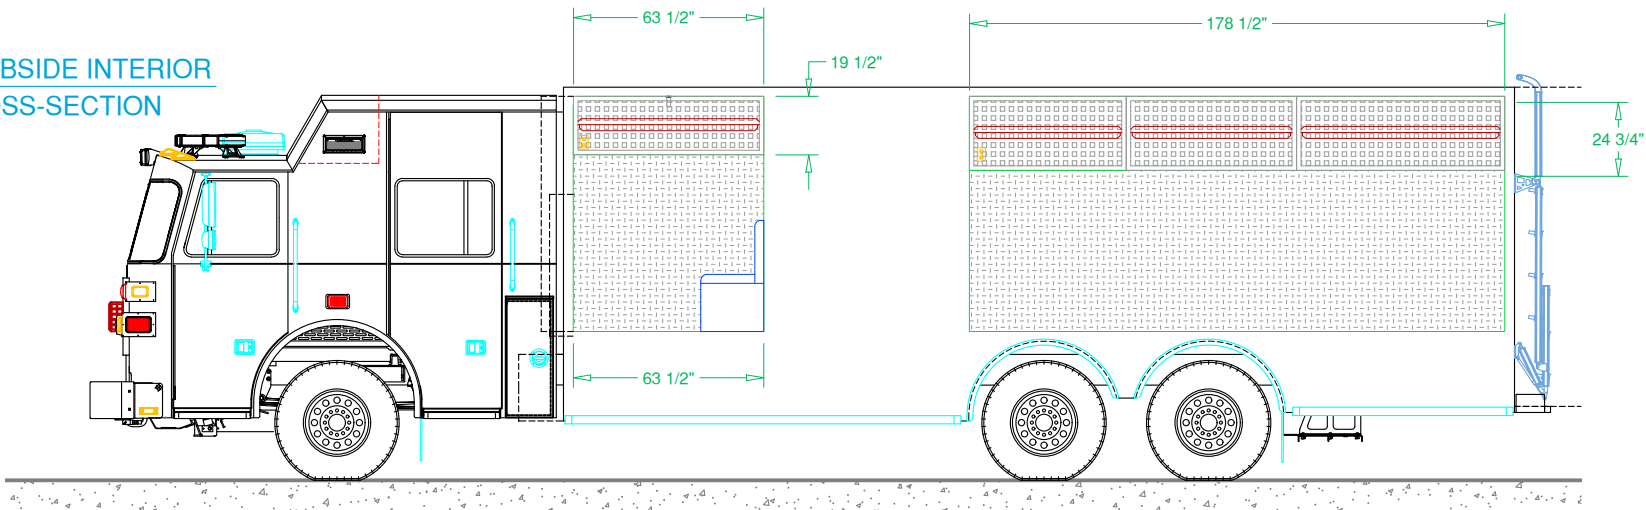

STREETSIDE INTERIOR
CROSS-SECTION

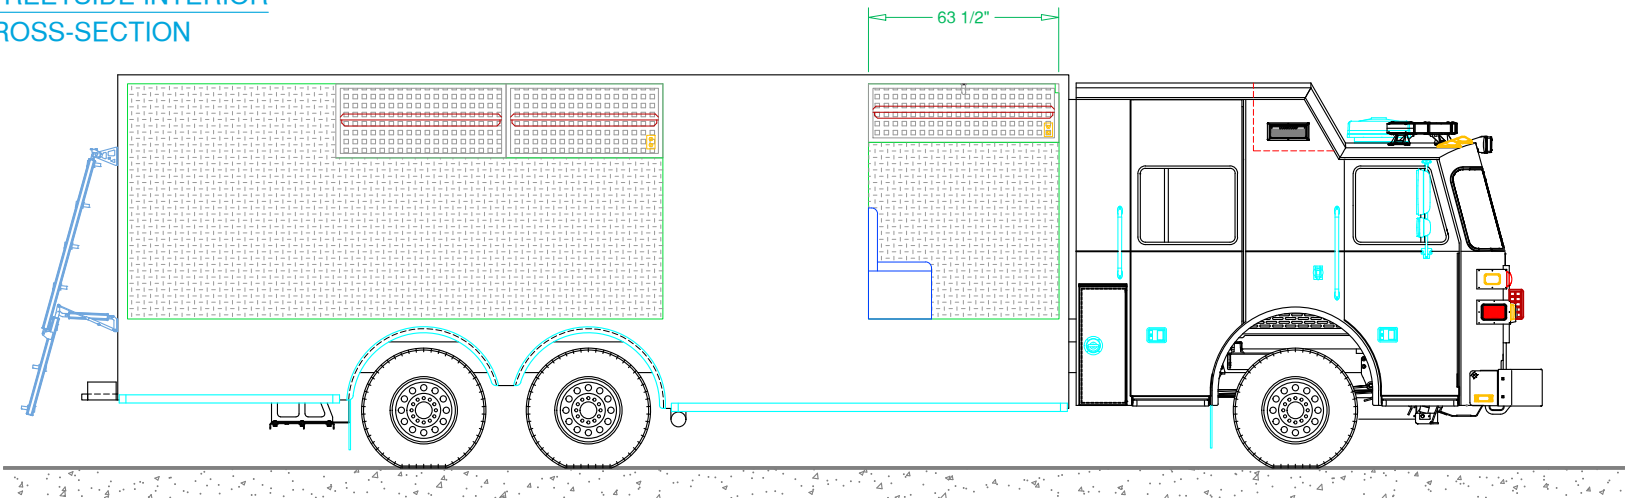

THIS PRINT IS PROVIDED ON A RESTRICTED BASIS AND IS NOT TO BE USED IN ANY WAY DETRIMENTAL TO THE INTEREST OF SUTPHEN CORPORATION.			
		SUTPHEN CORPORATION FIRE APPARATUS SINCE 1890 7000 COLUMBUS-MARYSVILLE ROAD AMLIN, OHIO 43002	
ELKHART FIRE DEPARTMENT			
BODY SIZE: 26' BODY		UNIT TYPE: HEAVY RESCUE / WALK-IN	
BODY MATERIAL: 3/16" ALUMINUM		TRUCK NO: SVI #1216	
CHASSIS TYPE: SUTPHEN		WHEELBASE: 263.00"	
MONARCH 73"		CAB TO AXLE: 190.00"	
20" RR		OVERALL LENGTH (OAL): 489.00"	
FOUR DOOR		OVERALL WIDTH (OAW): 100.00"	
		OVERALL HEIGHT (OAH): 135.00"	
DRAWN BY: KP		DATE: February 7, 2023	
		SCALE: 3/16" = 1'-0"	
DRAWING NO: Elkhart IN wt 26 AsBuilt		SHEET 3 OF 3	