



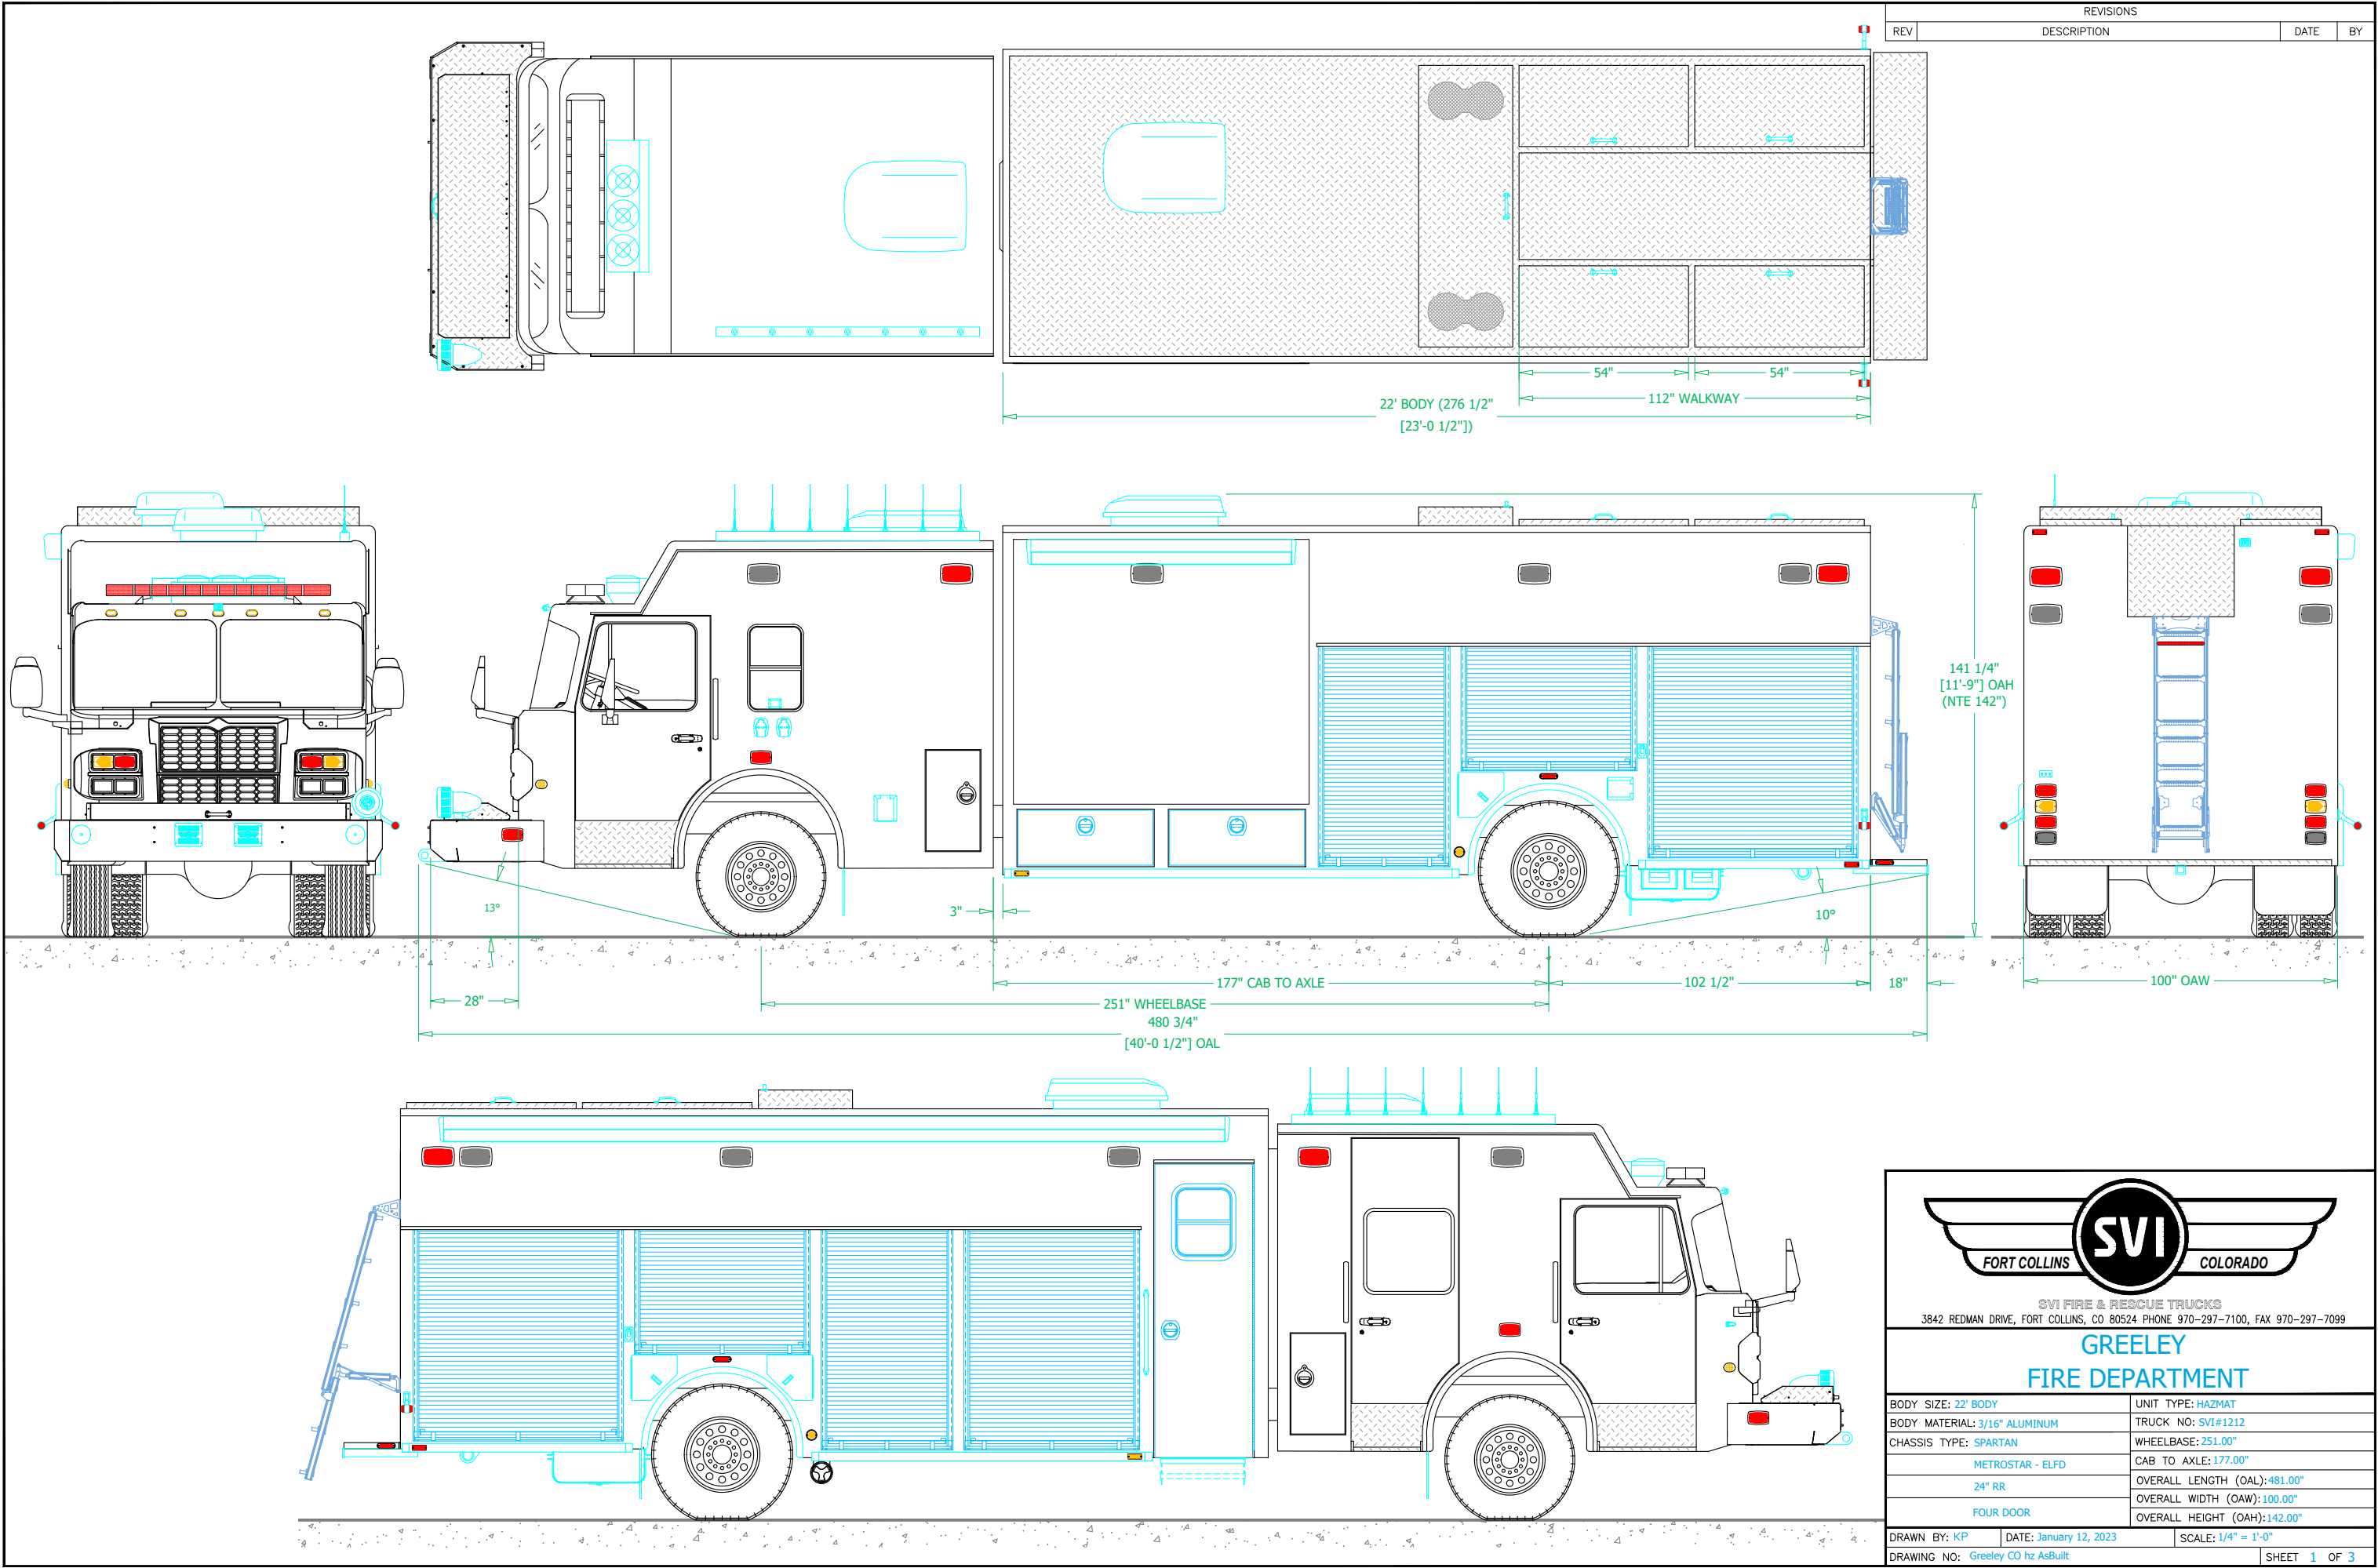

REVISIONS			
REV	DESCRIPTION	DATE	BY

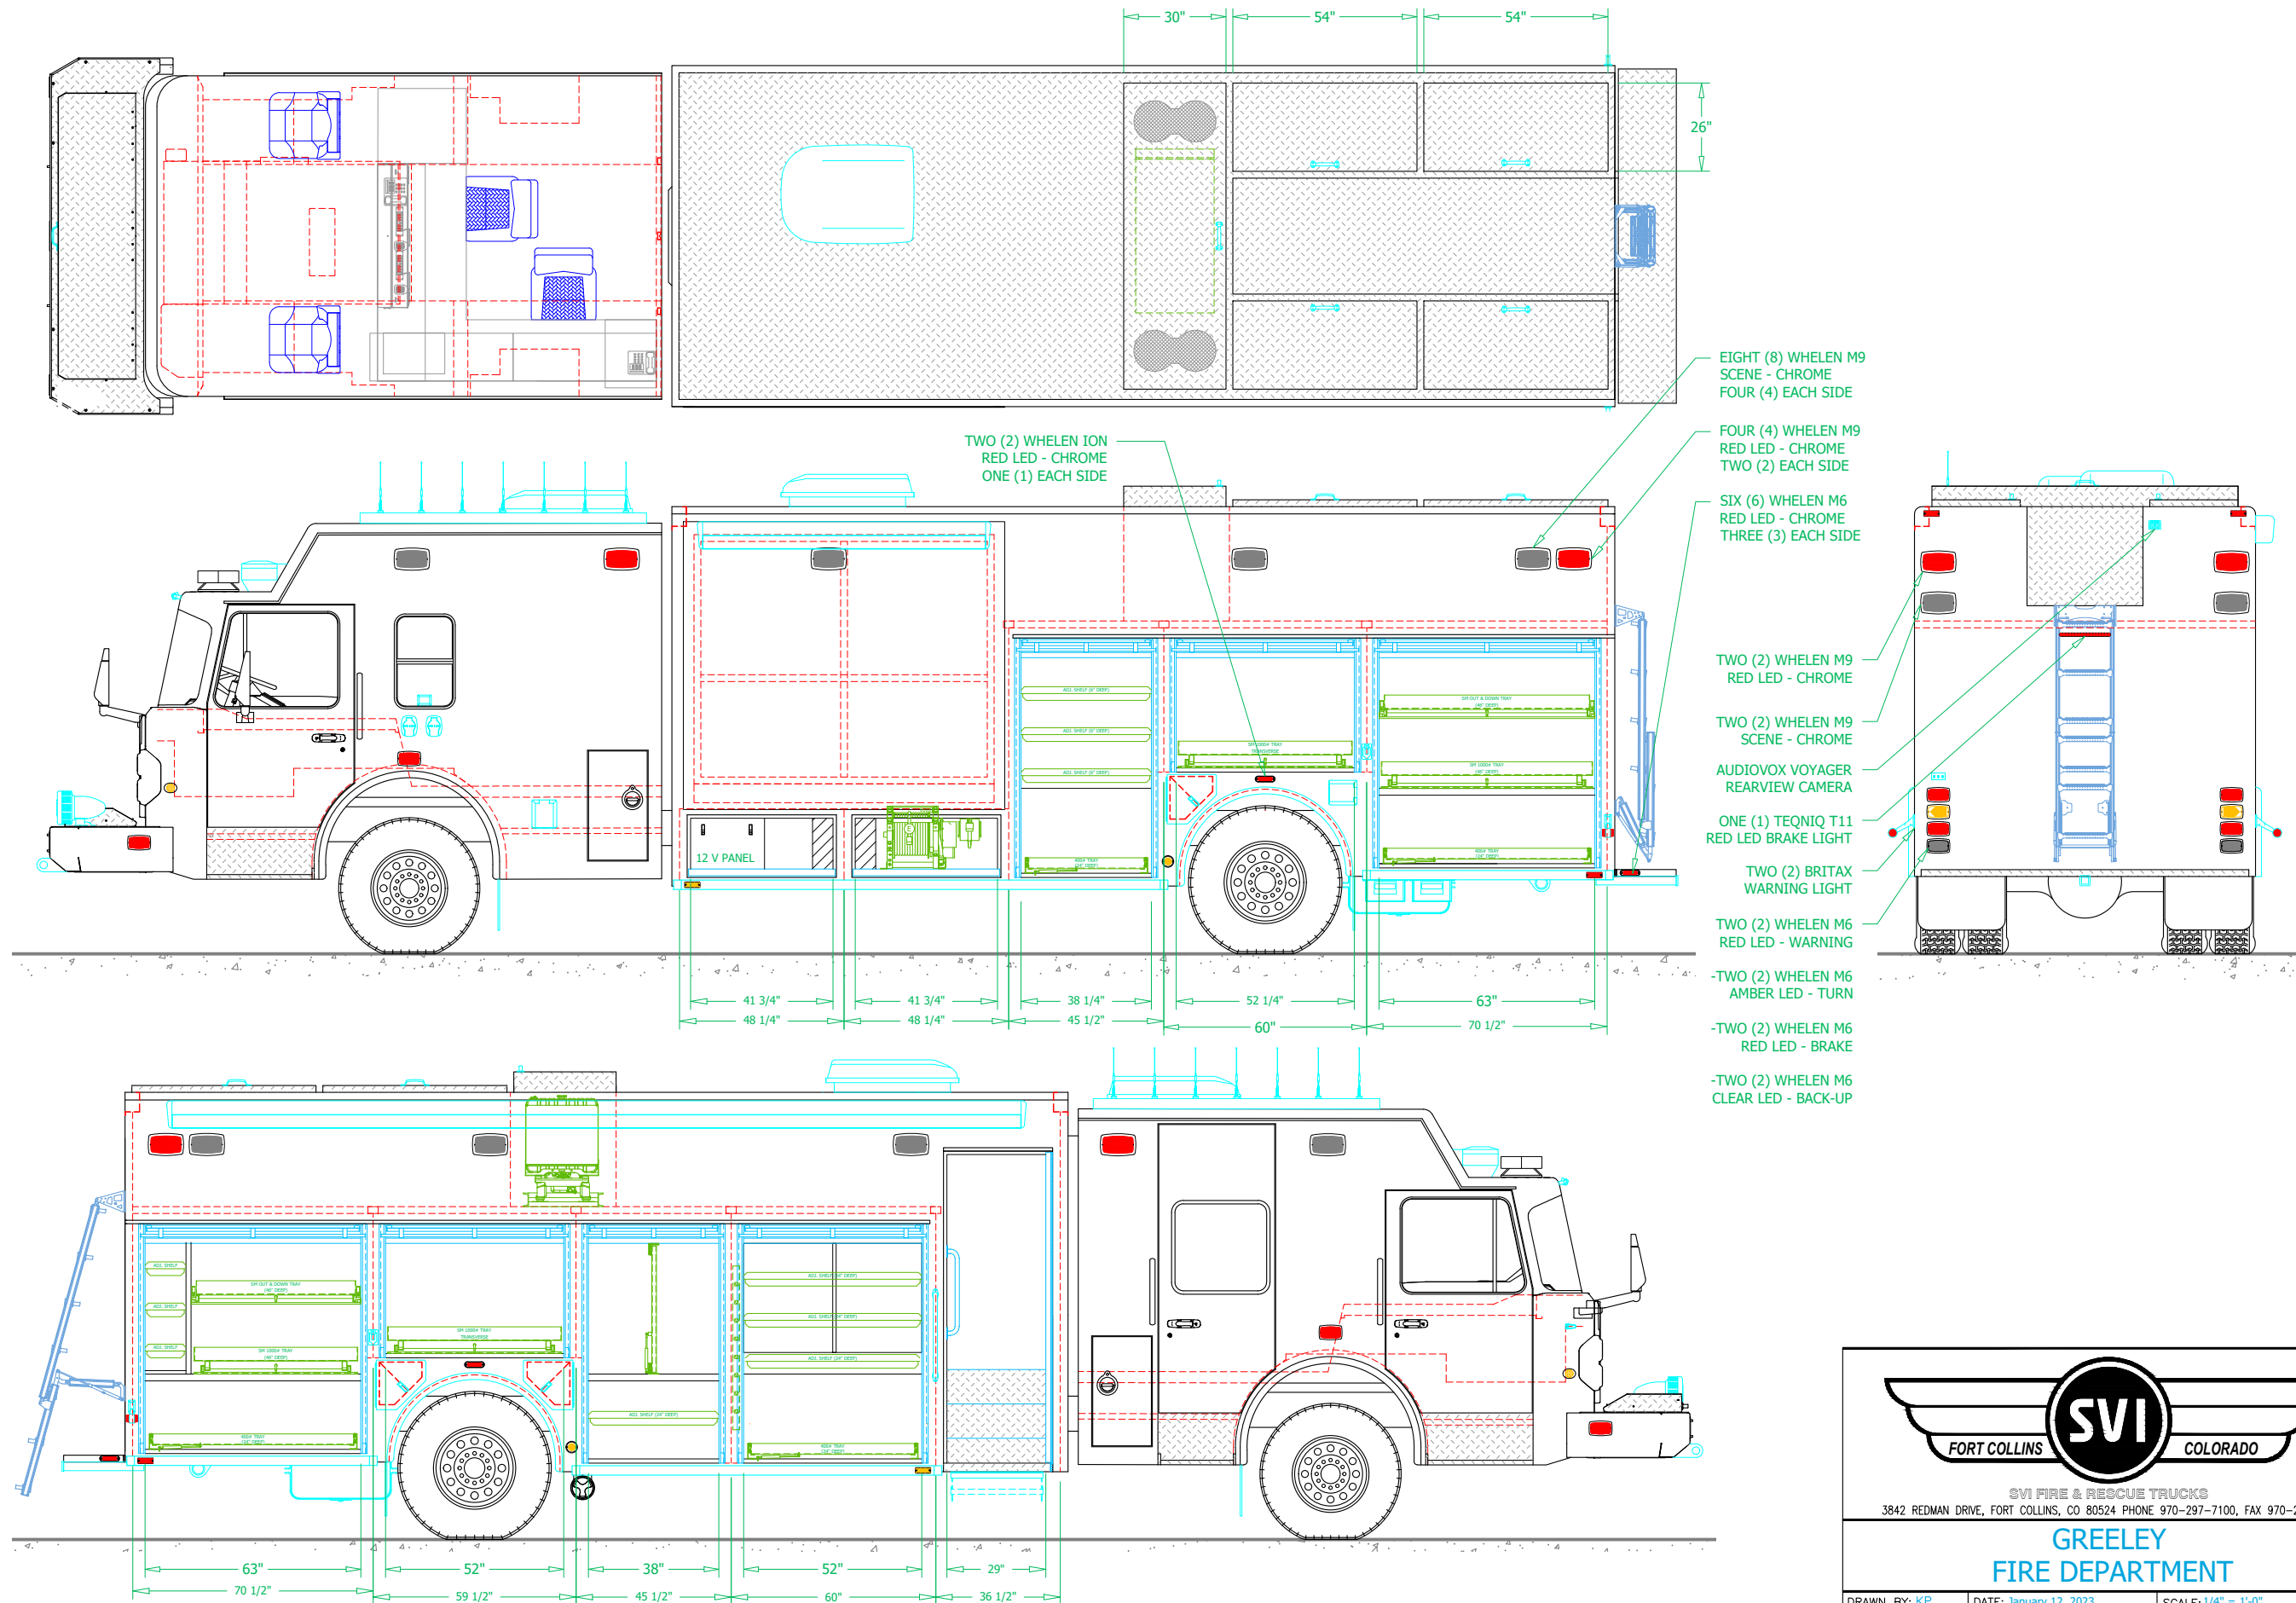



SVI FIRE & RESCUE TRUCKS
3842 REDMAN DRIVE, FORT COLLINS, CO 80524 PHONE 970-297-7100, FAX 970-297-7099

GREELEY
FIRE DEPARTMENT

DRAWN BY: KP	DATE: January 12, 2023	SCALE: 1/4" = 1'-0"
DRAWING NO: Greeley CO hz AsBuilt	SHEET 2 OF 3	



TOP VIEW INTERIOR
CROSS-SECTION

CROSS-SECTION
CAB - FOWARD FACING

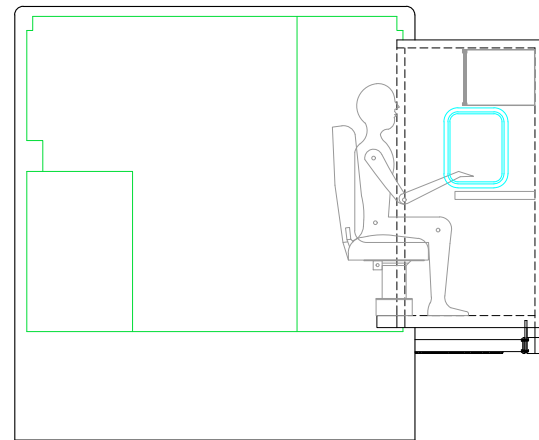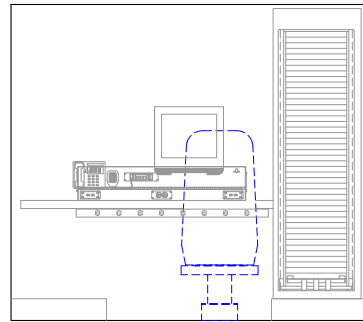


CROSS-SECTION
WALK-IN - REAR FACING

CURBSIDE INTERIOR
CROSS-SECTION

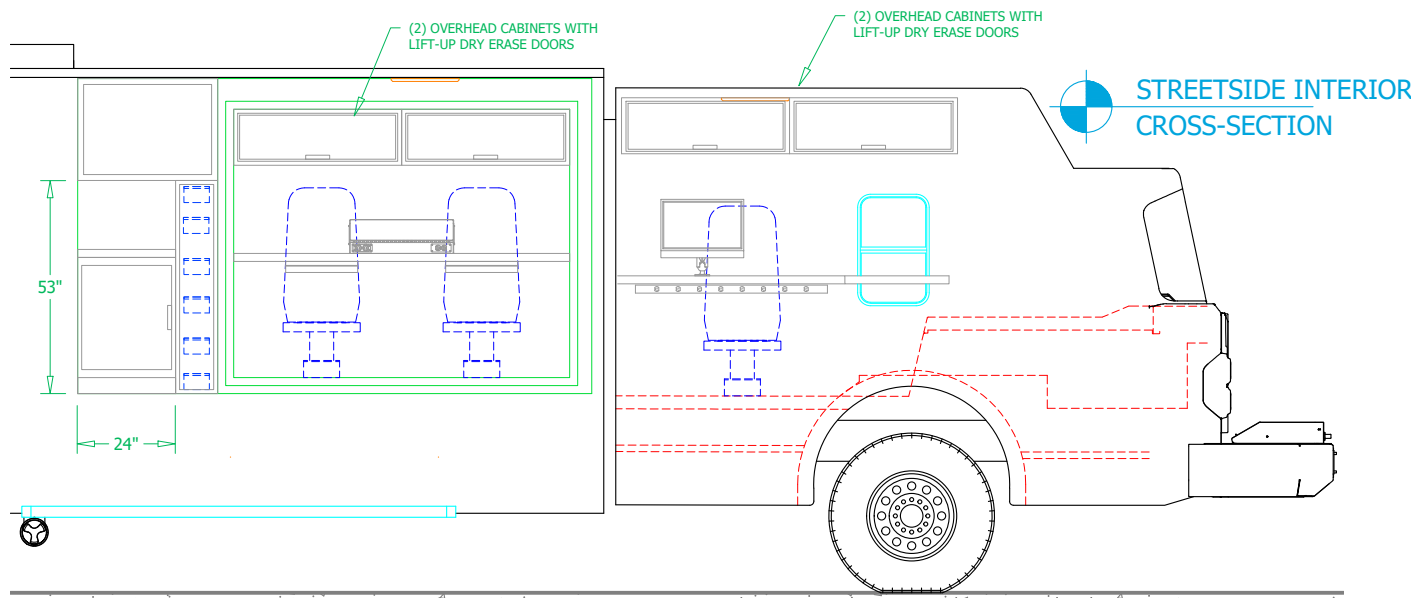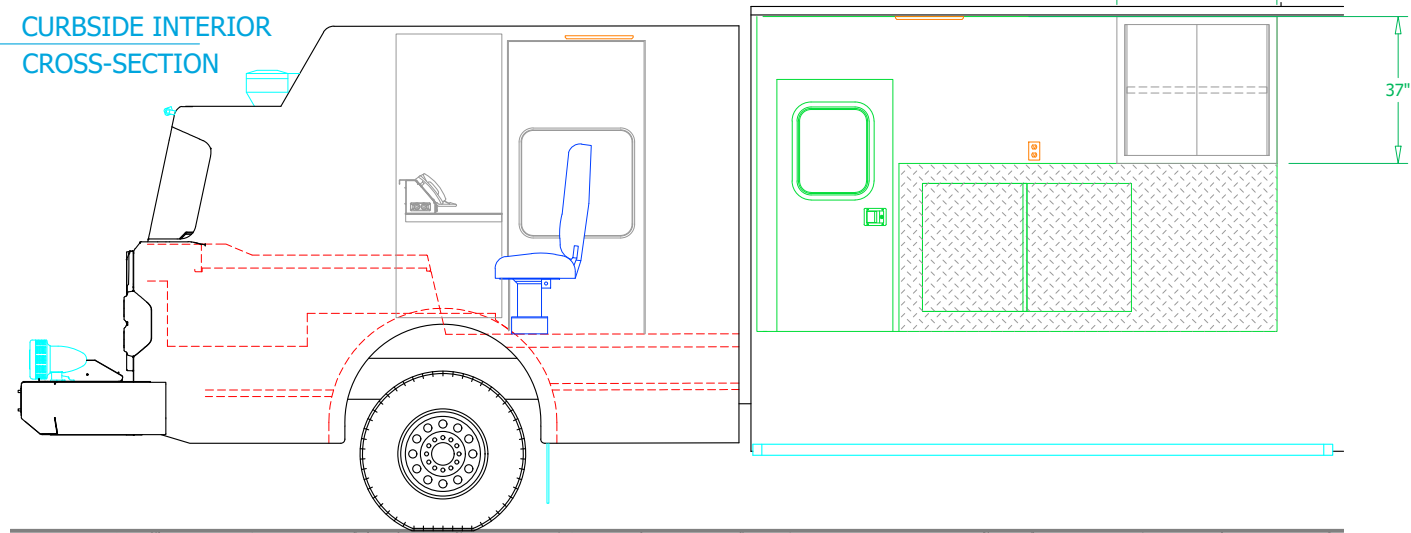


STREETSIDE INTERIOR
CROSS-SECTION

CROSS-SECTION
CAB - REAR FACING

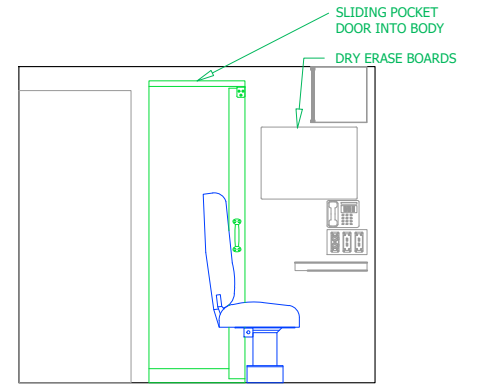

CROSS-SECTION
WALK-IN - FOWARD FACING

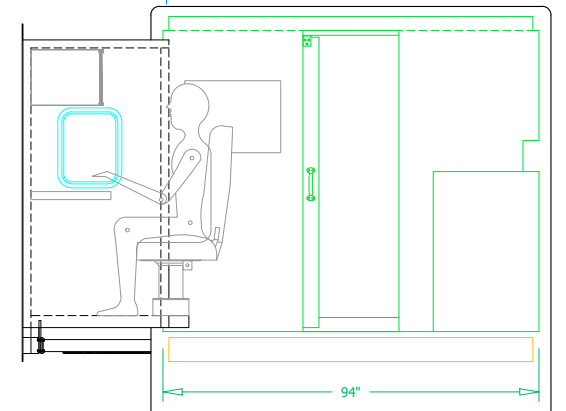

REVISIONS			
REV	DESCRIPTION	DATE	BY



SVI FIRE & RESCUE TRUCKS
3842 REDMAN DRIVE, FORT COLLINS, CO 80524 PHONE 970-297-7100, FAX 970-297-7099

GREELEY
FIRE DEPARTMENT

DRAWN BY: KP	DATE: January 12, 2023	SCALE: 3/16" = 1'-0"
DRAWING NO: Greeley CO hz AsBuilt	SHEET 3 OF 3	